

USDA-FOREST SERVICE

Index File No. X-5

CORNER RECORD (SEARCH)


(Ref. FSM 7151.4)

Tract or Survey No. _____ Cor. No. _____

T 65 R. 34E R.D. NORTH FORK JOHN DAY County UMATILLA

Merid. WILLAMETTE N.F. UMATILLA State OREGON

CORNER DIAGRAM

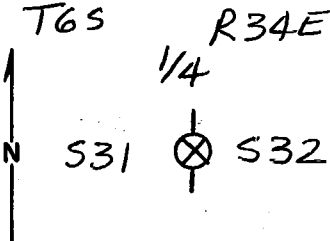

DESCRIBE CORNER MONUMENT FOUND

NONE - POST IS GONE

DESCRIBE BEARING TREES OR OTHER OFFICIAL ACCESSORIES FOUND

ORIG. 10" FIR IS NOW A 12" SNAG. I OPEN HEALED BLAZE & FIND SCRIBES. BEARS N45°W, 11.2!
ORIG. 10" LARCH IS DOWN & BADLY DECAYED. SCRIBES VISIBLE ON DECAYED WOOD.
PUT BT SIGNS ON SNAG & LARCH LOG.

PHOTO IDENTIFICATION DATA

Photo No. _____
Filed At. _____
Object Ident. _____
Ident. By _____
Signature

DESCRIBE CORNER LOCATION RELATIVE TO NEAR-BY FEATURES, ALSO HOW TO REACH CORNER

PUT LOCATION SIGN ON A 20" FIR S85°E, 12 ft. FROM CORNER & A LOCATION SIGN ON A 16" LARCH 10 FT NORTH OF "COOK'S" TRAIL AND 400 FT. SOUTH OF THE CORNER.

PLANE COORDINATE POSITION DATA

State _____ Zone _____
X _____
Y _____
Estab. By _____
Agency

Signature

Title

Division

Headquarters

Date

FS-7100-52 (3/88)

Dennis L. Heylord

PLS 1636

SO

7/28/1994

CORNER RECORD (PERPETUATION)

MONUMENT: DESCRIBE NEW MONUMENT SET, OR WORK DONE TO PRESERVE EXISTING MONUMENT

ACCESSORIES: DESCRIBE NEW BT'S WITNESS OBJECTS ETC. ESTABLISHED, OR WORK DONE TO PRESERVE EXISTING EVIDENCE

9

10

Work Done By _____ Title _____ Date _____ State Registration No. or Agency _____

Certified Cor. Record Prepared? Yes No Filed At: _____ Date _____

11

REMARKS

12

Index File No. T. R. M.S. Co. Tract or Surv. No. Cor. 13