

Index  
File No. C-9


**CORNER RECORD (SEARCH)**  
(Ref. FSM 7151.4)

Tract or Survey No. \_\_\_\_\_  
Cor. No. C-9

T 7S R. 31E R.D. Dalet County Grant

Merid. Willamette N.F. Umatilla State Oregon

**CORNER DIAGRAM**

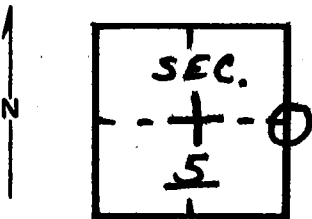

**DESCRIBE CORNER MONUMENT FOUND**

Material: Native stake                      Size: 2" diam.  
Height above ground: 3'                      Condition: Fair  
Markings: Squared top

**DESCRIBE BEARING TREES OR OTHER OFFICIAL ACCESSORIES FOUND**

No BTs originally established. Georgia-Pacific location poster on 16" Doug. fir S33°E, 26 ft. Also another on a 16" Doug. fir west, 26 feet. Stake is approx. 100' south of ravine. No evidence of original mound. Ravine has had considerable scour. If 1/4 corner fell in ravine, as original calls indicate, there is little hope of any evidence remaining.

**PHOTO IDENTIFICATION DATA**

Photo No. \_\_\_\_\_  
Filed At. \_\_\_\_\_  
Object Ident. \_\_\_\_\_  
Ident. By \_\_\_\_\_  
*Signature*

**DESCRIBE CORNER LOCATION RELATIVE TO NEAR-BY FEATURES, ALSO HOW TO REACH CORNER**

**PLANE COORDINATE POSITION DATA**

State \_\_\_\_\_ Zone \_\_\_\_\_  
X \_\_\_\_\_  
Y \_\_\_\_\_  
Estab. By \_\_\_\_\_  
*Agency*

T. Hollamon, Eng. Tech.

3/22/78

Signature \_\_\_\_\_ Title \_\_\_\_\_ Division \_\_\_\_\_ Headquarters \_\_\_\_\_ Date \_\_\_\_\_

7100-52-(3/68)

## CORNER RECORD (PERPETUATION)

---

 MONUMENT: DESCRIBE NEW MONUMENT SET, OR WORK DONE TO PRESERVE EXISTING MONUMENT
 

---

9

---

 ACCESSORIES : DESCRIBE NEW BT'S WITNESS OBJECTS ETC. ESTABLISHED, OR WORK DONE TO PRESERVE EXISTING EVIDENCE
 

---

10

---

 Work Done By \_\_\_\_\_ Title \_\_\_\_\_ Date \_\_\_\_\_ State Registration No. or Agency \_\_\_\_\_
 

---



---

 Certified Cor. Record Prepared ? Yes No Filed At: \_\_\_\_\_ Date \_\_\_\_\_
 

---

REMARKS

12

---

 Index File No. T. R. M. Tract or Surv. No. Cor.
 

---

 13