

USDA-FOREST SERVICE

Index File No. ~~1~~ Z-25

CORNER RECORD (SEARCH)

(Ref. FSM 7151.4)

Tract or

Survey No. \_\_\_\_\_

Cor.

No. \_\_\_\_\_

T ~~675~~ R.323E

R.D. NORTH FORK JOHN DAY County

GRANT-UMATILLA LINE


Merid. WILLAMETTE

N.F. UMATILLA

State

OREGON

CORNER DIAGRAM

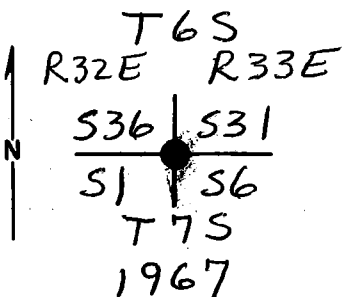

DESCRIBE CORNER MONUMENT FOUND

BLM BRASS CAPPED IRON PIPE. CAP IS MARKED W/ BLM LOGO & AS IN DIAGRAM.

DESCRIBE BEARING TREES OR OTHER OFFICIAL ACCESSORIES FOUND

21" POND, PINE W/ DOUBLE HEATED BLAZES. BEARS N76°E, 20' FEET.  
40' HIGH BADLY BURNT SNAG W/ CHARRED SCRIBES VISIBLE BEARS S40°W, 193 FEET.

PHOTO IDENTIFICATION DATA

Photo No. \_\_\_\_\_  
Filed At. \_\_\_\_\_  
Object Ident. \_\_\_\_\_  
Ident. By \_\_\_\_\_

21" W. LARCH W/ VISIBLE SCRIBES ON PREV. OPENED UPPER BLAZE, HEATED LOWER BLAZE. BRG N8°W, 233 FT

DESCRIBE CORNER LOCATION RELATIVE TO NEAR-BY FEATURES, ALSO HOW TO REACH CORNER

Signature \_\_\_\_\_

PLANE COORDINATE POSITION DATA

State \_\_\_\_\_ Zone \_\_\_\_\_  
X \_\_\_\_\_  
Y \_\_\_\_\_  
Estab. By \_\_\_\_\_  
Agency \_\_\_\_\_

Signature

Title

Division

Headquarters

Date

FS-7100-52 (3/68)

Dennis L. Hayford PLS 1636

March 7, 1997

CORNER RECORD (PERPETUATION)

MONUMENT: DESCRIBE NEW MONUMENT SET, OR WORK DONE TO PRESERVE EXISTING MONUMENT

None

ACCESSORIES: DESCRIBE NEW BT'S WITNESS OBJECTS ETC. ESTABLISHED, OR WORK DONE TO PRESERVE EXISTING EVIDENCE

11" DOUG-FIR SCRIBED "T 7S R 33E S 6 BT" BEARS S10°45'E, 72<sup>2</sup> FT.  
21" DOUG-FIR SCRIBED "T 7S R 32E S 1 BT" BEARS S50°W, 77<sup>2</sup> FT.

Work Done By D. GAYLORD Title FOREST L.S. Date 3/7/97 State Registration No. 1636  
or Agency

Certified Cor. Record Prepared?  Yes  No Filed At: GRANT & UMATILLA COUNTY Date MARCH 1997

REMARKS

Index File No. ~~A~~ Z-25 TOS T. 65 R. 32E M. WILL Tract or Surv. No. Cor. 11

USDA-FOREST SERVICE

Index

File No. Z-25

T6S

R32E

Merid. Willamette

CORNER RECORD (SEARCH)

Ref. FSM 7151.4

North Fork John Day

Umatilla

Tract or

Survey No

County Umatilla

State Oregon

Cor.

No.

S 36/31/6/1

x

Corner Diagram

T6S

R32E | R33E

S36 | S31

x

S1156

T7S

1967

1 Describe corner monument found

1 Standard BLM brass cap stamped as shown in the corner diagram.

1

1

1

1

1

x

Photo Identification Data

Photo No. 1687-76

filed at Pendleton, OR

Object Ident. Bearing Trees

Ident. by David L. Haddock

Signature

1 Describe bearing trees or other official accessories found

1 A 21" Western Larch bears N8°W, 22.4'.

1 A 20" Ponderosa Pine bears N76°E, 20.5'.

1 A 26" Ponderosa Pine bears S37°W, 17.8'.

1 A 15" Douglas Fir bears S15°1/2E, 50.2'.

1 A 7" Douglas Fir, not of record and scribed T6S R32E S6 BT is dead and down. The stump hole bears S19°E, 33.5'.

x

Plane Coordinate Position Data

State Zone

X

Y

Estab. by

Agency

1 Describe corner location relative to near-by features, also how to reach corner  
1 From the junction of roads 55 and 5507, follow road 5507 3.7 miles east to road  
1 018. Follow road 018 south 100', then west 0.3 miles keeping right to where the  
1 corner is located about 30' above the road in a sharp curve to the left.

x

Signature

David L. Haddock

Title

Land Surveyor

Division

Headquarters

Pendleton, OR

Date

July 1988

7100.52

CORNER RECORD (PERPETUATION)

X \_\_\_\_\_ X  
 Monument: Describe new monument set, or work done to preserve existing monument

Set steel guard post 5' south of the monument and attached Forest Service Land Survey Monument sign.

X \_\_\_\_\_ X  
 Accessories: Describe new BT's witness objects etc. established, or work done to preserve existing evidence

Made bands around each bearing tree and painted the bands and the scribe blazes red. Attached Forest Service Land Survey Monument and Bearing Tree signs to each tree.

X \_\_\_\_\_ X

Work done by	David L. Haddock	Title	Land Surveyor	Date	July 1988	State Registration No.	852
Certified cor. record prepared?	yes		no x	Filed at		or Agency	
						Date	

X \_\_\_\_\_ X  
 REMARKS

X \_\_\_\_\_ X

Index File No.	Z-25	T.6S.	R.32E.	N. Willamette	Tract or Survey No	Cor.	S 36/31/6/1
----------------	------	-------	--------	---------------	--------------------	------	-------------