

## USDA-FOREST SERVICE

## INDEX

FILE NO.   7-7   CORNER RECORD (SEARCH) (Ref. FSM 7151.4) Tract or Survey No. \_\_\_\_\_ Cor. No. \_\_\_\_\_  
T.   6   S. \_\_\_\_\_ R.   32   E. R.D. North Fork John Day County Umatilla  
Merid. Willanette N.F. UMATILLA State Oregon \_\_\_\_\_

CORNER DIAGRAM 1 1 BLM BC 1 1  
1 1/4---- 1  
N 55 1  
1 775 1

1 1968 1 DESCRIBE BEARING TREES OR OTHER OFFICIAL ACCESSORIES FOUND  
----- 1 A 36" dbh Ponderosa Pine bears S44 1/4°E, 13.9' with healed blaze.

PHOTO IDENTIFICATION DATA 1 A 17" Douglas Fir bears N33°E, 24.4' with visible scribe.

Photo No. \_\_\_\_\_ 1 A dead and down 26" dbh Western Larch bears N60°E, 16.5' with visible scribe.

Filed at. \_\_\_\_\_ 1 A 13" dbh Douglas Fir bears S76 1/4°W, 37.6' with healed blaze.

Object Ident. \_\_\_\_\_ 1

Ident. By \_\_\_\_\_ 1

Signature \_\_\_\_\_ 1

PLANE COORDINATE POSITION DATA 1 DESCRIBE CORNER LOCATION RELATIVE TO NEAR-BY FEATURES, ALSO HOW TO REACH CORNER

State \_\_\_\_\_ Zone \_\_\_\_\_ 1 From Highway 395, follow FSR 55 6.5 miles to FSR 5505. Follow FSR 5505 0.5 mile to

X \_\_\_\_\_ 1 FSR5505020. Then follow FSR5505020 1.1 mile to a junction. Go right 0.25 mile to a junction.

Y \_\_\_\_\_ 1 Go right 0.3 mile to a junction. Go left 0.4 mile to a junction. Go left 0.75 mile to a

Estab. By \_\_\_\_\_ 1 junction. Go right and follow the road staying right 0.7 mile to the corner of sections

Agency \_\_\_\_\_ 1 4, 5, 32 and 33. Follow the sec. line west 0.5 mile to the corner.

Signature David L. Haddock Title Surveyor Division \_\_\_\_\_ Headquarters Pendleton, OR Date 6-02-94 FS-7100-52 (3/68)

CORNER RECORD (PERPETUATION)

MONUMENT : DESCRIBE NEW MONUMENT SET, OR WORK DONE TO PRESERVE EXISTING MONUMENT

Cleared brush and debris away from corner.

9

ACCESSORIES : DESCRIBE NEW BT's WITNESS OBJECTS ETC. ESTABLISHED, OR WORK DONE TO PRESERVE EXISTING EVIDENCE

Set new bearing tree.

A 10" dbh Douglas Fir bears N9 3/4°W, 26.0' scribed 1/4 S32 BT.

An aluminum washer stamped RLS 852 is nailed between the letters B and T on each new tree. BT and LSM signs are attached to each bearing tree and 6" red bands painted around them.

10

Work Done By David L. Haddock Title Land Surveyor Date 5-27-94 State Registration No. \_\_\_\_\_  
Certified Cor. Record Prepared?  Yes  No or Agency PLS 852 Filed At: Grant County Surveyor Date 6-94 11

REMARKS

12

Index File No. 7-7 T. 6 S. R. 32 E. M. Willamette Tract or Surv. No. \_\_\_\_\_ Cor. \_\_\_\_\_

13

GPD : 1984 0 - 439-095

USDA-FOREST SERVICE

Index  
File No. 2-7  
T 6S R. 32E  
Merid. Willamette


CORNER RECORD (SEARCH)

(Ref. FSM 7151.4)

Tract or  
Survey No. \_\_\_\_\_  
Cor.  
No. \_\_\_\_\_

R.D. NORTH FORK JOHN DAY County UMATILLA  
N.F. UMATILLA State OREGON

CORNER DIAGRAM

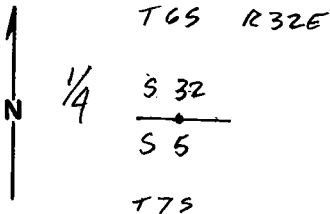

DESCRIBE CORNER MONUMENT FOUND

BRASS CAP MKD. T 6S R 32E, set on iron post in mound of stone.  
1/4 S 32  
S 5  
T 7 S  
1968

DESCRIBE BEARING TREES OR OTHER OFFICIAL ACCESSORIES FOUND

A Fir, 15" diam., bears S. 74° W., 57 lbs. or 37.6 ft. dist., healed blaze  
A pine, 44" diam., bears S. 43° 30' E., 21 lbs. or 13.9 ft. dist., (record S 43° E),  
with healed blaze and a 9" Y scathed on tree.

A Fir, 20" diam., bears N. 34° 30' E., 37 lbs or 30 ft. dist., healed blaze  
Steel guard post set 4 ft. EAST of cor. with USFS signs 54-2 & 54-9

DESCRIBE CORNER LOCATION RELATIVE TO NEAR-BY FEATURES, ALSO HOW TO REACH CORNER

cor sets on flat at base of ridge running NW to SE. where logging road  
in S. 1/2 of sec. 32 turns to the EAST, 90 SW approx. 1000 ft. ascending  
NW to SE hillside. first 600' ft. Continue in SW direction across  
flat final 400' through light timber to corner.

PHOTO IDENTIFICATION DATA

Photo No. \_\_\_\_\_  
Filed At. \_\_\_\_\_  
Object Ident. \_\_\_\_\_  
Ident. By \_\_\_\_\_  
Signature \_\_\_\_\_

PLANE COORDINATE POSITION DATA

State \_\_\_\_\_ Zone \_\_\_\_\_  
X \_\_\_\_\_  
Y \_\_\_\_\_  
Estab. By \_\_\_\_\_  
Agency \_\_\_\_\_

Signature Ken B. B... Title Pls Chief Division \_\_\_\_\_ Headquarters \_\_\_\_\_ Date 12/90  
FS-7100-52 (3/68)

CORNER RECORD (PERPETUATION)

MONUMENT : DESCRIBE NEW MONUMENT SET, OR WORK DONE TO PRESERVE EXISTING MONUMENT

Remove brush and debris from around corner

9

ACCESSORIES : DESCRIBE NEW BT'S WITNESS OBJECTS ETC. ESTABLISHED, OR WORK DONE TO PRESERVE EXISTING EVIDENCE

secured guardpost  
painted red bands around existing BT's

10

Work Done By GUY (PAT) Streamer Title LAND SURVEYOR Date 12/90 State Registration No. PLS 1341  
or Agency

Certified Cor. Record Prepared ? Yes  No Filed At: \_\_\_\_\_ Date \_\_\_\_\_ 11

REMARKS

WITNESS: KEN BATES

12

Index File No. Z-7 T. GS R. 32E M. W M Tract or Surv. No. \_\_\_\_\_ Cor. \_\_\_\_\_ 13