

Index  
File No. B-9

**CORNER RECORD (SEARCH)**

(Ref. FSM 7151.4)

Tract or  
Survey No. \_\_\_\_\_ Cor.  
No. \_\_\_\_\_


T 7S R. 32E

R.D. NORTH FOREIC JOHN DAY County GRANT

Merid. Willamette

N.F. LMA TILIA State OREGON

**CORNER DIAGRAM**

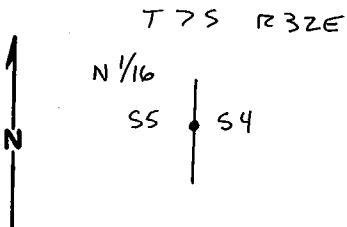

**DESCRIBE CORNER MONUMENT FOUND**

BRASS CAP MKD. N 1/16  
SS | S4  
1968

**DESCRIBE BEARING TREES OR OTHER OFFICIAL ACCESSORIES FOUND**

A Fir, 9 ins. diam., bears S 20° E., 42.2 ft. dist., healed blaze  
A Fir, 8 ins. diam., bears N 85° W., 73.6 ft. dist., healed blaze  
steel guard post east of corner.

**PHOTO IDENTIFICATION DATA**

Photo No. \_\_\_\_\_  
Filed At. \_\_\_\_\_  
Object Ident. \_\_\_\_\_  
Ident. By \_\_\_\_\_  
*Signature*

**PLANE COORDINATE POSITION DATA**

State \_\_\_\_\_ Zone \_\_\_\_\_  
X \_\_\_\_\_  
Y \_\_\_\_\_  
Estab. By \_\_\_\_\_  
*Agency*

**DESCRIBE CORNER LOCATION RELATIVE TO NEAR-BY FEATURES, ALSO HOW TO REACH CORNER**

corner on flat at base of steep hill, light timber. TAKE NF LOCAL RD. 130 OF NE collector RD. 1003. FOLLOW 130 NORTH APPROX 1.25 MI. TO WHERE RD BEARS TO EAST JUST NORTH OF 1/4 COR S/4. AT THIS POINT CONTINUE NORTH APPROX 1000 FT. TO WHERE NW DESCENT BEGINS. CORNER AT BASE OF HILL, APPROX. 250 FT.

*Signature*  
Ken Birt

*Title*  
Pty Chief

Division \_\_\_\_\_

Headquarters \_\_\_\_\_

Date  
10/1/90

FS-7100-52 (3/68)

CORNER RECORD (PERPETUATION)

MONUMENT : DESCRIBE NEW MONUMENT SET, OR WORK DONE TO PRESERVE EXISTING MONUMENT

Remove brush and debris from around corner

ACCESSORIES : DESCRIBE NEW BT'S WITNESS OBJECTS ETC. ESTABLISHED, OR WORK DONE TO PRESERVE EXISTING EVIDENCE

Secure guard post  
PAINT BT'S

Work Done By Guy (Pat) Streamer Title LAND SURVEYOR Date 10/90 State Registration No. PLS 1341  
or Agency \_\_\_\_\_  
Certified Cor. Record Prepared? Yes  No  Filed At: \_\_\_\_\_ Date \_\_\_\_\_

REMARKS

Witness: Ken BATES

Index File No. B-9 T. 75 R. 32E M. WM Tract or Surv. No. \_\_\_\_\_ Cor. \_\_\_\_\_

USDA-FOREST SERVICE

Index

File No. B-9

T 78 R. 32E

Merid. W.M.

CORNER RECORD (SEARCH)

N. Fk. (Ref. FSM 7151.4)

Tract or Survey No. \_\_\_\_\_

Cor. No. \_\_\_\_\_

R.D. John Day County Grant

N.F. Umatilla State Or.

CORNER DIAGRAM



N1/16  
85184

DESCRIBE CORNER MONUMENT FOUND

2 1/2" iron pipe with 3 1/4" brass cap (BLM) mkd.:

N1/16  
85184  
1968

DESCRIBE BEARING TREES OR OTHER OFFICIAL ACCESSORIES FOUND

D. Fir, 9", S20°E, 64 lks.; with healed blaze.  
D. Fir, 16", N85°W, 111 1/2 lks.; with healed blaze.

PHOTO IDENTIFICATION DATA

Photo No. \_\_\_\_\_

Filed At. \_\_\_\_\_

Object Ident. \_\_\_\_\_

Ident. By \_\_\_\_\_

*Signature*

PLANE COORDINATE POSITION DATA

State \_\_\_\_\_ Zone \_\_\_\_\_

X \_\_\_\_\_

Y \_\_\_\_\_

Estab. By \_\_\_\_\_

*Agency*

Signature

*F. L. Munro*

Title

PLS

Division

Headquarters

Date

7/11/90

FS-7100-52 (3/68)

6

7

8

1

2

3

4

5

CORNER RECORD (PERPETUATION)

MONUMENT : DESCRIBE NEW MONUMENT SET, OR WORK DONE TO PRESERVE EXISTING MONUMENT

None.

9

ACCESSORIES : DESCRIBE NEW BT's WITNESS OBJECTS ETC. ESTABLISHED, OR WORK DONE TO PRESERVE EXISTING EVIDENCE

None.

10

Work Done By. F.S. Munro Title PLS 7/4/90 State Registration No. 1832  
or Agency

Certified Cor. Record Prepared ? Yes No  Filed At: \_\_\_\_\_ Date \_\_\_\_\_

11

REMARKS

12

Index File No. B-9 T. 7S R. 32E M. W.M. Tract or Surv. No. \_\_\_\_\_ Cor. \_\_\_\_\_

13