


USDA-FOREST SERVICE

Index
 File No. C-11
 T 7S R. 32E
 Merid. W.M.

CORNER RECORD (SEARCH)

N. Pk. (Ref. FSM 7151.4)
 R.D. John Day County Grant Tract or Survey No. _____ Cor. No. _____
 N.F. Umatilla State Or.

CORNER DIAGRAM

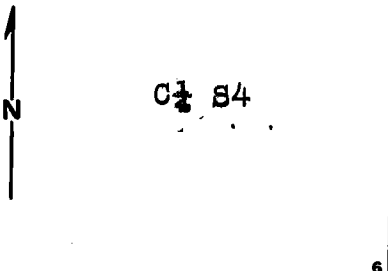

1 DESCRIBE CORNER MONUMENT FOUND
 2 1/2" iron pipe with 3 1/4" brass cap (BLM) T7S R32E
 mkd.: C 1/2 S 4
 1968

2 DESCRIBE BEARING TREES OR OTHER OFFICIAL ACCESSORIES FOUND
 P. Pine, 15", East, 193 1/2 lks.; with scribing visible.
 P. Pine, 19", N26 1/4°W, 199 lks.; with healed blaze.

6 PHOTO IDENTIFICATION DATA
 Photo No. _____
 Filed At. _____
 Object Ident. _____
 Ident. By _____
 Signature _____

3 DESCRIBE CORNER LOCATION RELATIVE TO NEAR-BY FEATURES, ALSO HOW TO REACH CORNER
 Corner falls in open on NEly slope, E. of rd.
 Posted line E. and W.

8 PLANE COORDINATE POSITION DATA
 State _____ Zone _____
 X _____
 Y _____
 Estab. By _____
 Agency _____

Signature F. L. Munro Title PLS Division _____ Headquarters _____ Date 7/11/90 FS-7100-52 (3/68)
 5

CORNER RECORD (PERPETUATION)

MONUMENT : DESCRIBE NEW MONUMENT SET, OR WORK DONE TO PRESERVE EXISTING MONUMENT

None..

9

ACCESSORIES : DESCRIBE NEW BT's WITNESS OBJECTS ETC. ESTABLISHED, OR WORK DONE TO PRESERVE EXISTING EVIDENCE

None..

10

Work Done By F.S. Munro Title PLS Date 7/4/90 State Registration No. or Agency 1832

Certified Cor. Record Prepared ? Yes No Filed At: _____ Date _____

11

REMARKS

12

Index File No. G-111.T. 78 R. 32E M. W.M. Tract or Surv. No. _____ Cor. _____

13