

USDA-FOREST SERVICE

Index File No. B-2

CORNER RECORD (SEARCH)

(Ref. FSM 7151.4)

Tract or Survey No. _____

Cor. No. _____

T 7S R. 33E

R.D. NORTH FORK JOHN DAY County

GRANT

Merid. WILLAMETTE

N.F. UMATILLA State

OREGON

CORNER DIAGRAM

T7S R33E

NW 1/4 ● 56

PLS 1832
1989

DESCRIBE CORNER MONUMENT FOUND

ALUM. PIPE WITH ALUM. CAP MKD AS IN
DIAGRAM.

DESCRIBE BEARING TREES OR OTHER OFFICIAL ACCESSORIES FOUND

THE 2 BEARING TREES ARE O.K.

PHOTO IDENTIFICATION DATA

Photo No. _____

Filed At. _____

Object Ident. _____

Ident. By _____

Signature

PLANE COORDINATE POSITION DATA

State _____ Zone _____

X _____

Y _____

Estab. By _____

Agency

Signature

Title

Division

Headquarters

Date

FS-7100-52 (3/68)

Dennis L. Hayford

PLS 1636 MARCH 1997

CORNER RECORD (PERPETUATION)

MONUMENT: DESCRIBE NEW MONUMENT SET, OR WORK DONE TO PRESERVE EXISTING MONUMENT

ACCESSORIES : DESCRIBE NEW BT's WITNESS OBJECTS ETC. ESTABLISHED, OR WORK DONE TO PRESERVE EXISTING EVIDENCE

Work Done By _____ Title _____ Date _____ State Registration No. or Agency _____

Certified Cor. Record Prepared ? Yes No Filed At: _____ Date _____

REMARKS

Index File No. T. R. M. Tract or Surv. No. Cor.

USDA-FOREST SERVICE


Index
File No. B-2
T 78 R. 33E
Merid. W.M.

CORNER RECORD (SEARCH)

(Ref. FSM 7151.4)

Tract or Survey No. _____ Cor. No. _____
R.D. N. Fk. J. D. County Grant
N.F. Umatilla State Or.

CORNER DIAGRAM

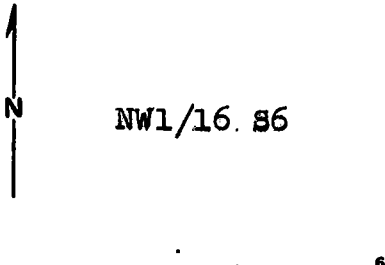

DESCRIBE CORNER MONUMENT FOUND

None..

DESCRIBE BEARING TREES OR OTHER OFFICIAL ACCESSORIES FOUND

None..

PHOTO IDENTIFICATION DATA

Photo No. _____
Filed At. _____
Object Ident. _____
Ident. By _____
Signature

DESCRIBE CORNER LOCATION RELATIVE TO NEAR-BY FEATURES, ALSO HOW TO REACH CORNER

Cor. falls on SEly slope. From K tag on 017 rd. follow posted line 627' E.

PLANE COORDINATE POSITION DATA

State _____ Zone _____
X _____
Y _____
Estab. By _____
Agency

J. L. Manis

PLS

Division

Headquarters

Date

10/27/89

FS-7100-52 (3/68)

CORNER RECORD (PERPETUATION)

MONUMENT: DESCRIBE NEW MONUMENT SET, OR WORK DONE TO PRESERVE EXISTING MONUMENT

Set 2 1/2" x 30" alum. pipe,, alum. cap mkd.:

NW1/16
S6
PLS 1832
1989

ACCESSORIES : DESCRIBE NEW BT'S WITNESS OBJECTS ETC. ESTABLISHED, OR WORK DONE TO PRESERVE EXISTING EVIDENCE

P. Pine, 19" , S39 1/2 W, 99.0'; mkd.: NW1/16 S6 BT

P. Pine, 16" , S58 E, 14.4'; mkd.: NW1/16 S6 BT

BTs have red blaze,, band, BT tags, 54-9 signs and alum. "PLS 1832" washers. 6' fence post with 54-9 sign within 5' of cor.

Work Done By F.S. Mumro Title PLS Date 8/18/89 State Registration No. 1832
or Agency _____

Certified Cor. Record Prepared ? Yes No _____ Filed At: Grant Co., Surveyor Date _____

REMARKS

Index File No. B-2 T. 7S R. 33E M. W.M. Tract or Surv. No. _____ Cor. _____