

Index
File No. B-3

CORNER RECORD (SEARCH)

(Ref. FSM 7151.4)

Tract or
Survey No. _____ Cor.
No. _____


T 7S R. 33E

R.D. N. Fk. J. D. County Grant

Merid. W.M.

N.F. Umatilla State Or.

CORNER DIAGRAM

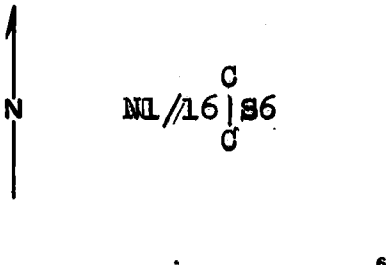

DESCRIBE CORNER MONUMENT FOUND

None..

DESCRIBE BEARING TREES OR OTHER OFFICIAL ACCESSORIES FOUND

None..

PHOTO IDENTIFICATION DATA

Photo No. _____
Filed At. _____
Object Ident. _____
Ident. By _____
Signature

DESCRIBE CORNER LOCATION RELATIVE TO NEAR-BY FEATURES, ALSO HOW TO REACH CORNER

Cor. falls on Sly slope, N of 5507 rd. and is visible from rd..

PLANE COORDINATE POSITION DATA

State _____ Zone _____
X _____
Y _____
Estab. By _____
Agency

Signature

Title
PLS

Division

Headquarters

Date

10/27/89

FS-7100-52 (3/68)

CORNER RECORD (PERPETUATION)

MONUMENT: DESCRIBE NEW MONUMENT SET, OR WORK DONE TO PRESERVE EXISTING MONUMENT

Set 2 1/2" x 30" alum. pipe, alum. cap mkd.:

C
N1/16186
C
PLS 1832
1989

ACCESSORIES : DESCRIBE NEW BT'S WITNESS OBJECTS ETC. ESTABLISHED, OR WORK DONE TO PRESERVE EXISTING EVIDENCE

P. Pine, 16", S28 3/4E, 28.6'; mkd.: CN1/16 86 BT

P. Pine, 14", S74 1/2W, 14.9'; mkd.: CN1/16 86 BT

BTs have red blaze, band, BT tags, 54-9 signs and alum. "PLS 1832" washers. 6' fence post with 54-9 sign within 5' of cor.

Work Done By F.S. Munro Title PLS Date 8/18/89 State Registration No. 1832
or Agency _____

Certified Cor. Record Prepared ? Yes No _____ Filed At: Grant Co. Surveyor Date _____

REMARKS

Index File No. B-3 T. 79 R. 33E M. W.M. Tract or Surv. No. _____ Cor. _____