

USDA-FOREST SERVICE

Index

File No.

T. 7 S. R. 33 E.

Merid. WILLAMETTE

CORNER RECORD (SEARCH)

(Ref. FSM 7151.4)

R.D. NOTH FORK JOHN DAY
N.F. UMATILLA

County GRANT
State OREGON


Tract or

Survey No. NFJD UNIT

Cor.

No. AP-3441

CORNER DIAGRAM

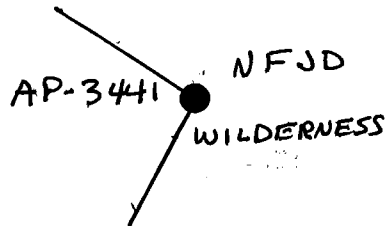

DESCRIBE CORNER MONUMENT FOUND

NONE

DESCRIBE BEARING TREES OR OTHER OFFICIAL ACCESSORIES FOUND

NONE

PHOTO IDENTIFICATION DATA

Photo No.:

Filed At:

Object Ident.:

Ident. By:

Signature

DESCRIBE CORNER RELATIVE TO NEAR-BY FEATURES, ALSO HOW TO REACH CORNER

From the jct of roads 1012 and 5505, travel southerly on road 5505 approx. 0.30 miles. Then walk East approx. 1100 feet to abandon road 5505-165. The corner is located 100 feet easterly of the road on the ridge between Kelsay creek and the North Fork John Day River.

PLANE COORDINATE POSITION

State: Oregon Zone: North

X: 2,461,739.80'

Y: 472,402.58'

Datum: NAD1927

Signature

D. Schlaich

Title

Land Surveyor

Division

Headquarters

S.O.

Date

07/1993

FS-7100-52 (3/68)

CORNER RECORD (PERPETUATION)

MONUMENT: DESCRIBE NEW MONUMENT SET, OR WORK DONE TO PRESERVE EXISTING MONUMENT

Set a 5/8" by 36" rebar, with a 3 1/4" aluminum cap, flush with the ground, mkd. "NFJD WILDERNESS AP-3441 RLS 2308 1993".

ACCESSORIES: DESCRIBE NEW BT's WITNESS OBJECTS ETC. ESTABLISHED, OR WORK DONE TO PRESERVE EXISTING EVIDENCE

7" Douglas Fir, S. 85° W., 18.8 ft., mkd. "WB/3441""BT".

9" Englemann Spruce, N. 51° E., 50.5 ft., mkd. "WB/3441""BT".

The BT's are double blazed and have a 3/4" brass washer mkd. "RLS 2308" nailed to the lower blaze by the "BT" scribing.

Work Done By D. Schlaich

Title Land Surveyor

Date 07/1993

State Registration No.
or Agency

Certified Cor. Record Prepared? NO

Filed At:

Date

REMARKS

Index File No.

T.

7 S.

R.

33 E.

M.

W.M.

Tract or Survey No.

NFJD UNIT

Cor.

AP-3441