

Index

File No.

T. 7 S. R. 33 E.
Merid. WILLAMETTE


CORNER RECORD (SEARCH)
(Ref. FSM 7151.4)

R.D. NOTH FORK JOHN DAY County GRANT
N.F. UMATILLA State OREGON

Tract or
Survey No. NFJD UNIT

Cor.
No. AP-3367

CORNER DIAGRAM

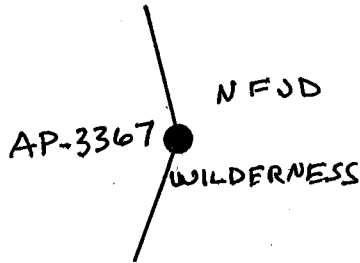

DESCRIBE CORNER MONUMENT FOUND

NONE

DESCRIBE BEARING TREES OR OTHER OFFICIAL ACCESSORIES FOUND

NONE

PHOTO IDENTIFICATION DATA

Photo No.:
Filed At.:
Object Ident.:
Ident. By:

Signature

PLANE COORDINATE POSITION

State: Oregon Zone: North
X: 2,465,134.67'
Y: 465,865.40'
Datum: NAD1927

DESCRIBE CORNER RELATIVE TO NEAR-BY FEATURES, ALSO HOW TO REACH CORNER

From the jct of road 5505 and trail 3007 travel easterly on the trail approx. 2400 feet. Then walk northerly approx. 100 feet to AP-3345 which is located at an elevation of 5360 feet. Then follow the 5360 foot contour and the marked wilderness boundary northwesterly approx. 2300 feet to the corner.

Signature

D. Schlaich

Title

Land Surveyor

Division

Headquarters

S.O.

Date

07/16/92

FS-7100-52 (3/68)

CORNER RECORD (PERPETUATION)

MONUMENT: DESCRIBE NEW MONUMENT SET, OR WORK DONE TO PRESERVE EXISTING MONUMENT

Set a 5/8" by 42" aluminum rod, with a 3 1/4" aluminum cap, flush with the ground, mkd. "NFJD WILDERNESS ELEV 5360 AP-3367 RLS 2308 1992".

ACCESSORIES : DESCRIBE NEW BT's WITNESS OBJECTS ETC. ESTABLISHED, OR WORK DONE TO PRESERVE EXISTING EVIDENCE

6" Douglas Fir, N. 59° E., 5.6 ft., mkd. "WB/3367""BT".

9" Lodgepole Pine, N. 40° W., 26.4 ft., mkd. "WB/3367""BT".

Both BT's are double blazed and have a 3/4" brass washer mkd. "RLS 2308" nailed to the lower blaze by the "BT" scribing.

Work Done By D. Schlaich

Title Land Surveyor

Date 07/16/92

State Registration No.
or Agency

Certified Cor. Record Prepared ? NO

Filed At:

Date

REMARKS

Index File No.

T.

7 S.

R.

33 E.

M.

W.M.

Tract or Survey No.

NFJD UNIT

Cor.

AP-3367