

CORNER RECORD (SEARCH)

Tract or

Cor.

Index

(Ref. FSM 7151.4)

Survey No. NFJD UNIT

No. AP-3345

File No.

T. 7 S. R. 33 E.

R.D. NORTH FORK JOHN DAY


County GRANT

Merid. WILLAMETTE

N.F. UMATILLA

State OREGON

CORNER DIAGRAM

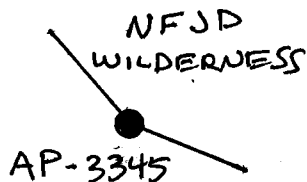

DESCRIBE CORNER MONUMENT FOUND

NONE:

DESCRIBE BEARING TREES OR OTHER OFFICIAL ACCESSORIES FOUND

NONE:

PHOTO IDENTIFICATION DATA

Photo No.:

Filed At.:

Object Ident.:

Ident. By.:

Signature

PLANE COORDINATE POSITION DATA

State: Oregon Zone: North

X: 2,465,586.43'

Y: 463,677.91'

Datum: NAD1927

DESCRIBE CORNER RELATIVE TO NEAR-BY FEATURES, ALSO HOW TO REACH CORNER

From the jct of road 5505 and trail 3007 travel easterly on the trail approx. 2400 feet.
The corner is located 100 feet northerly of the trail at an elevation of 5360 feet.

Signature

D. Schlaich

Title

Land Surveyor

Division

Headquarters

S.O.

Date

07/01/92

FS-7100-52 (3/68)

CORNER RECORD (PERPETUATION)

MONUMENT: DESCRIBE NEW MONUMENT SET, OR WORK DONE TO PRESERVE EXISTING MONUMENT

Set a 2 1/2" by 30" aluminum pipe, with a 2 1/2" aluminum cap, flush with the ground, mkd. "NFJD WILDERNESS ELEV. 5360 AP-3345 RLS 2308 1992".

ACCESSORIES : DESCRIBE NEW BT's WITNESS OBJECTS ETC. ESTABLISHED, OR WORK DONE TO PRESERVE EXISTING EVIDENCE

8" Lodgepole Pine, N. 01° W., 22.4 ft., mkd. "WB/3345""BT".

6" Lodgepole Pine, S. 43° W., 8.4 ft., mkd. "WB/3345""BT".

Both BT's are double blazed and have a 3/4" brass washer mkd. "RLS 2308" nailed to the lower blaze by the "BT" scribing.

Work Done By D. Schlaich

Title Land Surveyor

Date 07/01/92

State Registration No.
or Agency

Certified Cor. Record Prepared ? NO

Filed At:

Date

REMARKS

Index File No.

T.

7 S.

R.

33 E.

M.

W.M.

Tract or Survey No.

NFJD UNIT

Cor.

AP-3345