Township No. 1 North Range No. 33 East Willamette Meridian, Or.

4178

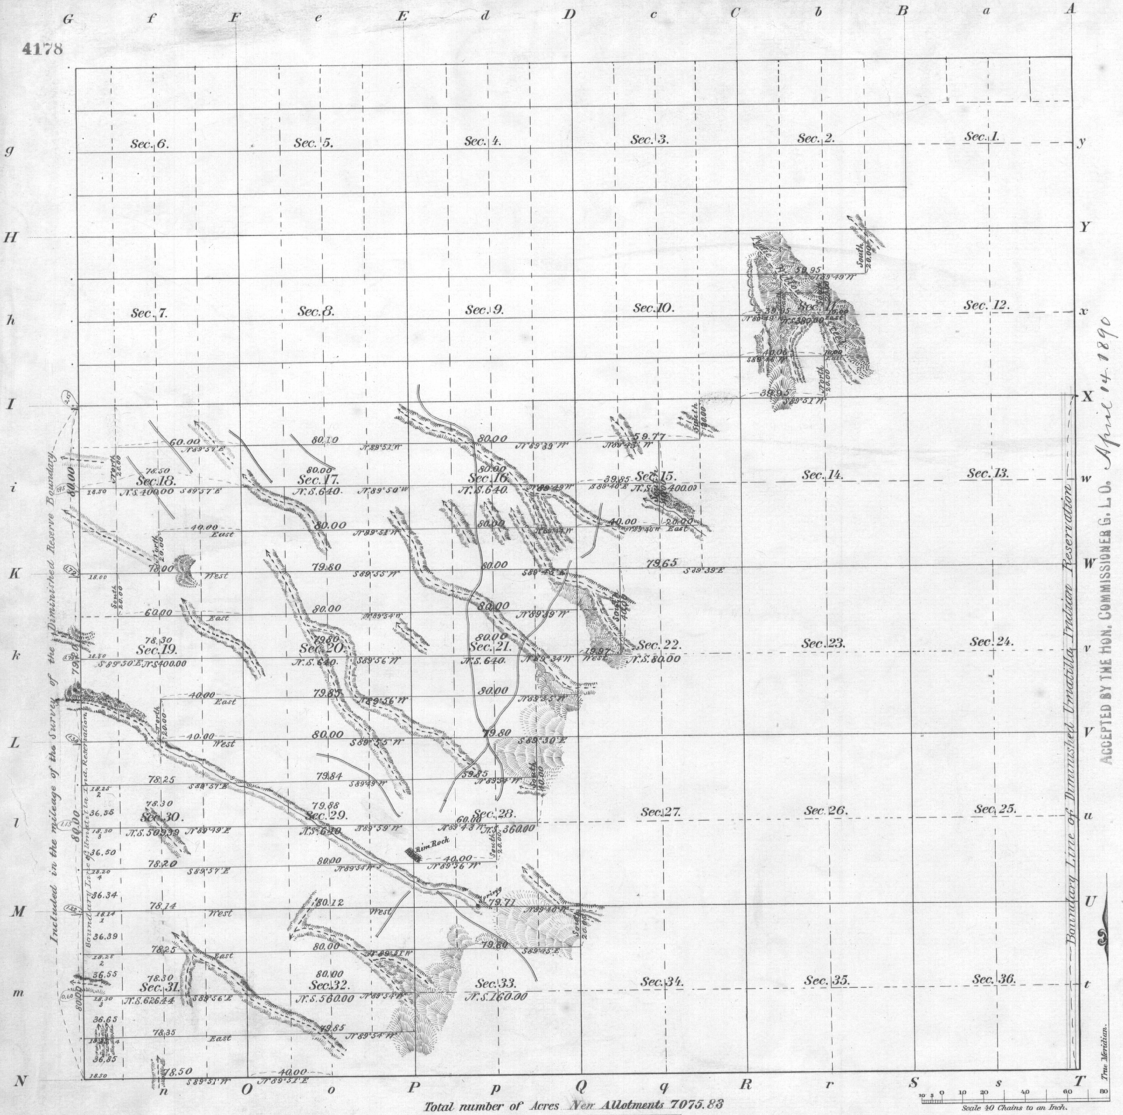

ACCEPTED BY THE HON. COMMISSIONER G. L. O. April 14. 1890

Meanders of

Posts	Courses	Ch.s Lk.s	Posts	Courses	Ch.s Lk.s	Posts	Courses	Ch.s Lk.s

Total number of Acres New Allotments 7075.83

Surveys Designated.	By Whom. Surveyed.	Date of Contract.	Amount of Surveys.			When Surveyed.	Mean. Declination.
			No.	M.	Ch.s	Lk.s	
Township lines in part	James P. Currin	March 5th 1889	537	1	38	50	June 18th to 22nd 1889	15°00' to 23°00' E.
Subdivisions	James P. Currin	March 5th 1889	537	59	50	14	June 18th to 22nd 1889	15°00' to 23°00' E.

The above Map, of Township No. 1 North of Range No. 33 East of the Willamette Meridian, Oregon is strictly conformable to the field notes of the survey thereof on file in this Office, which have been examined and approved.

Surveyor Generals Office, Portland, Oregon August 31st 1889

Douglas W. Taylor, Sur. Gen.