


Township No. 2 North, Range No. 29 East, Willamette Meridian.

3884

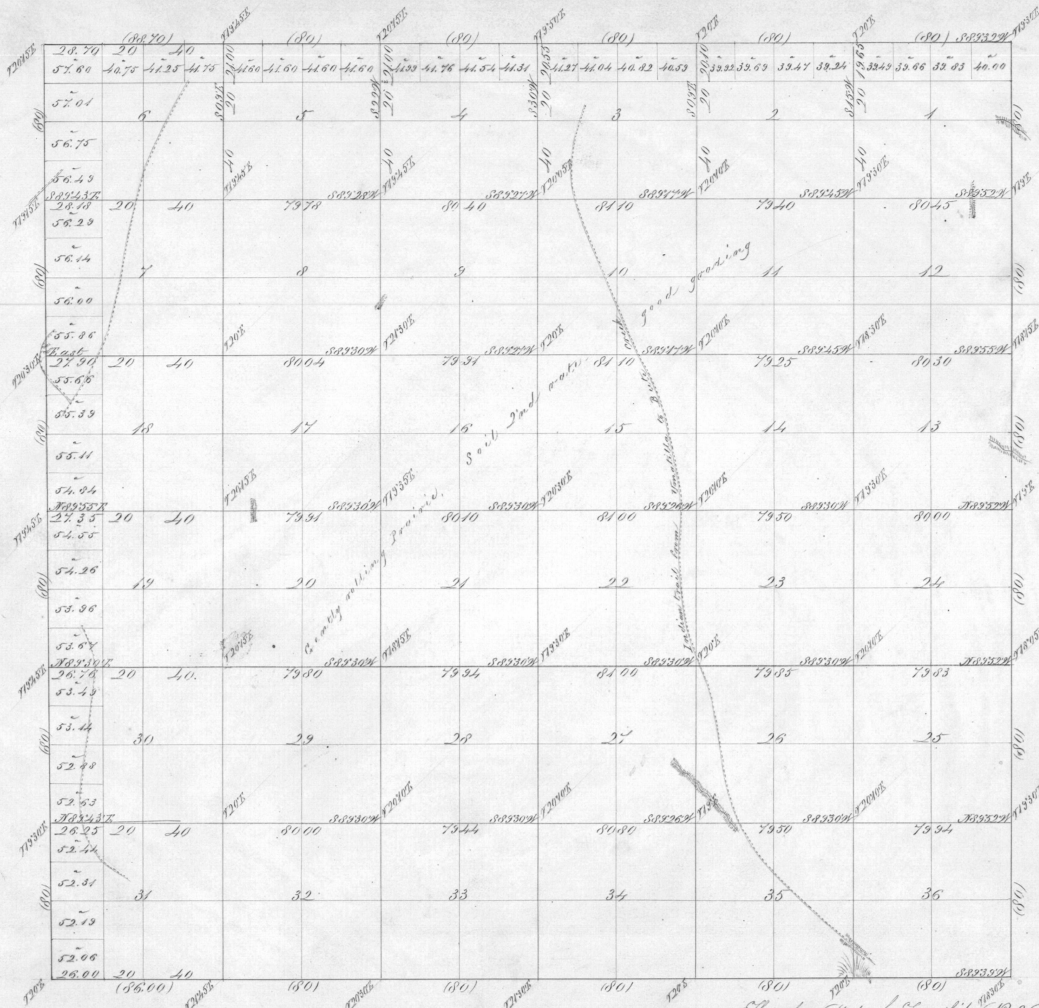

Surveys designated	By whom surveyed	Contract		Acre		When surveyed
		No.	Date	Acres	Sections	
Township Lines	David P. Thompson	83	July 22nd 1853	12	08 70	January 31st 1860
Subdivisions	David P. Thompson	83	July 22nd 1853	60	41 08	January 31st 1860
Total number of Acres	23408 49					

This Map of Township No. 2 North, of Range No. 29 East, of the Willamette Meridian, Oregon, is strictly conformable to the field notes of the Survey, filed in this Office, which have been examined and approved.
 Surveyor General's Office,
 Eugene City, January 31st, 1860. *A. H. Chapman*
S. W. Reed
 1860