Township No 2 North Range No 36 East of the Willamette Meridian Oregon

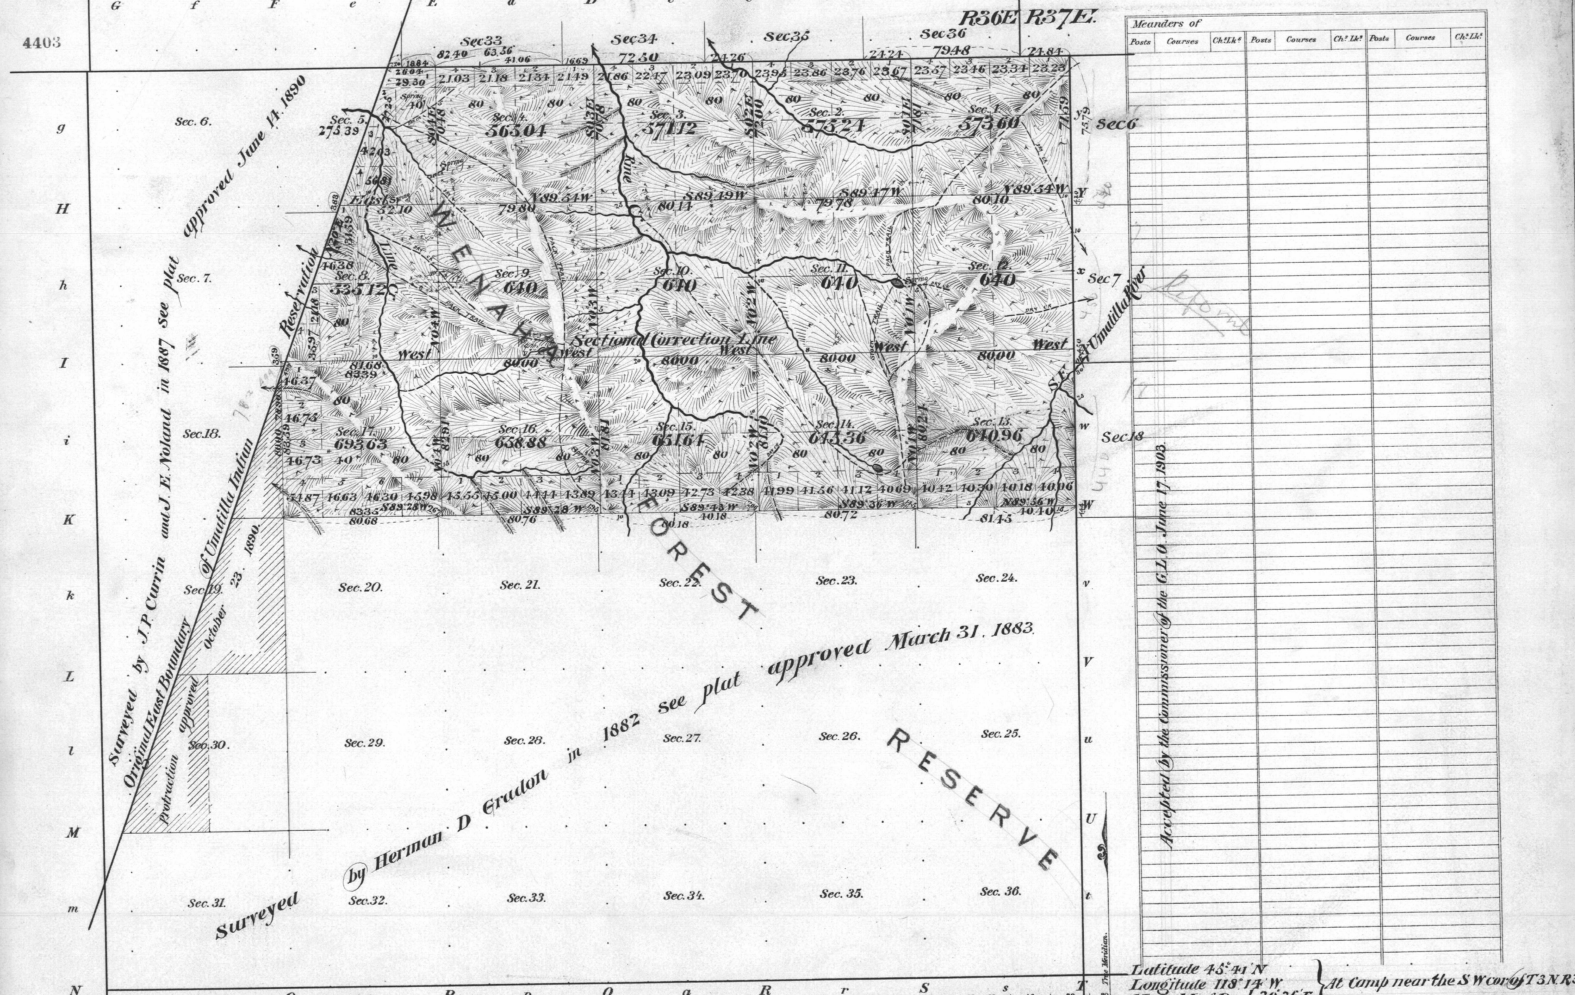

Area of Former Surveys 14336.39 Acres of New Survey 89435.98 Acres Total number of Acres 23502.37

Surveys Designated.	By Whom Surveyed.	Date of Contract.	Amount of Surveys M.	Ch.	Lks.	When Surveyed.	No of Contract.
Township lines	Wm F & C.L. Campbell	Mar 22 1901					733
N 3rd & S Bdy Subdivisions	" " "	" " "	21	26	44	June 20th & July 3rd 1901	"
Connections	" " "	" " "	1	19	58	" " "	"
Retracements	" " "	" " "	3	07	03	July 3 and 4 1901	"
West Boundary of Sec 13	Carman & Noland	May 4 1887				1887	Special Instructions
East & South Boundaries of Sec 13 & West & South Boundaries of Sec 12	Herman D. Gradon	June 16 1882				1882	452
South Boundary of Sec 35 & North Bdy of Sec 1	Wm H. Odell	July 2 1866				1866	113

The above Map of Township No 2 North of Range No 36 East of the Willamette Meridian, Oregon, is strictly conformable to the field notes of the survey thereof on file in this Office, which have been examined and approved.

Surveyor Generals Office,
Portland Oregon Mar 4 1903

Surv. Gen. for Oregon