4186


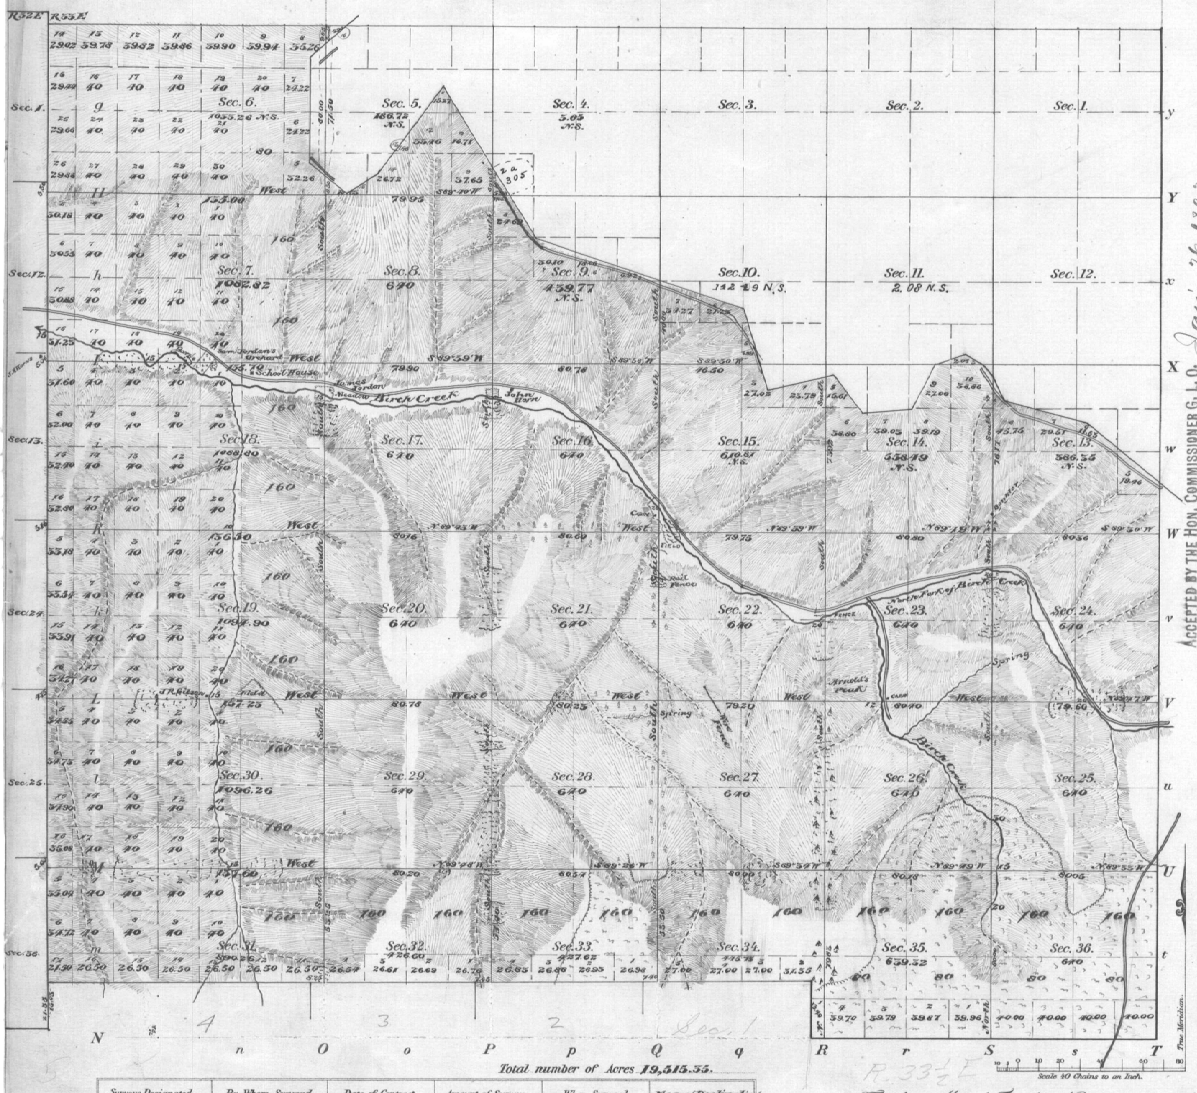

Total number of Acres 19,515.55.

Surveys Designated	By Whom Surveyed	Date of Contract	Amount of Surveys M. Ch. Lks.	When Surveyed	Mean Declination
Township lines					
Subdivisions	John C. Arnold	March 19 1890	49 56 26	Sept. 17, 1890	19° 30' E.
Connections	" "	" "	98 77	" 25, 1891	
Contract No. 35					

Meanders of

Posts	Courses	Ch. Lks.	Posts	Courses	Ch. Lks.	Posts	Courses	Ch. Lks.

ACCEPTED BY THE HON. COMMISSIONER G. L. O. Jan'y 26 1893


Surveyor Generals Office, Portland, Oregon, Sept. 6th 1892.

W. Henry Byars
Surv. Gen'l for Oregon.