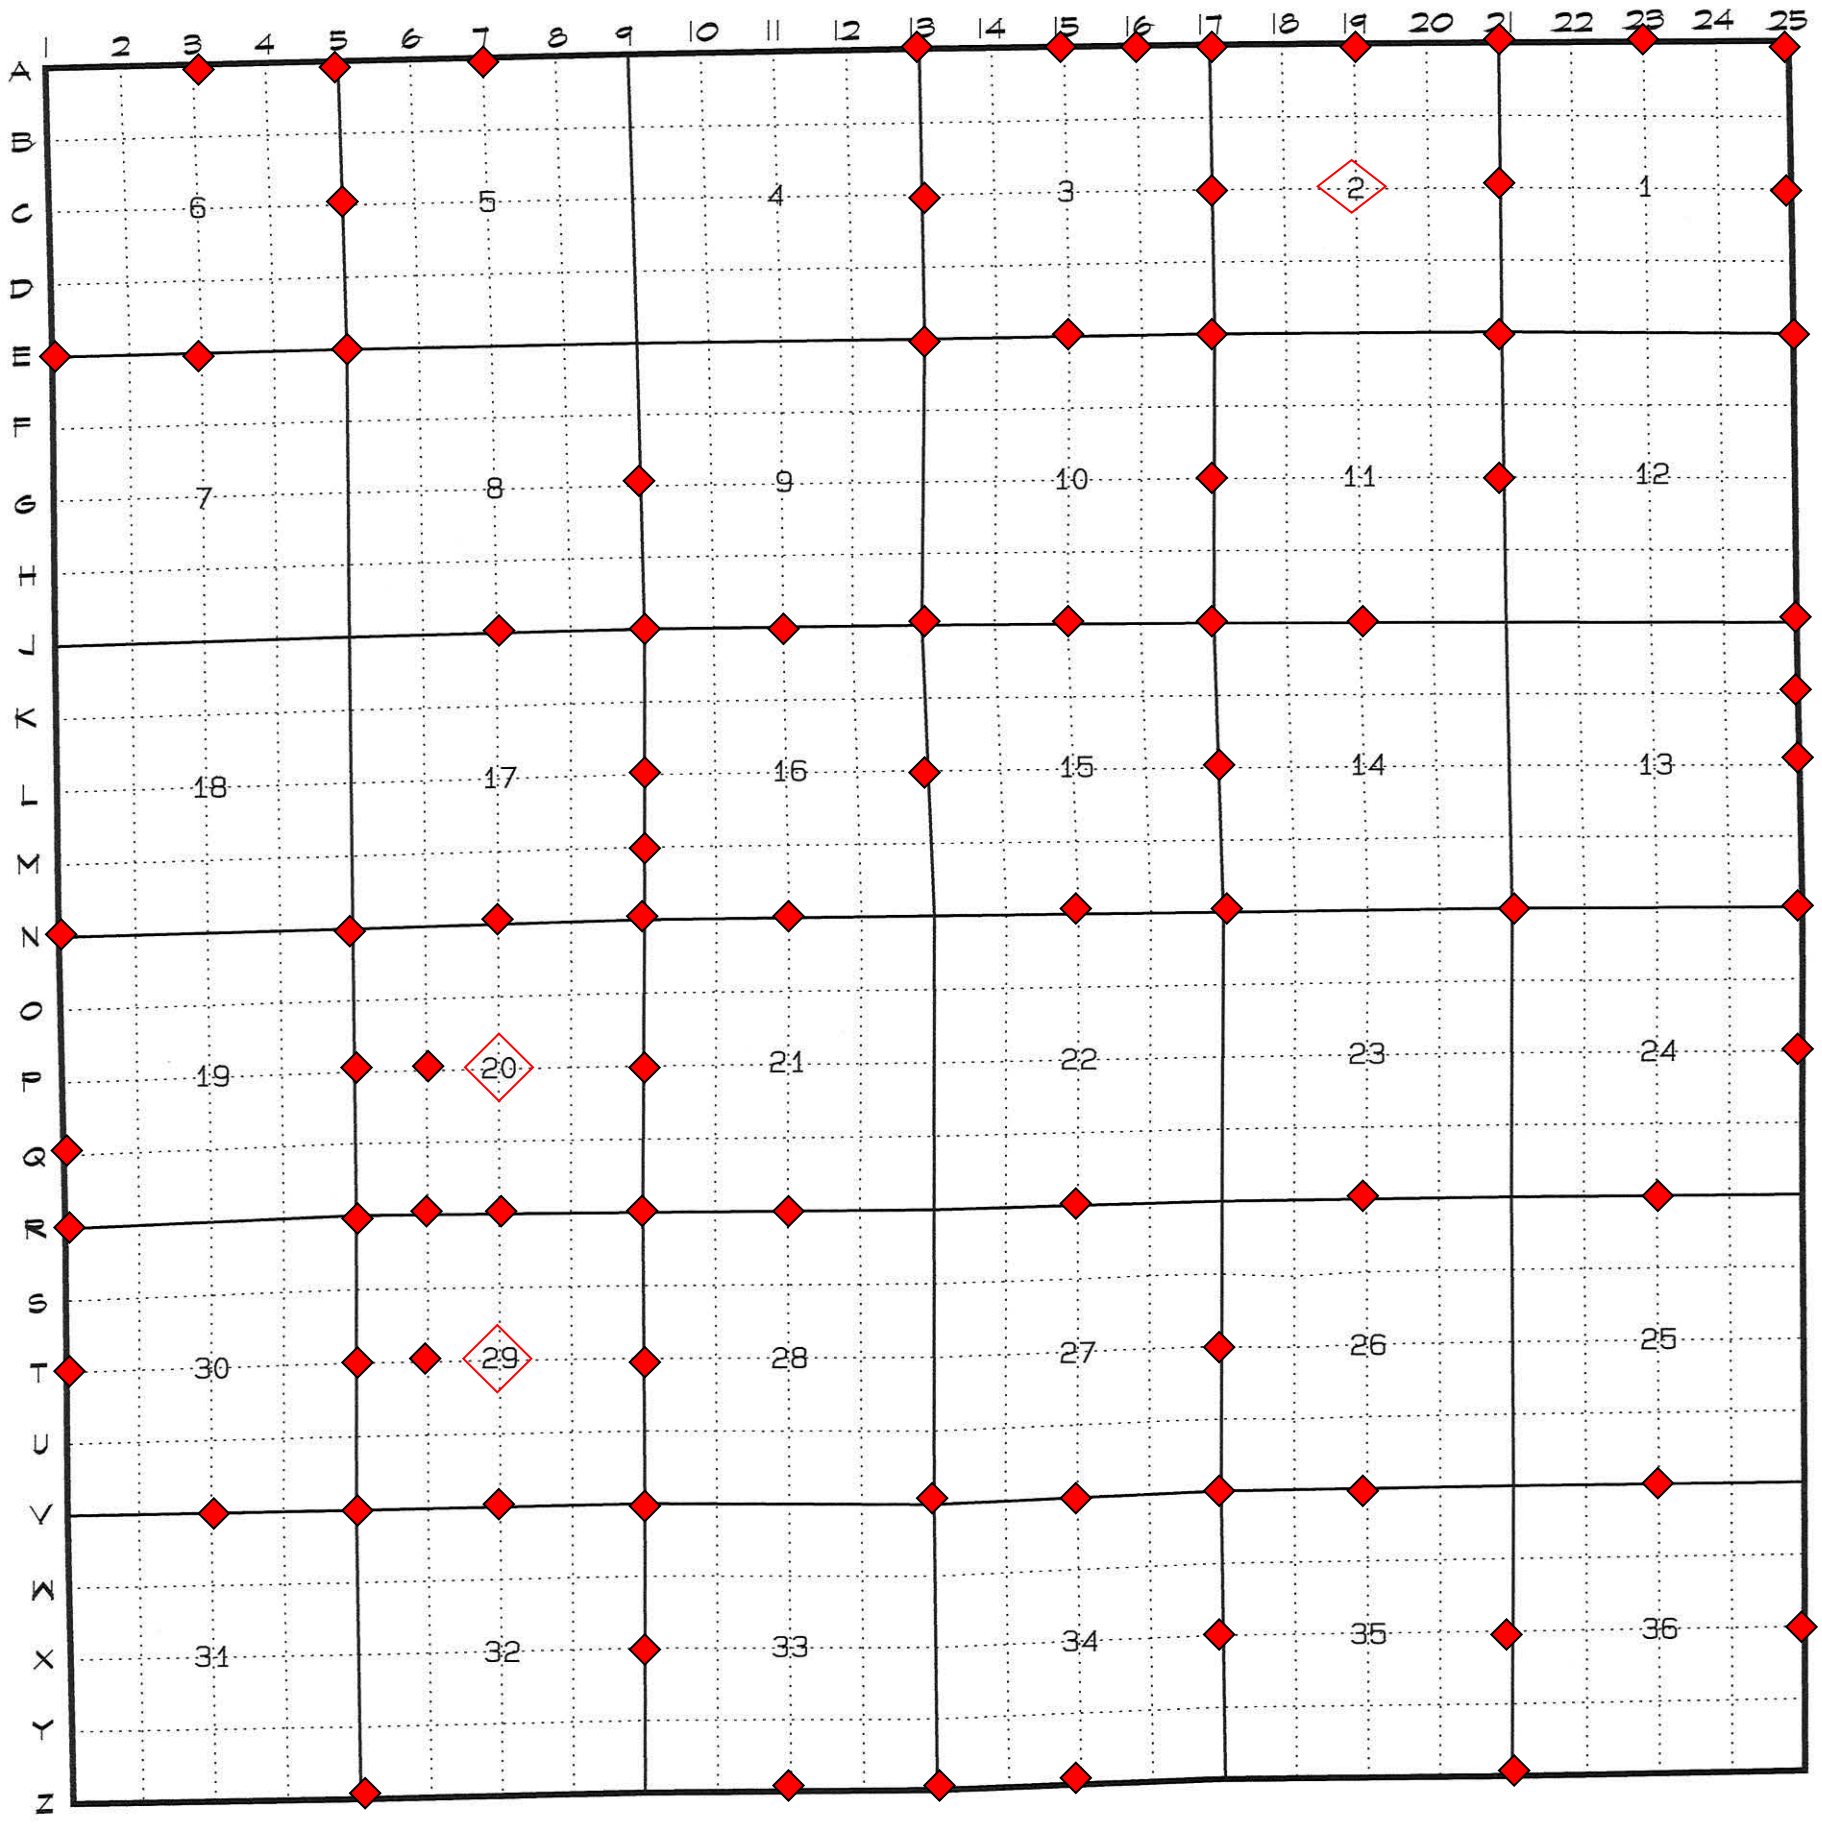TOWNSHIP 2 SOUTH RANGE 31 EAST