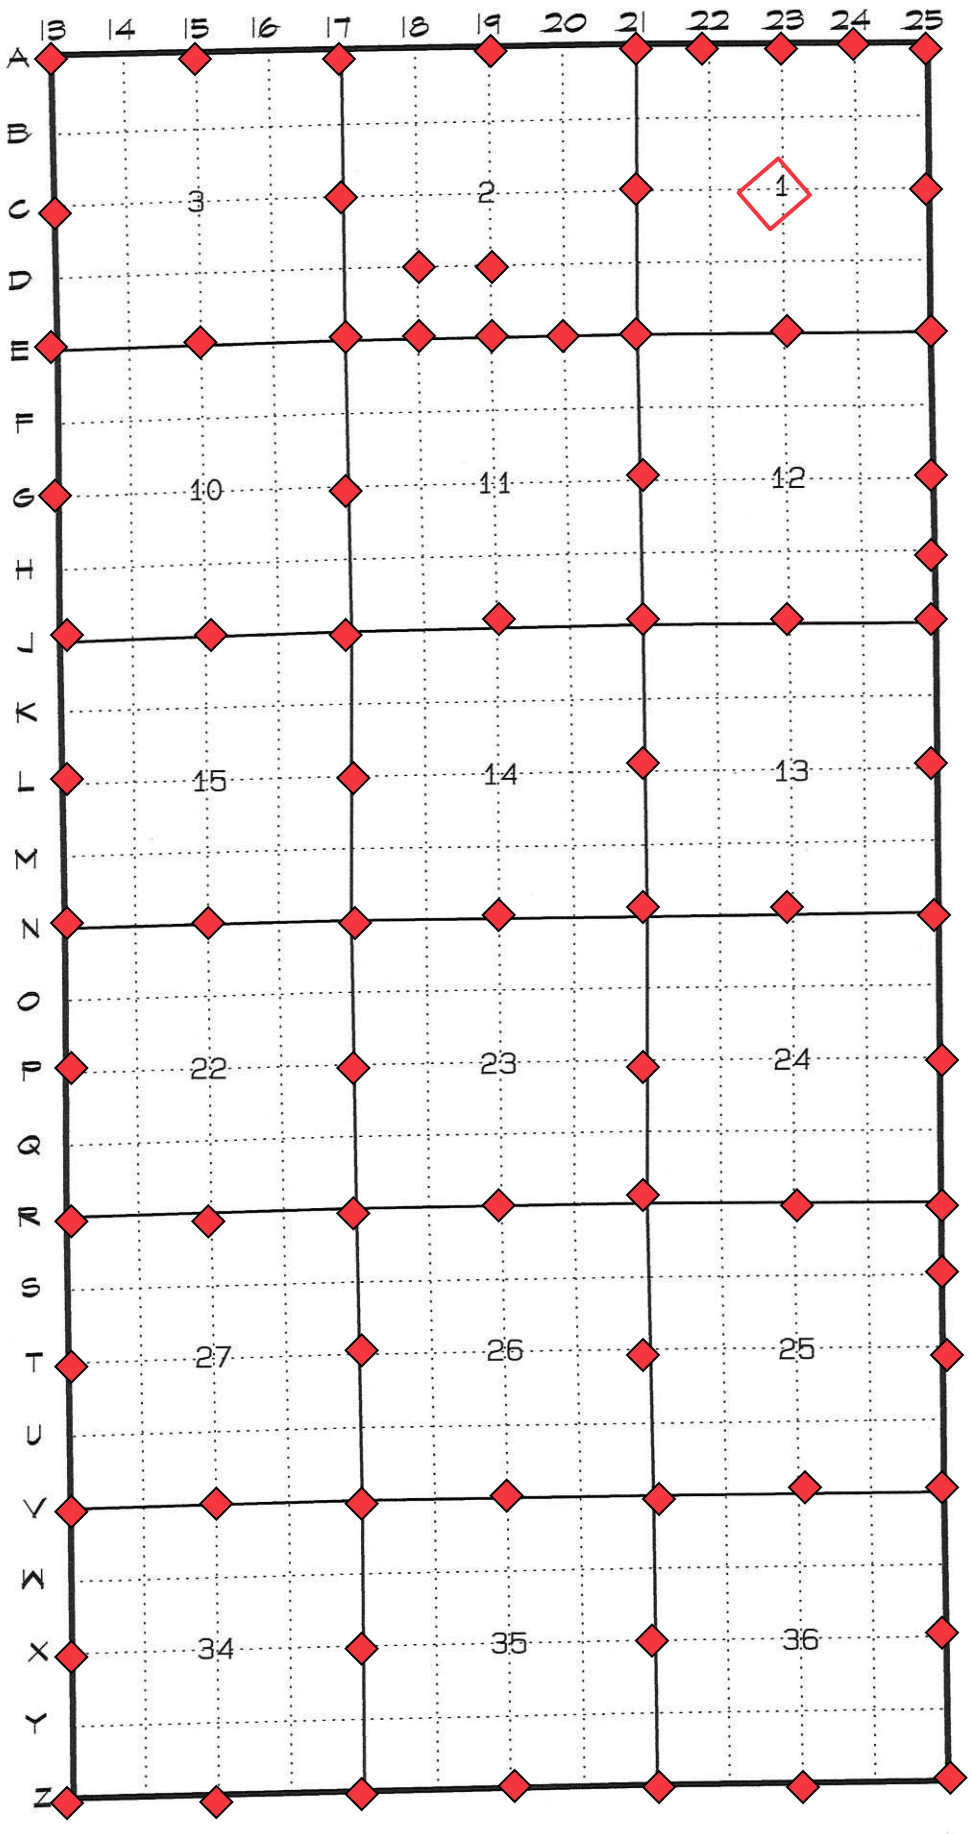TOWNSHIP 3 NORTH RANGE 27 EAST