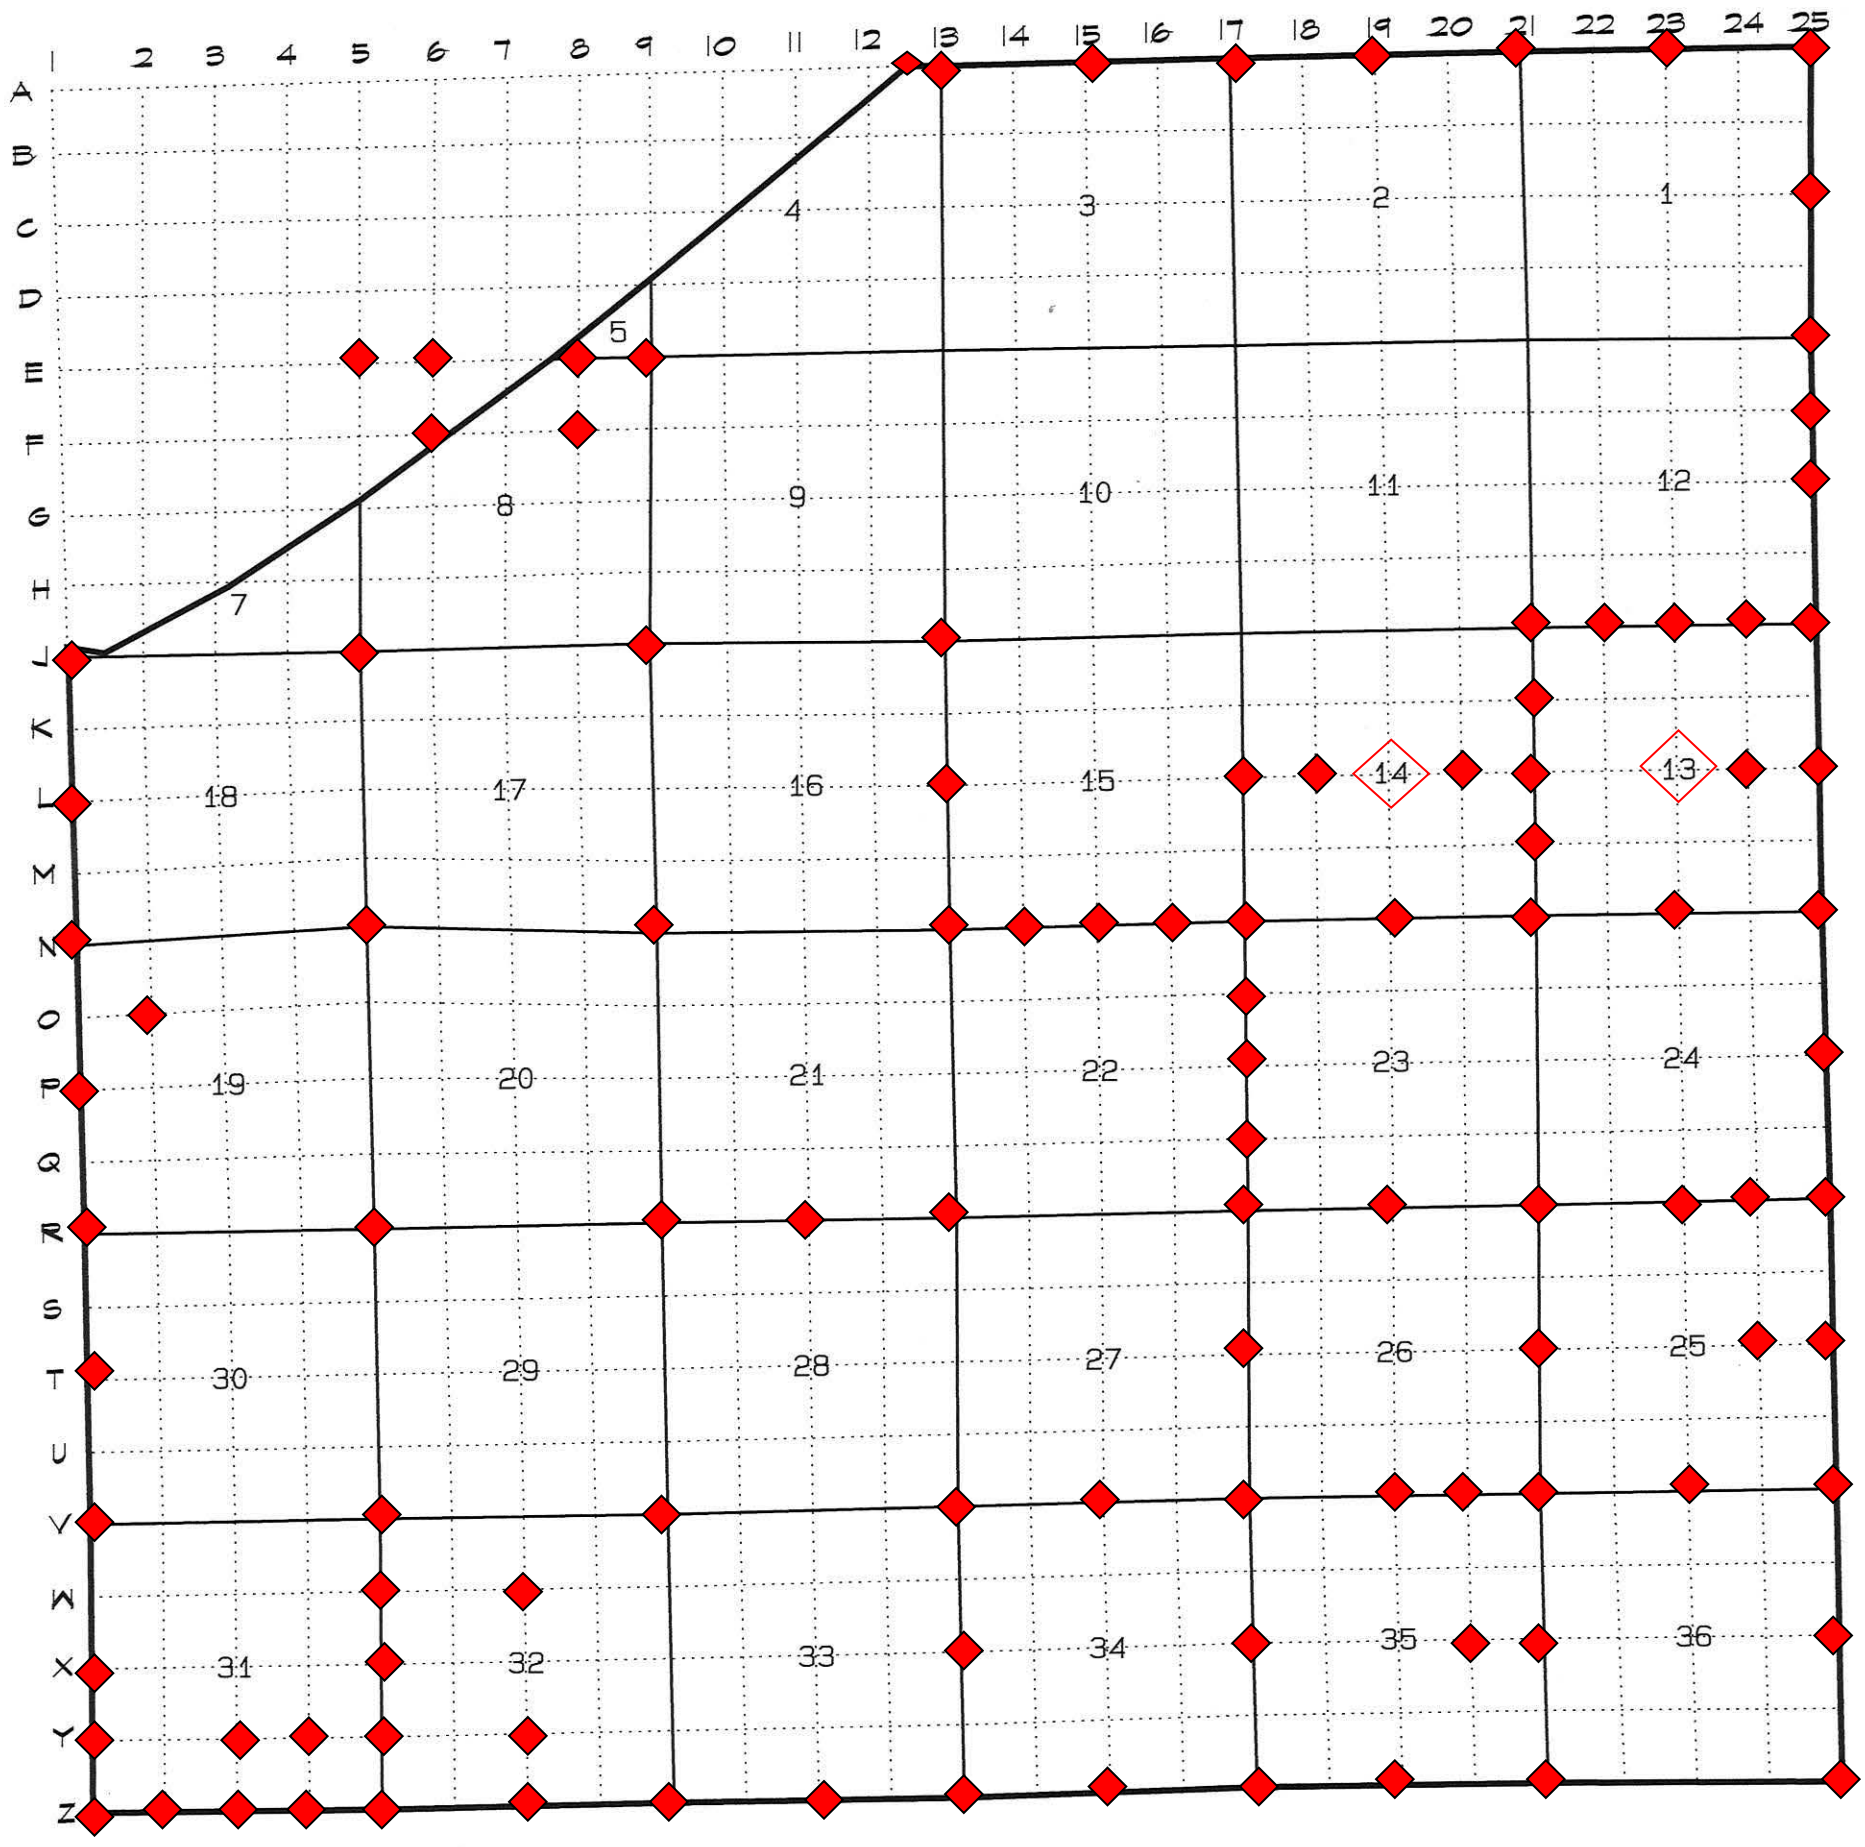TOWNSHIP 5 NORTH RANGE 30 EAST