


Township No 1 North Range No 29 East Willamette Meridian

3885

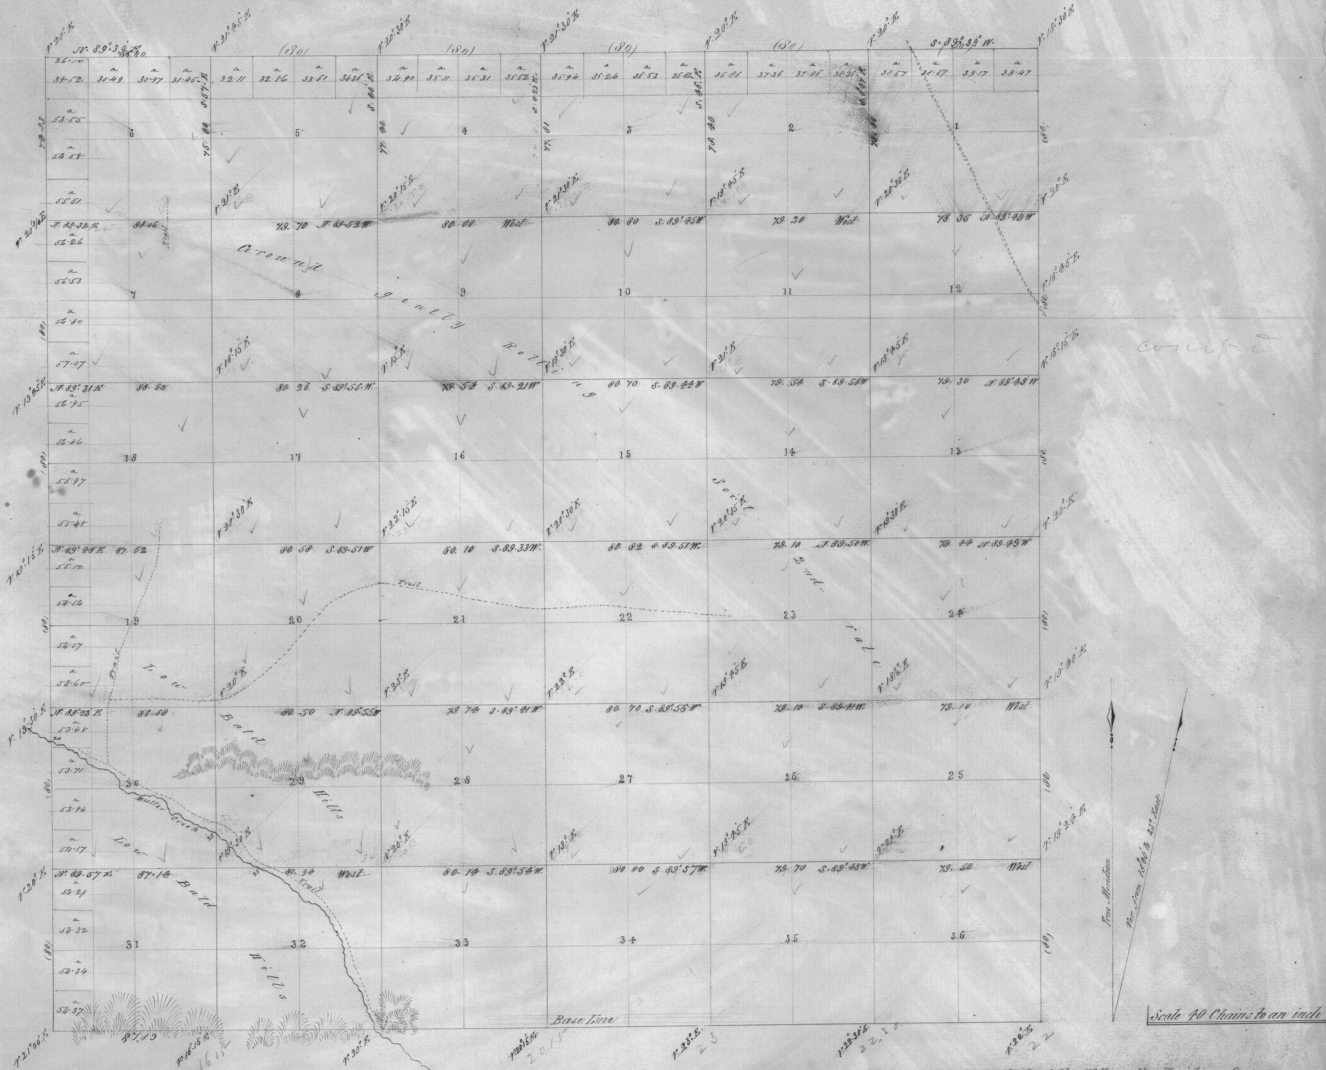

Survey designated	By whom Surveyed	Contract		When Commenced	When Completed
		No.	Date		
Subdivisions	T. L. Corlies	83	May 11th 1860	60 23 56	May 12th 1860
Total number of Acres	23283.36				July 20th 1860

The above Map of Township No 1 North of Range No 29 East of the Willamette Meridian Oregon is strictly conformable to the field notes of the Surveyors on file in this Office which have been examined and approved.

Surveyor General's Office  
 Eugene City July 13th 1860  
 S. W. Chapman