


TOWNSHIP I NORTH, RANGE 33 EAST, OF THE WILLAMETTE MERIDIAN, OREGON

DEPENDENT RESURVEY AND SUBDIVISION OF SECTION 6

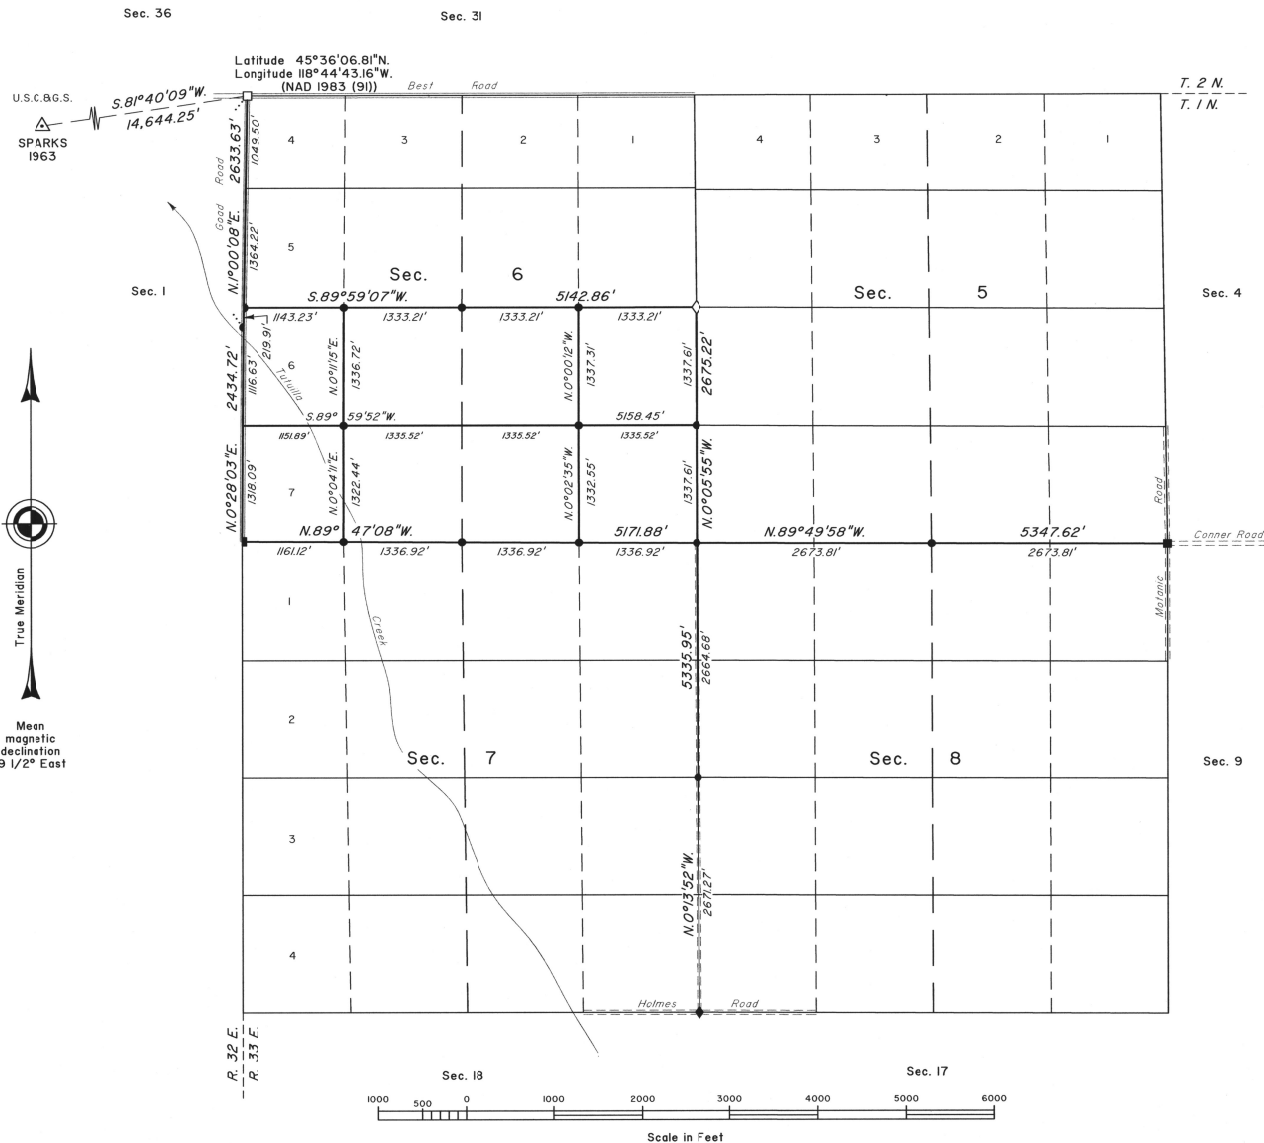

A history of surveys is contained in the field notes.

This plat represents a dependent resurvey of portions of the west boundary, subdivision lines and subdivision-of-section lines of section 6, T. 1 N., R. 33 E., Willamette Meridian, Oregon, designed to restore the corners in their true original locations according to the best available evidence, and the subdivision of a portion of section 6.

Measured distances and directions have been adjusted by Cadastral Measurement Management (CMM), computer software that incorporates a least squares adjustment routine. The adjusted bearings and distances are reported to the nearest second and 0.01 foot.

The lottings and areas are as shown on the plat approved June 14, 1890.

The survey was executed by Bryan S. Seibold, Cadastral Surveyor, beginning April 10, 2000, and completed April 20, 2000, pursuant to Special Instructions dated March 16, 2000, under Group Number 1944, Oregon.

There are no trees.

The tie to the geodetic control station is reported as mean bearing and sea level distance.

LEGEND

- ◊ Original corner previously remonumented
- ◆ Original corner remonumented this survey
- Corner previously restored, established or reestablished
- Corner previously restored, established or reestablished; remonumented this survey
- Corner established or reestablished this survey

UNITED STATES DEPARTMENT OF THE INTERIOR
BUREAU OF LAND MANAGEMENT

Portland, Oregon September 23, 2002

This plat is strictly conformable to the approved field notes, and the survey, having been correctly executed in accordance with the requirements of law and the regulations of this Bureau, is hereby accepted.

For the Director
Mary J. M. Hartzel
Chief Cadastral Surveyor of Oregon