


TOWNSHIP 1 NORTH, RANGE 36 EAST, OF THE WILLAMETTE MERIDIAN, OREGON
 CORNER REMONUMENTATION WITHOUT SURVEY

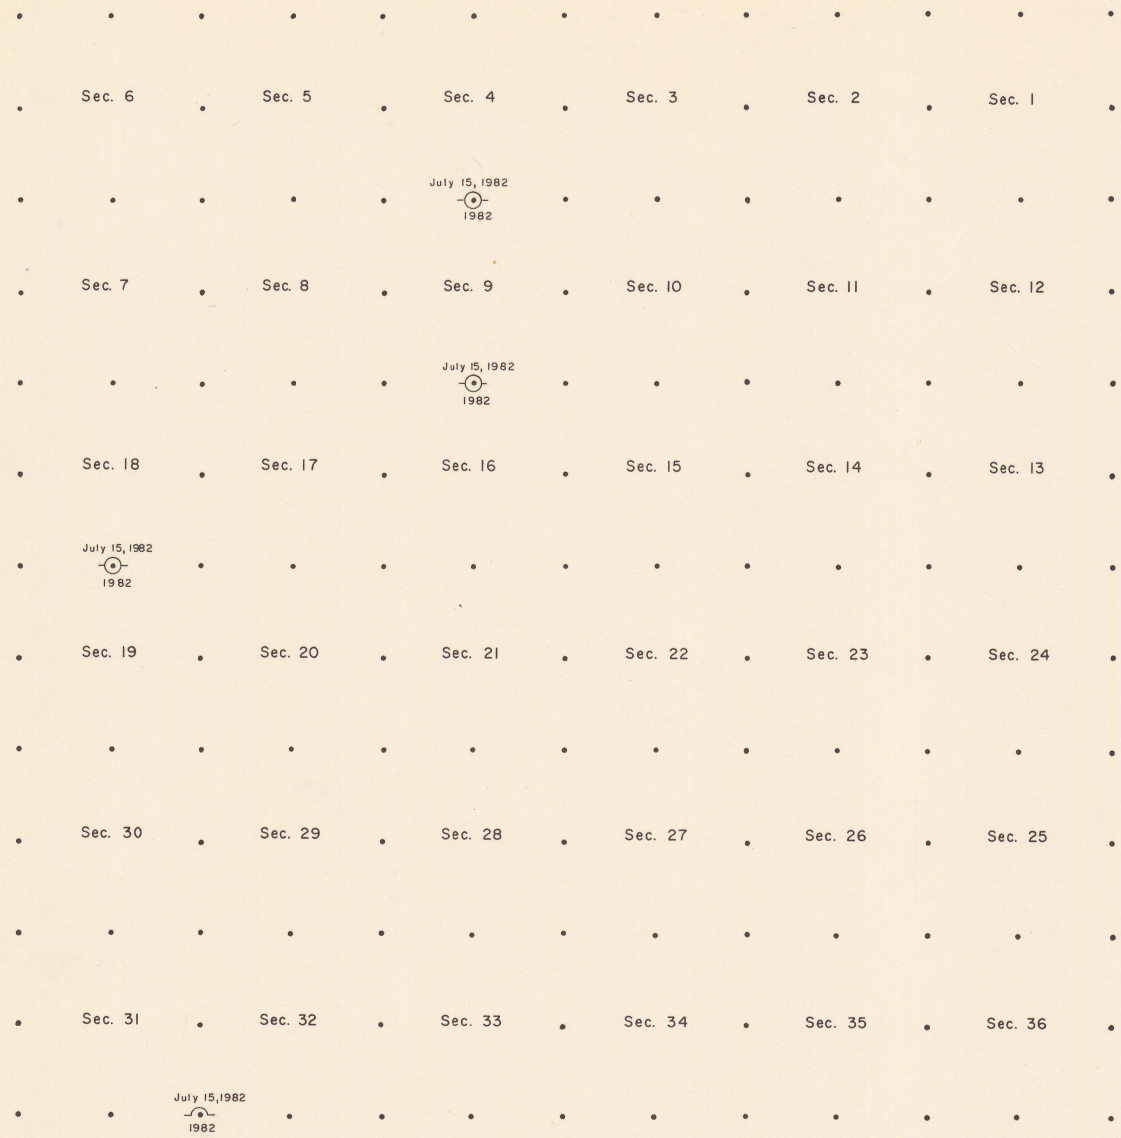

LEGEND

DATE APPROVED



DATE ON CAP



COMMON CORNER



CORNER AS INDICATED

Disclaimer:

This document is not an official survey.
 It serves as an index to corners of the
 Public Land Survey System which have
 been remonumented or rehabilitated.
 Refer to the approved field notes for
 official information.