Supplemental Diagram of Sections, 2, 3, 4, 5, and 6

Township No. 1 South Range No. 31 East of the Willamette Meridian Oregon

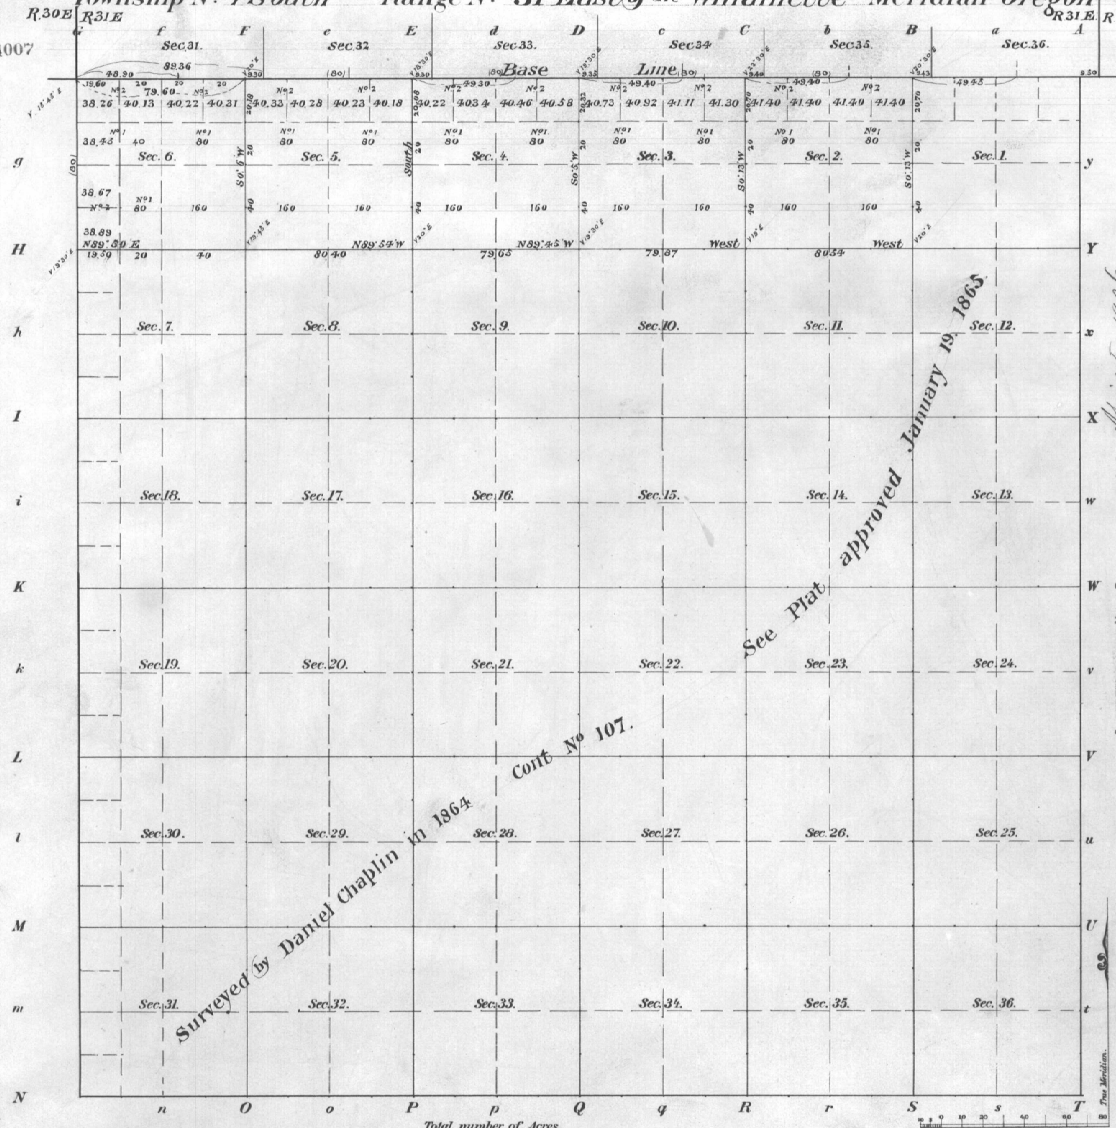

ACCEPTED BY THE HON. COMMISSIONER G. L. O. April 5. 1906

Meanders of								
Posts	Courses	Ch.s Lk.s	Posts	Courses	Ch.s Lk.s	Posts	Courses	Ch.s Lk.s

Surveys Designated	By Whom Surveyed	Date of Contract	Amount of Surveys M. Ch.s Lk.s	When Surveyed	
Township lines					
Subdivisions					

The above Map of Township No. ..... of Range ..... Meridian, ... is strict notes of the survey thereof on file in this Office, which have b

Surveyor General's Office.

The above Supplemental Diagram of Sections 2, 3, 4, 5, and 6, Township No. 1 South, Range No. 31 East of the Willamette Meridian, Oregon, made by order of Hon. Commissioner's Letter "E" dated March 19, 1906 is strictly conformable to the field notes of the survey thereof on file in this Office, which have been examined and approved.

Surveyor-General's Office,
Portland, Oregon March 28, 1906

Jno D Daly
Surveyor-General for Oregon

JW