


4075

Area	
Sections	Acres

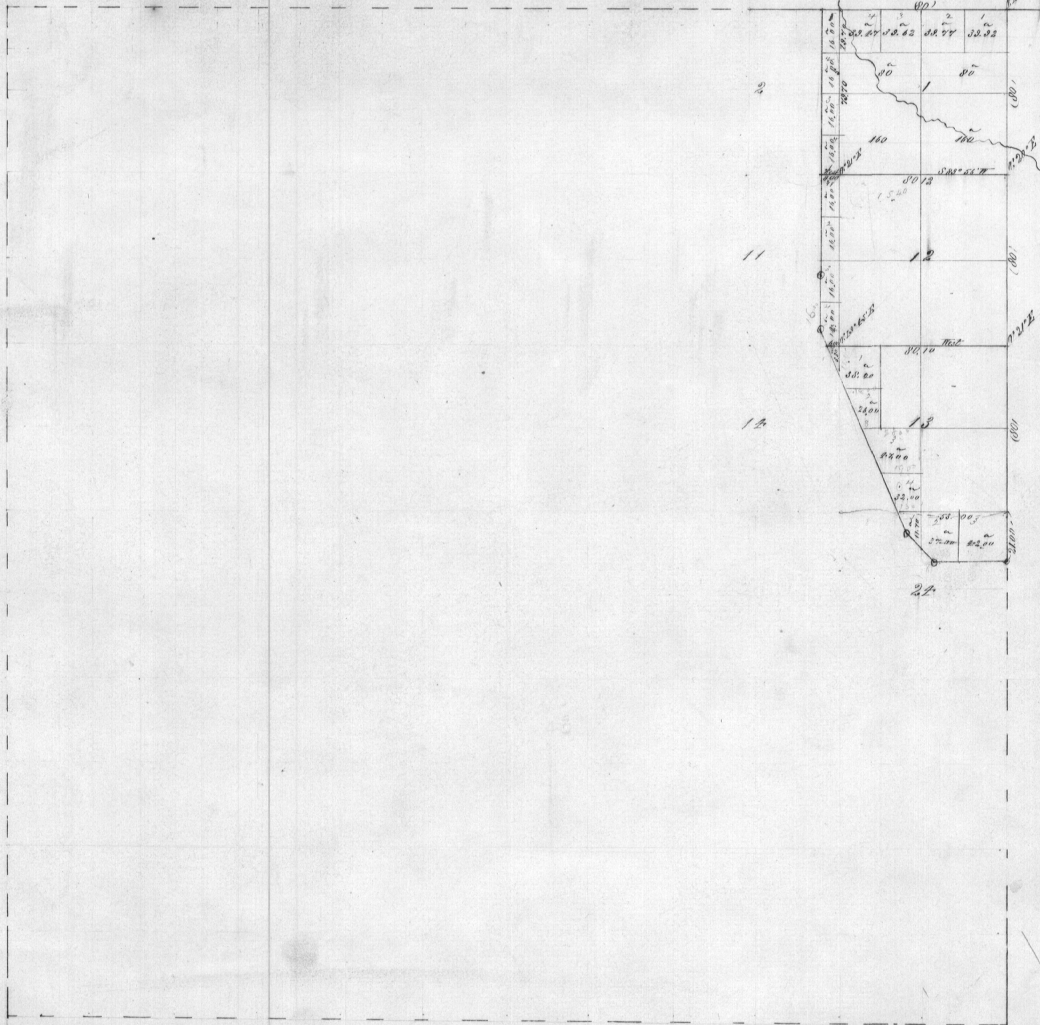

7960  
2676  
5284

Series	Contractor	No	City	Date	Amount Survey Area Chain & C	Commenced	Completed
Subdivisions	James Schady	14	Colorado	4/1877	5 00 00	Nov 8 1877	Nov 8 1877

The above Map of Part of T 1 S E 32 East - T 11 S R 32 E within  
the Unsettled Indian Reservation is strictly conformable to the  
original field notes of the survey thereon file in this  
Office which have been examined and approved,  
Deputy Records Office  
Eugene City June 27 1892  
W. H. Collett  
Surveyor General