4077

Township No. 2 South Range No. 32 East Willamette Meridian

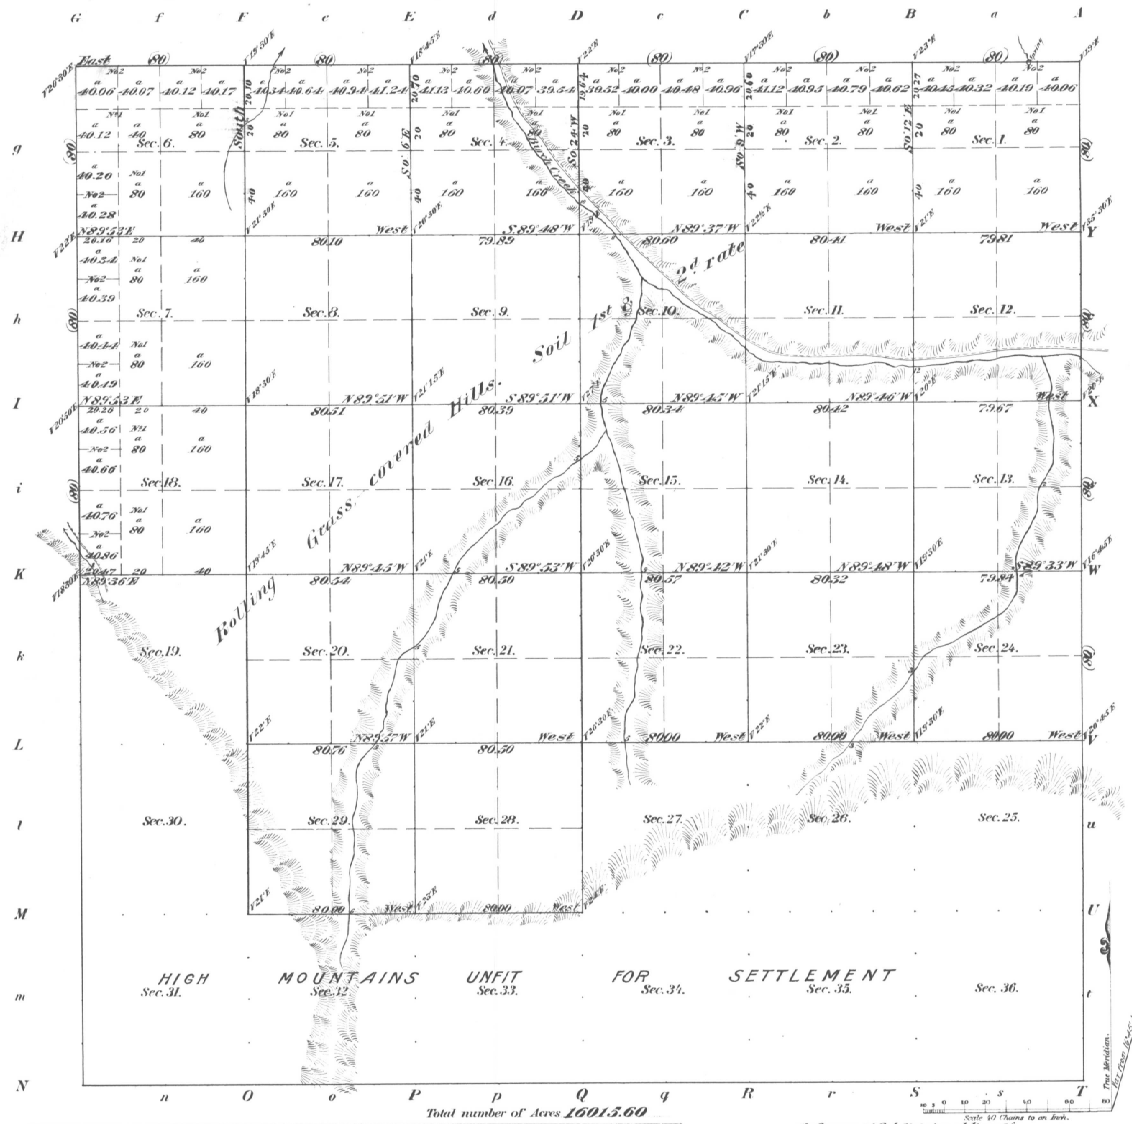

Total number of Acres 16013.60

Surveys Designated	By Whom Surveyed	Date of Contract	Amount of Surveys M.	Chs	Lks	When Surveyed	No. of Contract.
Township lines Subdivisions	Daniel Chaplin	Sept 21st 1864	448.	07.	37.	Nov. 27th 1864	107

Meanders of

Posts	Courses	Ch's Lks	Posts	Courses	Ch's Lks	Posts	Courses	Ch's Lks

The above Map of Township No. 2 South, Range No. 32 East of the Willamette Meridian, Oregon, is a true and correct copy of the original Map on file in this Office

U.S. Surveyor General's Office
Portland, Oregon, Nov. 7. 1906

Jno. D. Dale
Sur. Gen'l for Oregon

The Survey of Subdivisional lines of

The above Map of Township No. 2 South of Range No. 32 East Willamette Meridian Oregon is strictly conformable to the field notes of the survey thereof on file in this office, which have been examined and approved.

Surveyor General's Office
Eugene City, Jan 23d 1865

B. J. Pengra
Sur. Gen'l of Oregon

S.C.