


**SECTION 14
T. 4 N., R. 28 E.W.M.**
Scale 1 inch = 200 feet.

Note: Location of Railroad as scaled from C.W.R. & N. Co. Right of way map shown in red.

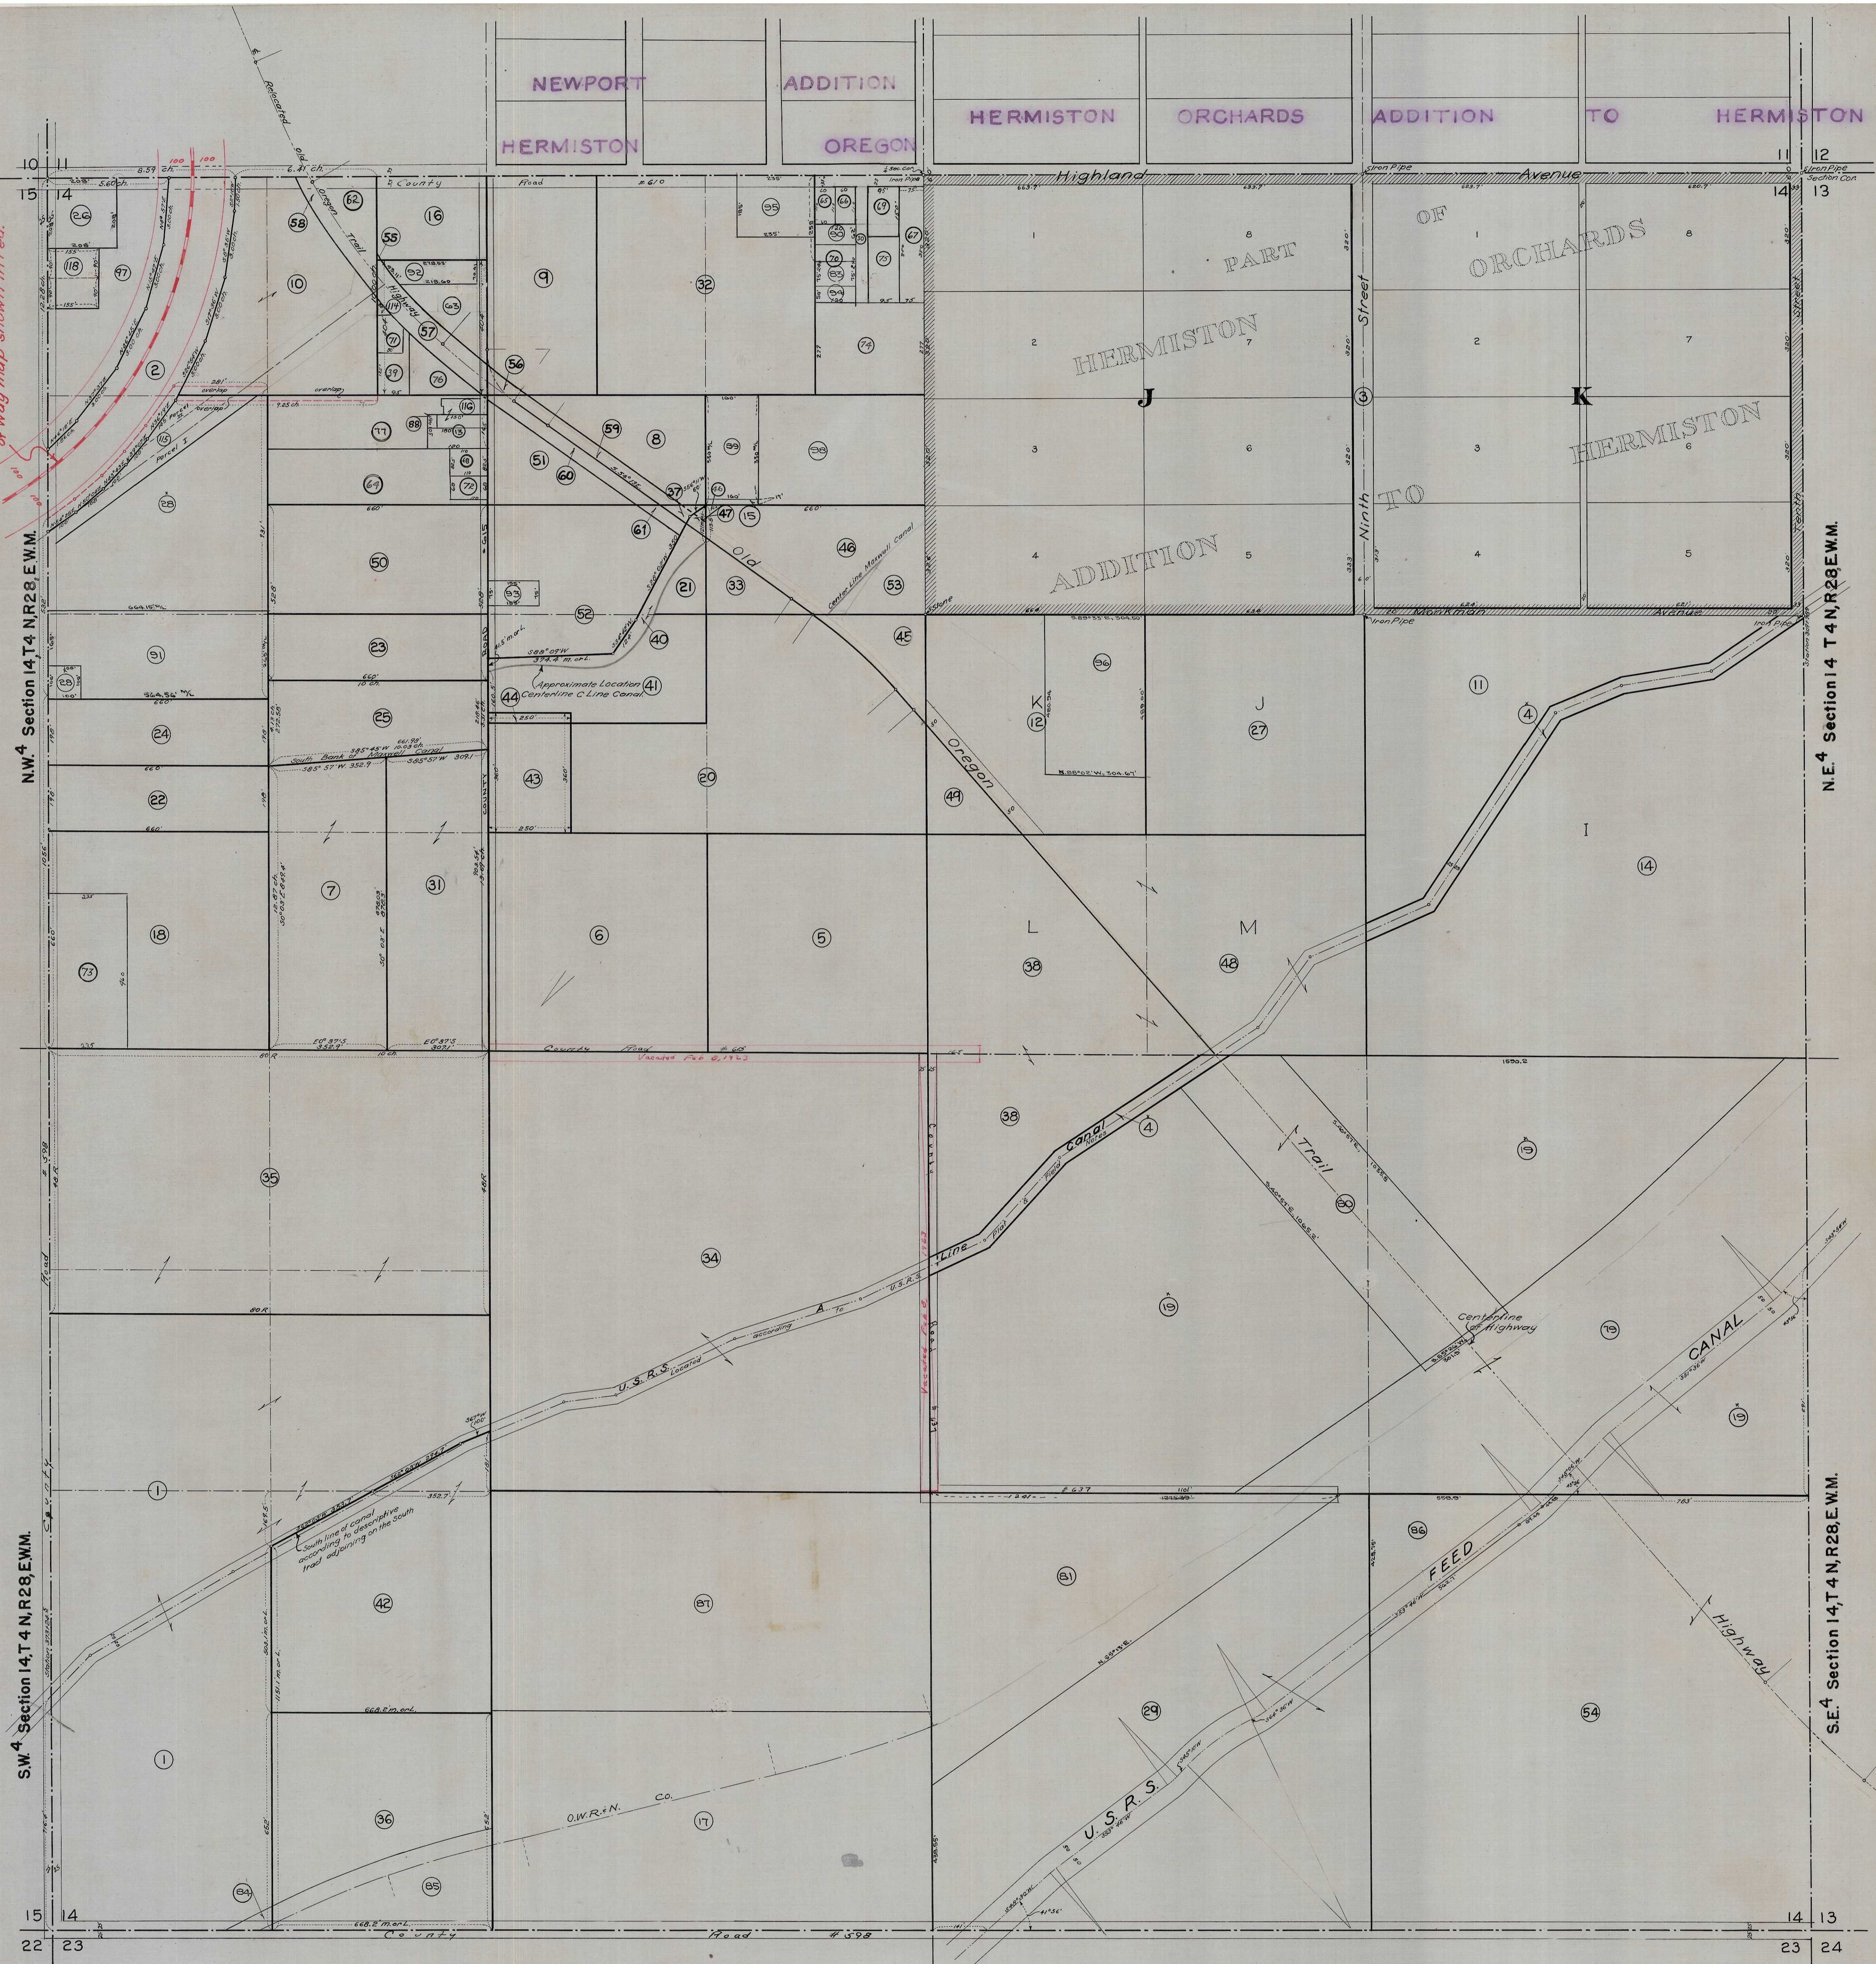

27