


H-L34

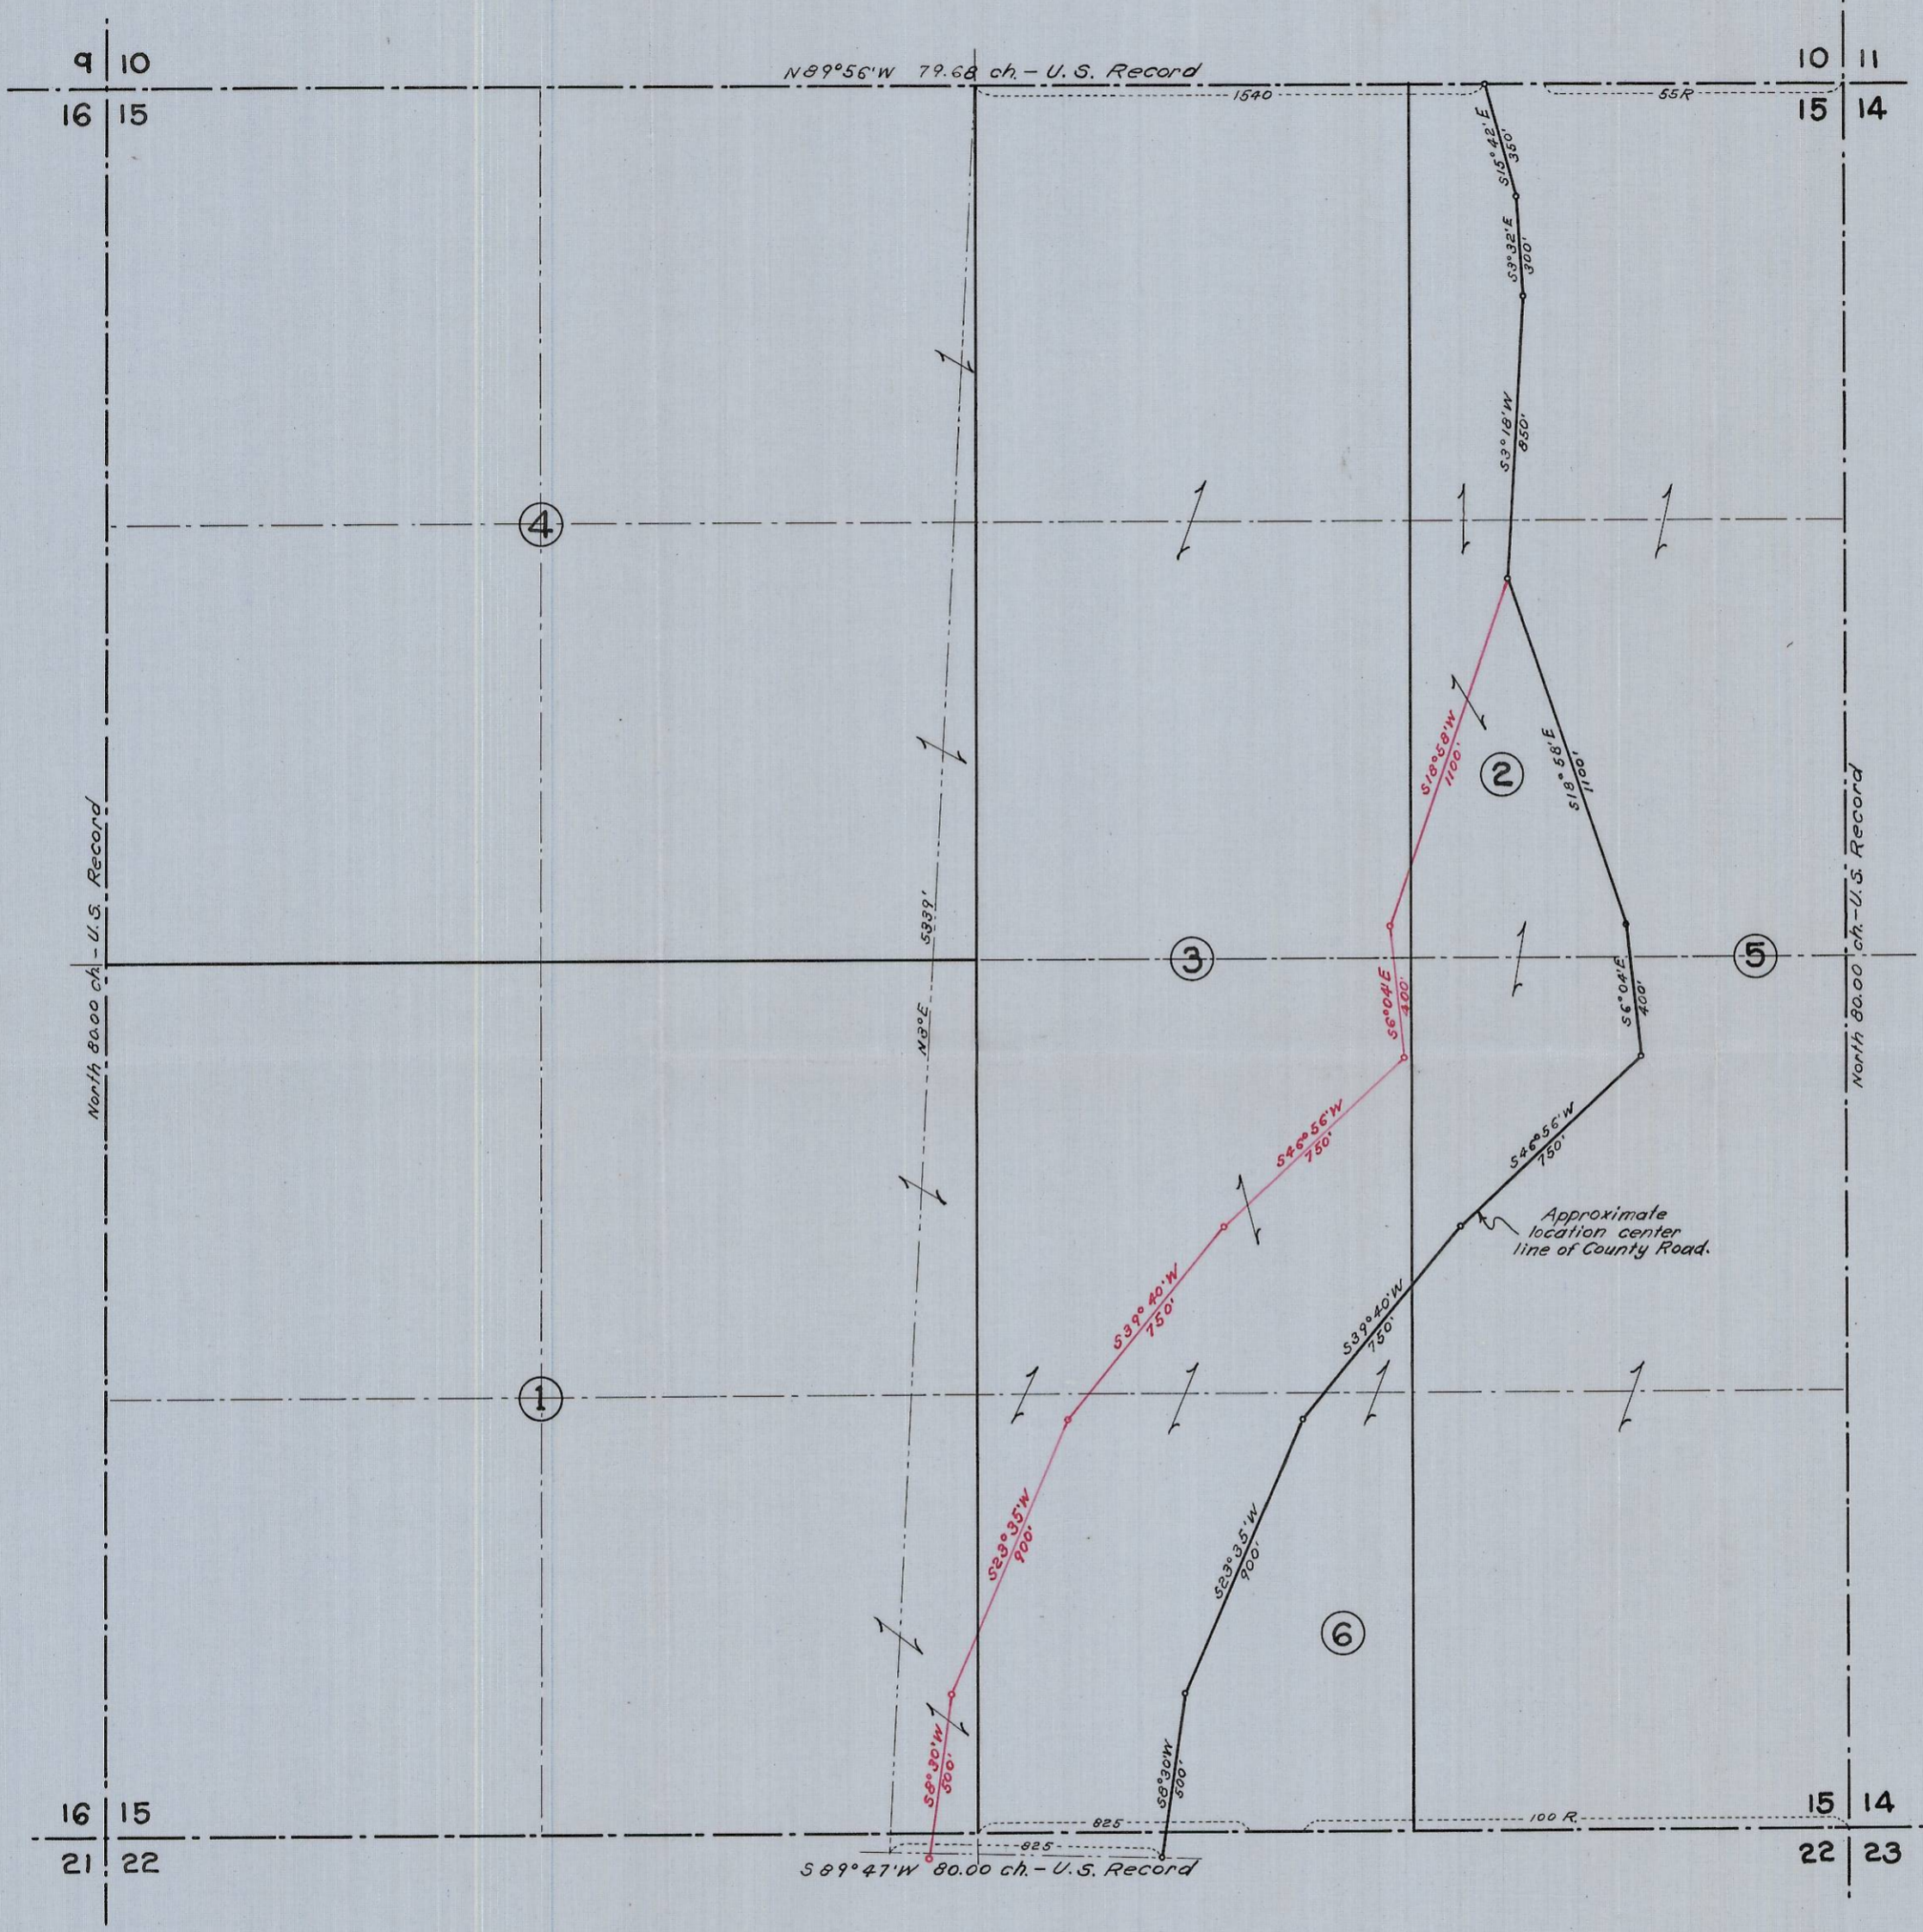

Section 15  
 T.5 N., R.36 E. W.M.  
 Scale 1 inch = 500 feet.