


H-120

H-120

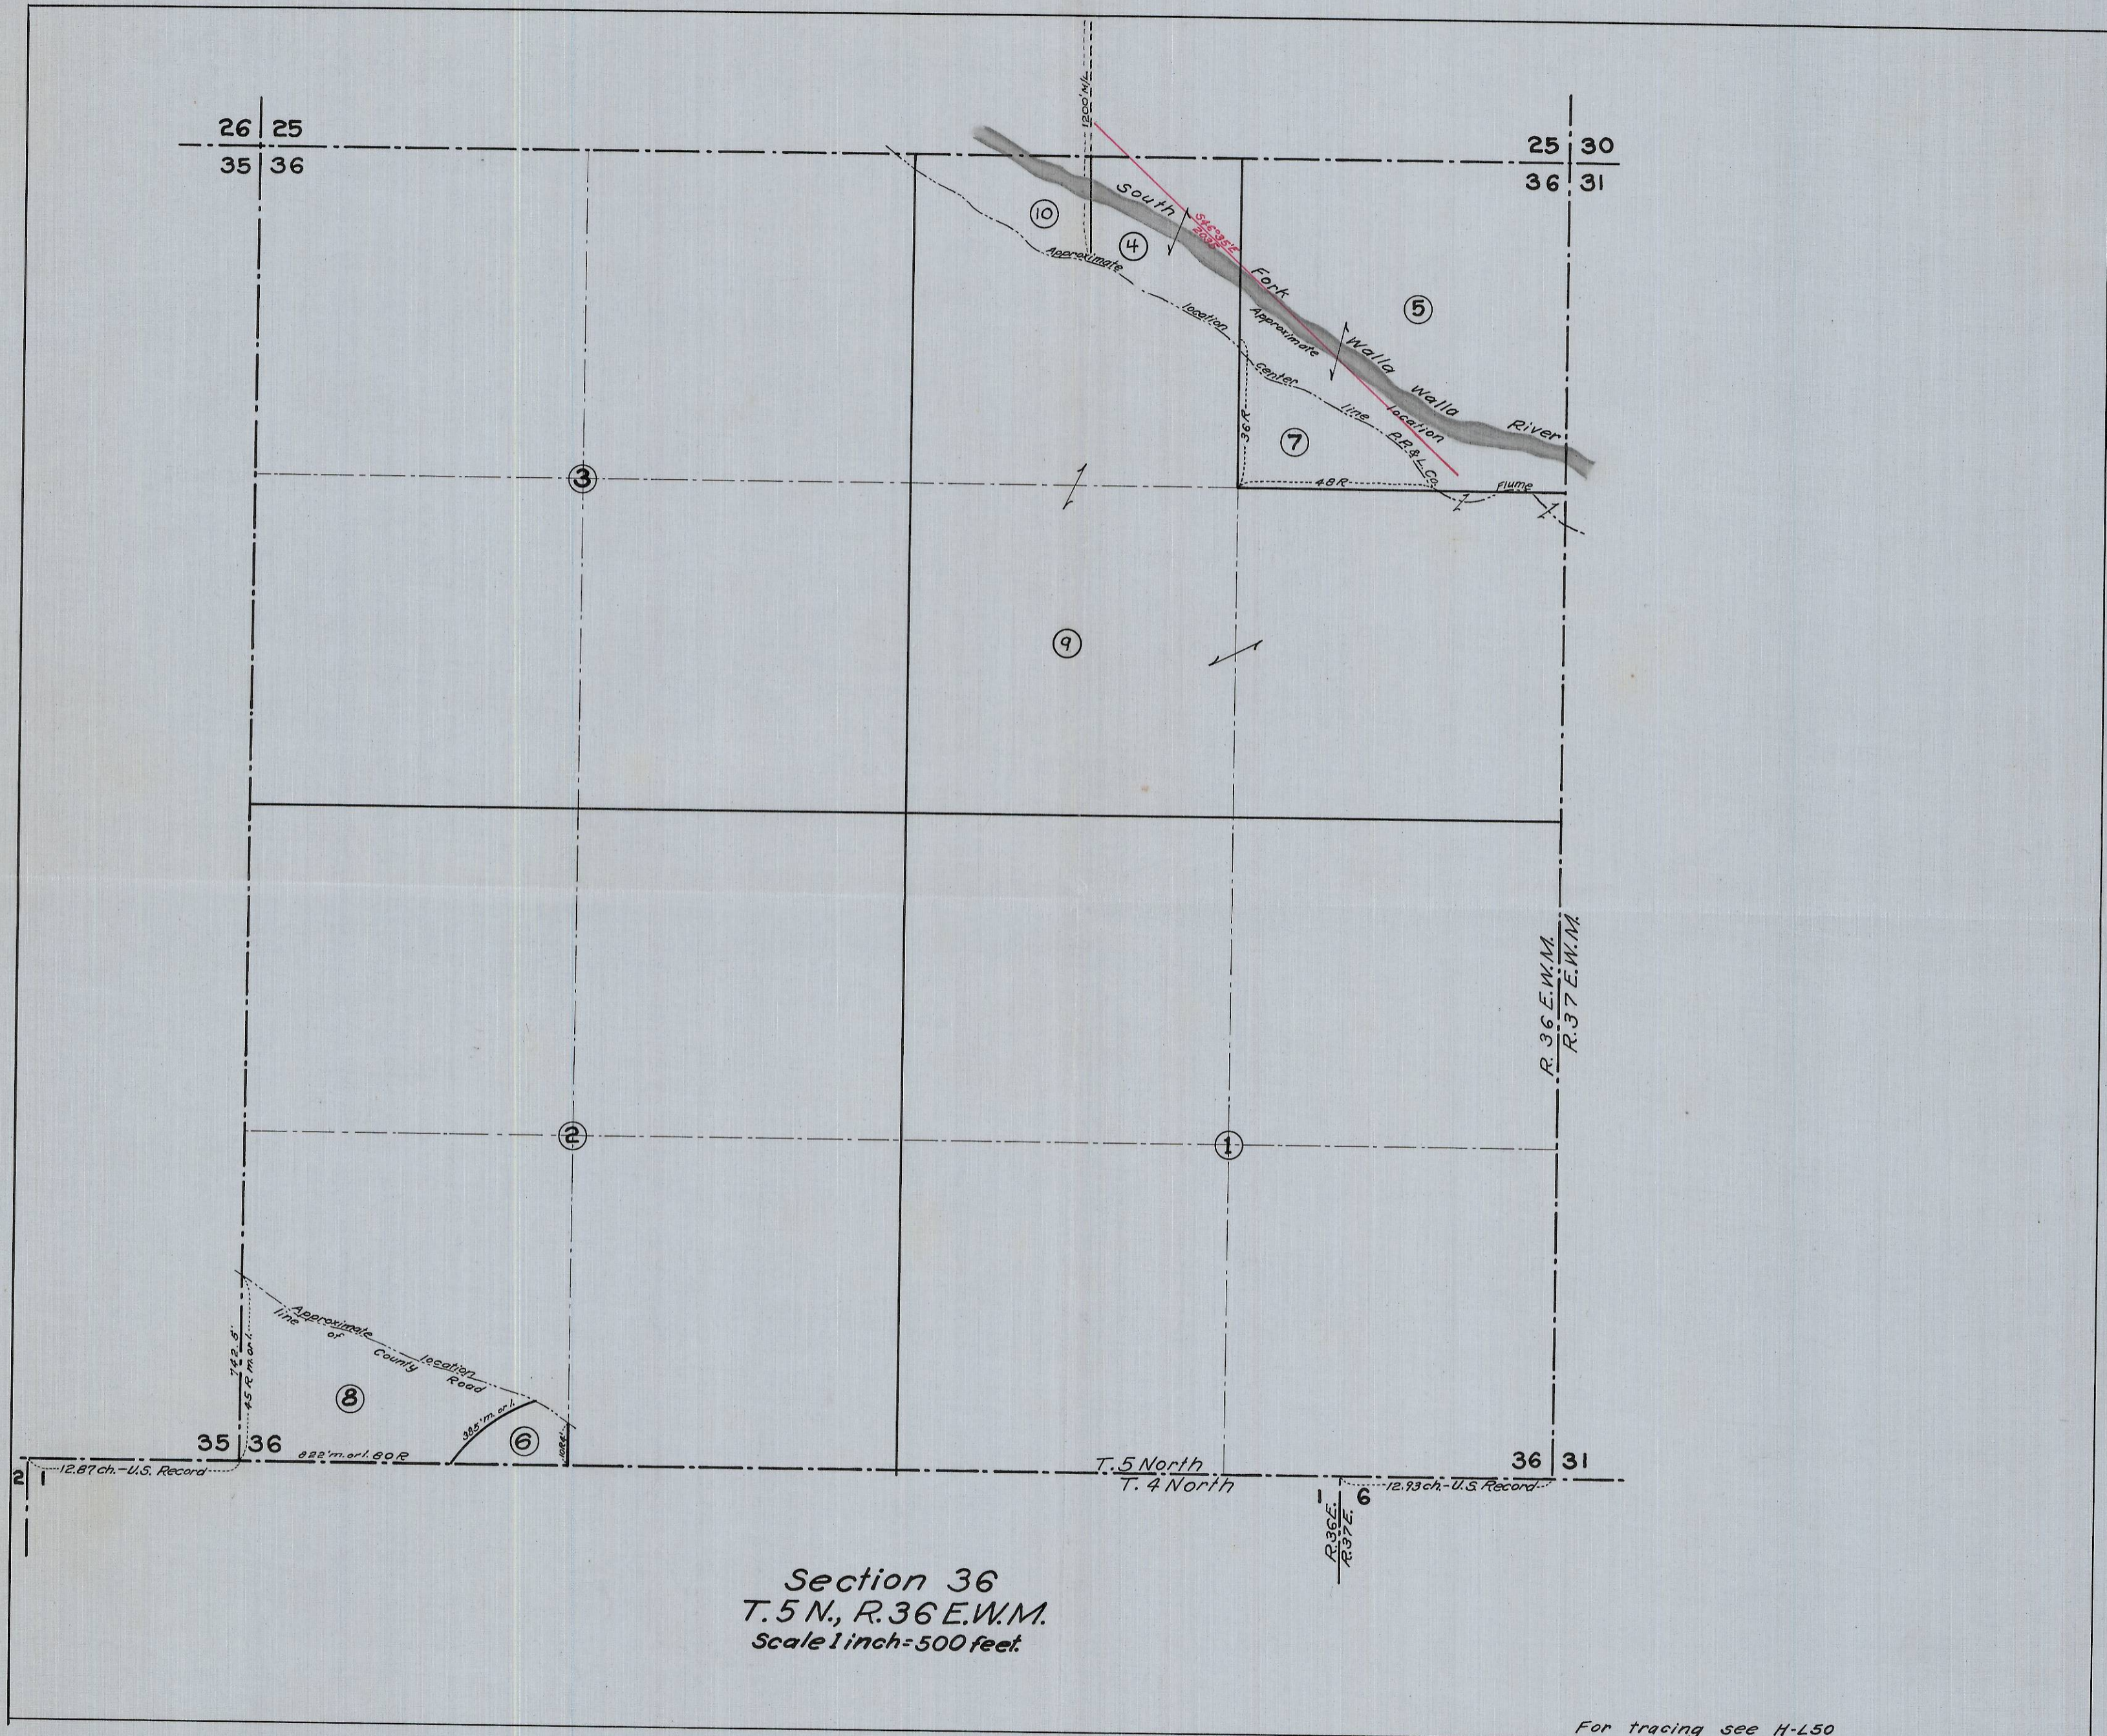

Section 36  
 T.5 N., R.36 E.W.M.  
 Scale 1 inch = 500 feet.

For tracing see H-150

294

H-120

H-120