

PLAT AND RECORD OF SURVEY No. 6

C. C. Brown

Survey of Acres in T. 5 N. R. 35 E.
July 30, 1880Commenced survey by
setting on acknowledged Gov. Cor. at
S.E. Cor. of Sec. 2, from thence I
run Var 21° East.North - - 4000 Intersect Gov. 1/4 post mound and pile
being visible - for better proof I dug
up end of charred stakes coal. etc,
to perpetuate the same I set a
a Basalt rock and raised a mound
of Stone," - - 81 00 I intersect Gov. post at the N.E. corner
of Sec. 2, set Basalt rock raised
a mound of Stone etc, from which
I run on a line of Sec. 2West . . . 40 00 Intersect Gov. Cor. with Post Mound and
pile plainly visibleWest . . . 50 00 Intersect A + B line at Gov. Corner. being the
A + B Cor. of Sec. 2. Returned to 1/4 post on
North line of Sec. 2 and run South through
the center of the Section At

South . . . 40 00 Set temp. 1/4 in center of Sec. 2

" . . . 51 08 Intersect E + W line 61 links west of Gov.
1/4 post As evidence I dug up end of the
charred post - noted witness holes &c. Witness
C. C. Brown J. B. Kunkland - to perpetuate the
same, I set post, dug pits + raised mound
my correction for temp. Center post is 30 1/2 links
East. To E. S. W. Cor. of Sec. 2, said corner
being obliterated I set on Gov. 1/4 post on
the South line of the section which

O & B Brown Continued

Course.	Degrees.	Minutes.	Chains.	Links.
---------	----------	----------	---------	--------

I Run *Var* $21^{\circ} 30'$ East

West	40 00	
------	-----	-----	-------	--

And set temp cor for Secs 2, 3, 10 + 11

"	80 00	
---	-----	-----	-------	--

intersect N + S line at 48 links North of the Gov post. My correction is $21\frac{1}{2}$ links South for cor to Secs 2, 3, 10 + 11

I returned and made this correction after which I went to the S W cor. of Sec 11 it being the nearest visible Gov. cor. In proof of this corner I dug up End of charred stake. (note pile + dedication of mound). From which I Run

North	80 00	
-------	-----	-----	-------	--

+ set temp cor for Sec 2, 3, 10 + 11 + continued

North	80 00	
-------	-----	-----	-------	--

cut. E + W line 1.19 West of Gov. corner

My correction for the S W cor of Sec 2 is $59\frac{1}{2}$ links East of my temp corner

I returned to temp cor. of Secs 2, 3, 10 + 11 + set permanent post at the intersection of the two intersected corrected lines. Set post raised mounds + dug pits. From which I Run

North	40 00	
-------	-----	-----	-------	--

And set temp $\frac{1}{4}$ post on the west line of Sec 2.

North	80 00	
-------	-----	-----	-------	--

intersect East + West line 1 Chain West of the Gov. corner. Hence my correction for temp $\frac{1}{4}$ post is 50 links to the East. I returned and made this correction + set permanent $\frac{1}{4}$ post on a true line between the two sec corners at a point equidistant from each from which I went to the $\frac{1}{4}$ post on the East line of Sec 2 and run West through the Sec for the purpose of establishing a permanent quarter post.


PLAT AND RECORD OF SURVEY No. 6

Course	Degrees	Minutes	Chains	Links
West	...	20
...	...	31

J. C. Brown Coast.

Set temp center post
 I intersect N+S line 47 links south
 of East 1/2 post on the west line hence
 my correction for the east post on E+W line
 is 38 1/2 links North I returned to center
 + Set permanent Cor of the intersection
 of the two corrected lines. Buried Basalt
 rock marked x - raised mound of Stone +
 dug pits. Cor. Cornus were found lines
 run + Cornus established in accordance with
 the above notes + with the following Plat.

J. S. N. R. B. S. E.
 A.

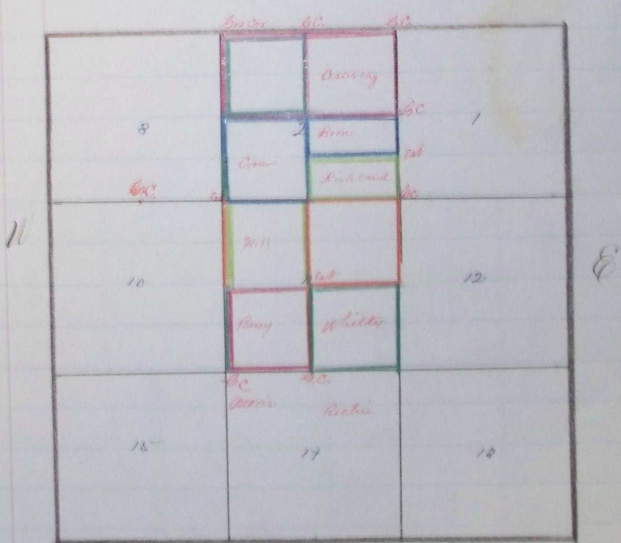

I hereby certify that the above notes + Plat are correct
 as by me obtained. Jan. 21. 1880

J. H. Kiser
 Deputy Surveyor