

PLAT AND RECORD OF SURVEY No. 71

Subdivision of Sec 10 T5 N.
Range 35 East of W.M.

Commencing at the N.E. corner
of Sec 10 T5 N.R. 35 E. of Wm
from which we run South
Set 1/4 Post

Course	Degrees	Minutes	Chains	Links
South	8	30	41	00
"	"	"	82	00
W.S.	9	23	40	25
"	"	"	80	50
North	30	"	39	60
"	"	"	79	20
E. 1/4	23	"	39	75
"	"	"	79	75

Sec corner 10. 11. 14 & 15

from which we run
Set 1/4 Post

Sec corner to 9. 10. 15 & 16

thence

Set 1/4 Sec Post

Set Sec corner to Secs 3. 4. 9 & 10

from which we run

Set corner for 1/4 Sec

Intersect place of beginning
and planted stone corner


Chas Hansen

Chris Hansen

George Knoles

T. 5 N. R. 35 E of W M

Sec 10

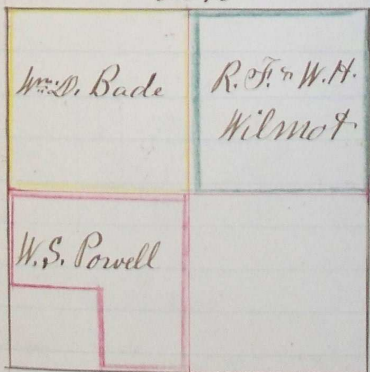

I hereby certify that

the above is a true and correct survey
and plat of the above named land
this 20th day of Dec, 1883
J. C. Coffey
County Surveyor