


PLAT AND RECORD OF SURVEY No. 63 19

By Request of R. Marvin Turner Aug the 1st 1894

To locate line on East boundary of N.E. 1/4 Sec 12 in S. 2. N. R. 32. E. W. 1/4

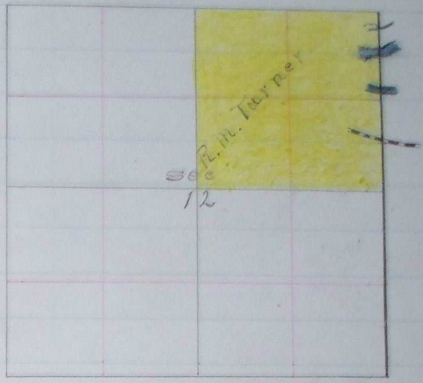

I Comenced at the 1/4 Sec corner on East Boundary Sec. 12 which is a fence Post set in corner point by Mr. Hebb owner of the S. E. 1/4 Sec. 12

Thence I run north on Range line bet R. 32 & 33 E on East Boundary Sec 12

Var 20° 25' E.

Ascend

- 10 50 O.P. 2nd N. Rail Road course N. 80° W. S. 80° E.
- 21 46 Slough 40 Yds wide course W.
- 30 00 Umahilla River 150 Yds wide course S 80° W
- 34 50 north bank of Slough dry 35 Yds W of dam for logging ditch
- 40 45 Intersect - 31 Yds west tree corner for Sect 1st 12

from which

- a Balm 5 ins dia tree N 26° 46' E 32 Yds dist
- " 5 ins " " N 70° W 15 " "
- " 4 " " " S 52° W 12 " "

Thence S 0 26' W on True line

- 6 45 Slough, and dam 5 Yds East of line
- 8 70 Umahilla River course S 80° W
- 10 45 South Bank of Umahilla River

40 45 the 1/4 Sec corner
 being 16 inch dia chainman
 R. M. Turner

John W. Kirtland
 County Surveyor