

PLAT AND RECORD OF SURVEY No. 67

Surveyed for John Rhodes

Course. Degrees. Minutes. Chains. Links.

Dec 6th 1894I Commenced at the 4th Sec cornerSet Sec 15th and 14

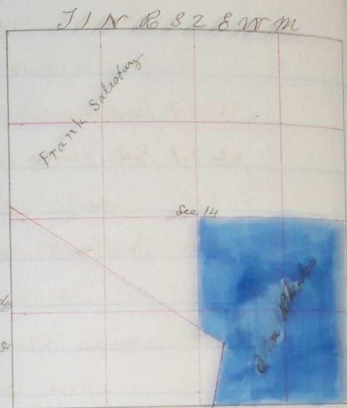
Thence West through center Sec 14

Var $21^{\circ}30' E$

33 40 Mackay creek 100 yds wide runs North

40 50 Set temporary 1/4 corner for center Sec 14

75 55 Unsettled Indian Reservation West boundary

79 95 Intersect 20th N. of 4th Sec on father's lineN $89^{\circ}58'15''$ on true lineI commenced at the 4th Sec cor. at Sec 14 823

Thence North through center Sec 14

Var $21^{\circ}30' E$ 15 96 Intersect U. S. body course N $85^{\circ} W$ Set temporary transitional cor.

38 46 Intersect Town E. & W. line 10 yds East of the first temporary corner

68 00 Shift the left or west bank of Mackay creek runs N

78 53 Intersect 20 yds East of the 4th Sec stone as represented by parties

owning the land as where they first saw it - 3 years ago

But from its close proximity to grove and thick brush

I know that it originally stood as set by Government

surveyor some distance East I should judge more than 20 yds

But as there had been fencing and blowing done since I

saw the corner 4 years ago I could not designate

the exact point. I therefore retraced the line between 11th and 12th

and find the stone as it stands to be within 60 yds of the

center bet the Sec corners and on line, and as the

settlers all are apparently satisfied and have built

their fences to correspond with it as standing I

there fore leave it and proceed to subdivide

the section from it -

Line	Begin	End	Date	Links
				Thence Iron
				So 17° 6' on true line through center Sec 14
40	07			Set Stone 22 x 12 x 12 for 1/4 corner in center Sec 14 NW 1/4 and N of Stone
62	57			Set Stone 15 x 6 x 5 for fractional corner on N E Bdy
				Thence S 55° E
8	46			1/4 the 93 mile corner Stone in ground of Stone on N E Bdy
				Thence S 55° E
8	50			angle 47 on N E Bdy
				Thence S 10° W
13	13			To the closing corner bet Sec 14 & 23 300 lks East of the
				1/4 Sec corner bet Sec 14 & 23

Ed Lichtenwaller Chairman
 Gary Kimbrell Hagman
 Ed Bent Chairman
 John W Kimbrell
 County Surveyor

Note This survey should be on page 287 following that of J. G. Whitmore John Edth and Newman societies

From 1895
 Right of way for John Coffey and John H. Cress in Sec 29 S 2 N R 32 E W 3 M
 commencing at a point - N 65° 36' E 287 chains distant from the SW corner of the
 1/4 of the 25' 45' Sec. 29 S 2 N R 32 E W 3 M
 thence N 30° 15' W 113 ch thence N 20° 15' E 336 chains thence N 44° 45' E 235 ch
 thence N 25° E 175 chains to & S W line between the lands of John Coffey
 and E. F. Strangher John W Kimbrell Sub 2.