


PLAT AND RECORD OF SURVEY No. 71

Surveyed for Clifton and Boyd

February the 18 1895

I Commenced at the corner
to Secs 7-8-17 and 18
which is a Stone 22x17x5
Original Gov Corner
Thence East on prairie
line bet Secs 8 & 17
Var 21° E

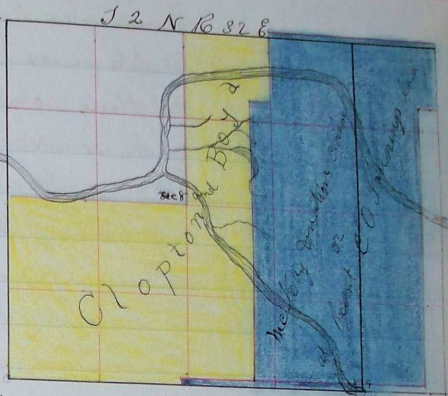

Note I find after measuring this survey that I had made a mistake in the corner to Secs 7-8-17 & 18
 by calling on the original corner in place of the true corner which is 50 lbs East of said witness corner and
 I made on Sept 15 1895 and rechecked the line East from the NW corner to the NW corner as best I could by
 a line of iron in 1897 which I find to be 25 lbs South and 80 lbs West of the Original NW corner of the Donation as set by U.S. Survey
 on that day in 1877 I therefore leave all corners as I set them from 1877
 for the statements of Matthew H. B. through Sec 8 J 2 N 16 32 E
 for Matthew H. B.

- 38 70 a point 75 lbs South of NW
Corner of Unalaska Indian
reservation as set by Nolan and Curin in 1857
- 39 20 a Point 22 lbs North of Closing corner bet Secs 8 & 17 on west side of U.R.
- 39 59 a Point 100 lbs South of Z.F. Moody's NW cor of U.R.
- 40 00 could find NW 1/4 Sec corner set temporary 1/4 Sec cor
- 42 70 a Point 28 lbs North of Nolan and Curin's 1/4 Sec corner
- 56 09 set temporary stake 78 lbs North of line for SW cor of McKay Donation
- 68 48 Gulch course N 8
- 76 33 left bank of McKay creek turns NW
- 79 80 Intersect 55 lbs North of the corner to Secs 8-9-16 & 17
in New channel of McKay creek
from which witness corner.
a Balin 24 ins dia for N 82° W 170 lbs dist.
" 18 " " " S 42° E 111 " "
- 24 48 set Stone 24x18x6 for SW corner of McLoy Donation claim
100 lbs North of Sec line bet Sec 8 & 17
- 39 90 set Stone 16x6x5 for 1/4 Sec corner bet Secs 8 & 17
- 79 80 The corner to Secs 7-8-17 & 18

Commencing at the NW corner of McLoy Donation 100 lbs
North of line bet Secs 8 & 17 which is the Original corner
Mound plainly visible But Post gone I dig down
in center of mound and find the lower end of old stake

PLAT AND RECORD OF SURVEY No. 7119

By Request of F. B. Upton & E. S. Boyd.

Sept the 14th 1875-

In the Purpose of Correcting the Records of Survey No. 711 on Page 293 made February the 18th 1875 see Marginal Notes on Page 293 Retraiment

I commenced at Nolan & Carrins NW corner of Unalaska Indian Reservation which is a line in honor of Garret with pits & c

Thence Run East on line on North Side of reserve
Var 20° 50' E

89 a Point 25 lbs South of NW corner of Reservation as established by J. F. Moody U.S. Sept. Surveys in 1871

500 Nolan & Carrins 100 mile corner

16 52 SW corner of McKay Donation Claim set by myself

16 88 SW corner of C. O. Fannings Pasture fence

29 50 Gulch course N E

37 85 left bank of McKay creek course N

41 10 a Point 100 lbs North of witness corner Point for Secs 8-9-16 & 17

41 60 a Point 100 lbs North of June corner Point for Secs 8-9-16 & 17

50 50 Irrigation ditch course N

56 79 Nolan & Carrins SE corner of McKay Land Claim

57 23 a Point 26 lbs South of Moodys SW corner as claimed by C. O. Fanning as having built his fence around it while the original corner was standing although find no other evidence on the ground

Thence west Retracing same line

44 N & E S.W. cor. of McKay Land claim

15 63 N & E cor to Secs 8-9-16 & 17 100 lbs South
since crest through Sec 8

25 88 to hills SW corner of McKay Land Claim

40 71 through N.W. cor of Reserve 25-260 N

41 60 N & E NW corner of Reservation

John W. Mitchell County Surveyor
for Unalaska Co. Or.