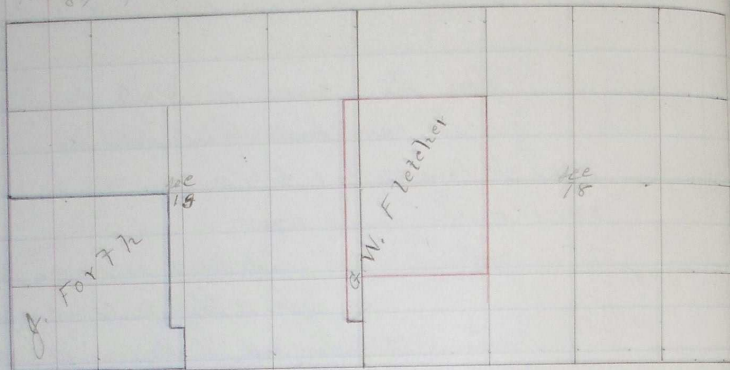


PLAT AND RECORD OF SURVEY No. 87

Course. Degree. Minutes. Chains. Links.

Surveyed for E. W. Fletcher and Henry Faith

Feb. 17th 1897Bears Fletcher of the bottom Tpa. 2, N. R. 31, 432, 8 or NW
same for the former

I Commenced at the S. E. Corner Sec 13

Thence north on range line bet ranges 31 & 32

on East Side Sec 13

10 20 old irrigation ditch runs NW

17 40 fence NW & SE

20 00 set temporary $\frac{1}{16}$ cor40 00 could not find $\frac{1}{4}$ cor on set temporary $\frac{1}{4}$ cor on60 50 set temporary $\frac{1}{16}$ cor

65 00 gulch runs NW

67 75 enter bottom near bluff

70 00 Ametilla pipe 204 lbs across

79 89 the corner to Sec 12-13 - $\frac{1}{4}$ corThence south ^{63'} on range line19 77 set Stone 24x24x8 for $\frac{1}{16}$ corner39 94 set Stone 20x8x10 mound of Stone for $\frac{1}{4}$ cor59 71 set Stone 12x6x5 for $\frac{1}{16}$ corner

69 50 set Stone 12x10x8 for fractional corner for 13 sec lot 9 & 13

Thence west - 365 lbs set Stone 14x8x10 for SW cor lot 9 & 13

750 set Stone 16x10x8 for NW cor lot 9 & 8 or on lot 10 1950 set

Stone 48x12x7 for NW cor lot 10 & 8 or on lot 11 4950 set Stone

96x10x8 for NW cor lot 11 Sec 13 Thence East 850 to NW cor. 1000 lbs


Dist.	Degrees	Minutes	Chains	Links	
					Thence West lot Sec 18 & 19 on random line
40	50				Set temporary 4/4 corner could not find original cor
75	50				cross fence into bottom N & E
85	00				cross old Langston - ditch
85	50				Intersect 32 chs South of center Sec 18-19-18 & 24 South through center Sec 18
20	50				Set temporary 1/16 cor center N 1/2 Sec 18
40	00				Set temporary 1/16 cor fr center Sec 18
60	00				" " " " 1/16 cor fr center S 1/2 Sec 18
81	25				Intersect at 4 Sec 02 Set Sec 18 & 19
					Thence North on true line
20	31				Set Post in mid of bits for center S 1/2 Sec 18
40	62				Set Post in mid of bits for center Sec 18
60	93				Set Stone 14 x 8 x 6 for center N 1/2 Sec 18 from the 1/16 corner on South Bdy Sec 18 I run North
20	15				Set Post for center SW 1/4 Sec 18
40	30				" " " " West 1/2 Sec 18
60	45				Set Stone 16 x 10 x 8 for center NW 1/4 Sec 18 from the SW cor Sec 18 I run E
					East on random line Set Secs 13 & 24
39	50				cross ridge runs North
40	50				could find nothing of the 1/4 cor
66	50				descend bluff
67	50				foot of bluff enter Birch creek bottom
78	50				Birch creek - 50 chs wide runs North
79	50				Intersect 150 chs South of the center Secs 13-24-18 & 19 on East bank of Birch creek
					Thence I run S 88° 55' W on true line Set Secs 13 & 24
39	75				Set Stone 18 x 8 x 6 in mid of Stone for 1/4 cor Thence North 1050 Set Stone for S 1/2 cor lot Sec 13 West 3/4 Sec 13 Thence North 950 chs Set cor 2950 Set Post for NW cor lot Sec 13 John W. Boinhill County Surveyor