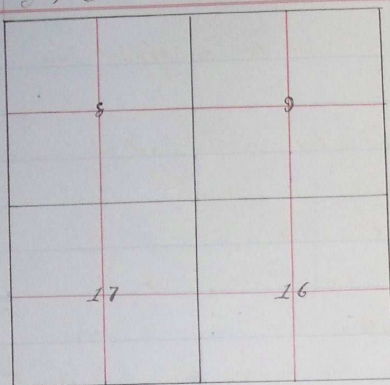


## PLAT AND RECORD OF SURVEY No. 112, 19

A. J. Stewart

Oct 12<sup>th</sup> 1899

Course. Degree. Minutes. Chains. Links.

11 S 63<sup>o</sup> 32' E W M

1 Commenced at the  $\frac{1}{4}$  po cor - bet Secs 8 and 17  
thence I run East bet. Secs 8 & 17

39 68 as pr. Tula notes could not find cor Secs 8-9-16 817  
bet Simpson cor in Birch creek  
thence East bet Secs 9 & 16

40 20 the  $\frac{1}{4}$  po cor bet Secs 9 & 16  
thence I run West

20 21 $\frac{1}{2}$  bet Stone 15+6+6 po  $\frac{1}{4}$  cor

40 23 to cor of Secs 8-9-16 817 in creek bed  
from which

a willow 26 in diam to N 2 $\frac{1}{2}$ ° E 21 $\frac{1}{2}$  Mo dist:

" 5 " " " S 89 $\frac{1}{2}$ ° E 78 " "

" 6 " " " S 63° W 45 $\frac{1}{2}$  " "

a balun 20 " " " N 89 $\frac{1}{2}$ ° W 148 " "

From the cor to Secs 15-16-21 822 I run  
N 89° 47' W on true line

71 30 E bank of Birch creek was N

74 50 W " " " "

81 10 the cor. of Secs 16-17-20 821 in County land corner N 18  
thence I run North bet Secs 16 & 17

90 00 12 $\frac{1}{2}$  Mo E of a  $\frac{1}{4}$  cor.

31 45 offset E 624 Mo

thence North on offset

38 59 Rocky bluff 20 ft high

## PLAT AND RECORD OF SURVEY No. 7419

- | Angle | Minutes | Chains | Links |  |
|-------|---------|--------|-------|--|
| 40    | 00      |        |       | Set Iron pins $\frac{1}{4}$ sec cor on offset line   |
| 60    | 00      |        |       | " " $\frac{1}{16}$ " " " "   |
| 80    | 23      |        |       | Intersect E-W line 598 lbs East of C. Sec 8-9-16 & 17<br>from which cor span<br>North lot Secs 8 & 9   |
| 40    | 40      |        |       | The $\frac{1}{4}$ sec cor lot Secs 8 & 9<br>thru S. 2nd  |
| 20    | 20      |        |       | Set Stone for 116 cor on N. by SW $\frac{1}{4}$ Sec 9<br>South through Center Sec 9  |
| 80    | 40      |        |       | The $\frac{1}{4}$ sec cor lot Sec 9 & 16<br>thru north on June line  |
| 20    | 10      |        |       | Set Stone in Stone md for 116 cor  |
| 40    | 20      |        |       | " " " " $\frac{1}{16}$ " in C. Sec 9<br>East through Center Sec 9  |
| 19    | 50      |        |       | Birch Creek runs N   |
| 40    | 18      |        |       | The Center Sec 9<br>thru west on June line   |
| 20    | 09      |        |       | Set Stone in md piers in bank creek - for 116 cor<br>More stakes E-W-N and South on line on bank<br>of Birch Creek from the June cor in creek<br>East through SW $\frac{1}{4}$ Sec 9 |
| 20    | 00      |        |       | Set Iron pins $\frac{1}{16}$ cor   |
| 40    | 27      |        |       | The $\frac{1}{16}$ cor in Center Sec 9<br>thru S. 2nd west on June line  |
| 20    | 18 1/2  |        |       | Set Stone 18 x 7 x 6 for $\frac{1}{16}$ cor in Center Sec 9<br>John W. Kimbrell County Surveyor<br>Gary Kimbrell and J. M. Wilson Chairman<br>M. A. Starbuck Township                |