


## PLAT AND RECORD OF SURVEY No. 113

Geo Elyer and A B Northwood Nov 2<sup>nd</sup> 1899

Course. Degree. Minutes. Chains. Links.

in T3N R33 E W 1/4

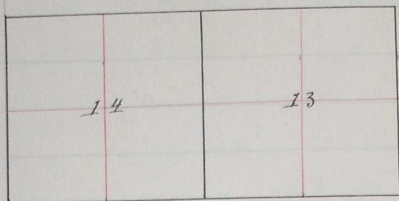

I commenced at the 1/4 sec cor bet Secs 11 and 14

thence I ran East bet Secs 11 & 14

39 94 the cor to Secs 11-12-13 & 14

thence South bet Secs 13 & 14


140 00 bet temporary 1/4 sec cor

80 29 the cor of Secs 13-14-23 & 24

thence North on true line

140 25 1/2 set Stone 22 & 26 for 1/4 sec cor

John W. Kimball County Surveyor

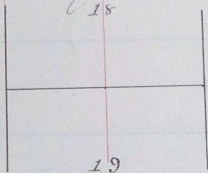

No 114

Surveyed for J Reed and Wm Williams

Nov 8<sup>th</sup> 1899 in T3N R36 E W 1/4

I commenced at the 1/4 sec cor bet Secs 11 & 19 and ran

East bet Secs 18 & 19

37 80 thence 208 lbs North of cor to Secs 17-18-19 & 20

thence N 87° 31' W on true line

18 65 set Stone for 1/4 sec cor

John W. Kimball County Surveyor