

Julius Sanderrian January 20<sup>th</sup> 1912

Course. Degrees. Minutes. Chains. Links.

in S. 1. N. R. 32. E. W. M.

I commenced at the 1/4 Sec cor bet Sec 9 and 10 at which corner I set a stone 21 x 16 x 5 inches

thence I run East on random line through center Sec 10

40 00 set temporary 1/4 corner

110 00 set " " "

51 36 West line of Road

80 30 intersect 50' Meas north of 1/4 Sec cor bet Sec 10 &amp; 11

South through Sec 10  $N 70^{\circ} 20' E$ 

39 58 intersect line E &amp; W Center line

79 58 to 1/4 Sec cor bet Sec 10 &amp; 15

Commencing at meander cor bet Sec 10 &amp; 15 on record of

17 95 chains West of the Co to Sec 10-11-14 &amp; 15

at which cor. I set Stone 12 x 8 x 6 inch

thence I run through Sec 10

 $N 22^{\circ} W 10^{\circ}$  this $N 18^{\circ} W 32^{\circ} 25'$  " intersect E & W line through

Center Sec 10 at a point 815' Me E of Center Sec 10

thence I run

West bet Sec 10 &amp; 15

17 95 Meander corner bet Sec 10 &amp; 15 on West by A. Sanderrian

40 00 set temporary 1/4 Sec cor

58 98 Birch Creek runs N to

80 57 intersect 160' Me south of cor Sec 9-10-15 &amp; 16

thence  $S 88^{\circ} 41' E$  on line

40 28 1/2 set Stone for 1/4 Sec cor

thence South through Sec 15  $N 60^{\circ} 20' E$ 

20 00 set temporary 1/4 cor

32 25 Birch Creek runs N W

36 25 " " " N E

41 50 set temporary 1/4 cor for Center Sec 15

54 02 Birch Creek runs W


58 00 offset 200' Me W

N  $22^{\circ}$

PLAT AND RECORD OF SURVEY No. 1111

Station Marks Chain Links

- 60 02 set temporary 116 cr on offset
- 65 00 set back east on line
- 79 64 Intersect 22 No W of 1/4 Sec point hit Sec 15 & 22 set  
stone for 1/4 Sec cr as ascertained as follows to wit  
Commencing at cor Secs 14-15-22 & 23 set  
run west hit Secs 15 & 22
- 80 00 set temporary 116 cr
- 85 50 Bird Creek
- 40 00 set temporary 1/4 Sec cor
- 80 00 " " Sec cr Make as I could find the trace of  
cr to Secs 15-16-21 & 22  
then go west hit Secs 16 & 21
- 80 86 a point 42 No N of 1/4 Sec cr hit Secs 16 & 21  
then 1/2 m east on same line
- 40 10 set stone for cr Secs 15-16-21 & 22  
then east
- 40 11 set stone for 1/4 Sec cr hit Secs 15 & 22
- 60 16 " " " 1/6 cr on S. by S. E. 1/4 Sec 15

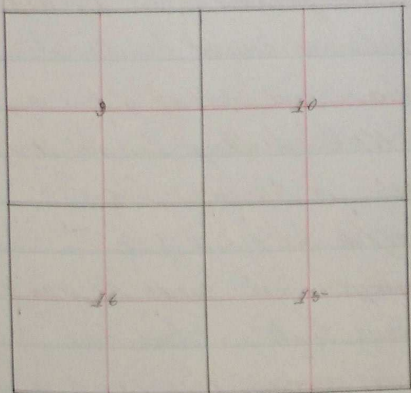

John W. Kimbell County Surveyor  
J. W. Sparks and B. Sparks Chaimonars  
Julius Soderstrom Notary