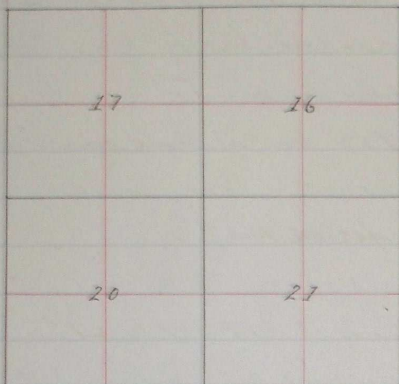


PLAT AND RECORD OF SURVEY No. 11819

Surveyed for Donald Ross and Elmer Henge March 14th 1900

Courses. Degrees. Minutes. Chains. Links.

S 1 S 16 30 S W W

I commenced at the 4th Sec cor. lot Dec 16 8 21

Thence 1/2 mi. west on Random line lot Dec 16 8 21

W 22 41° 5'

20 00 lot temporary 1/16 cor.

22 75 better creek so the wide runs North

40 26 could find no trace of cor Dec 16-17-20 8 21

Extend my line west lot Dec 17 8 21

55 00 haloh course NW

82 49 Intersect at 14 Sec cor lot Dec 17 8 21

Thence East

41 24 to cor Point 5 8 4 for Dec 16-17-20 8 21

Thence Station at 4 Sec cor lot Dec 16 8 17

over run south on Random line lot Dec 16 8 17

W 22 15° 5'

5 8 6 better creek course NW

9 45 top of bank on left bank

20 00 lot temporary 1/16 cor

40 10 lot temporary cor Dec 16-17-20 8 21

80 52 Intersect 255 No East of 4 Sec cor lot Dec 20 8 21

Thence N 10 31° 5'

40 26 lot stands 20+6+5 for cor Dec 16-17-20 8 21

From the 4 Sec cor lot Dec 16 8 21 I run

Acres Meters Chain Links

East on random line bet Sec 16 & 21

- 2012 lot temporary $\frac{1}{16}$ cor
- 4082 Intersect 7 lks south of Cades 15 & 16 - 21 & 22
there S89°58' W on same line
- 2041 lot stone in end of stone for $\frac{1}{16}$ cor
- 4087 taken bet Sec 16 & 21

North bet Sec 15 & 16 Nor 21° E

- 2175 gulch near SW
- 4036 Intersect 38 lks W of $\frac{1}{4}$ Sec cor
there 1/2 man

West on random line through Sec 16

- 2000 lot temporary $\frac{1}{16}$ cor
- 4011 " " $\frac{1}{16}$ cor
- 6055 " " $\frac{1}{16}$ cor
- 8055 Intersect 56 lks south of $\frac{1}{4}$ Sec cor bet Sec 16 & 17
from the $\frac{1}{4}$ Sec cor bet Sec 16 & 21 1 man
North on random line through center Sec 16
Nor 21° E

1775 gulch near SW

- 2011 lot temporary $\frac{1}{16}$ cor
- 4050 Intersect 114 lks W of first stake on S 84° line
- 5250 summit of ridge S & W
- 7500 gulch course SW
- 8127 Intersect 110 lks W of $\frac{1}{4}$ Sec cor
So 47° W on same line
- 4075 to center Sec 16
- 6001 lot stone in end of stone for center $\frac{1}{4}$ Sec 16
North through center S W $\frac{1}{4}$ Sec 16
- 4015 lot stone in end of stone for center SW $\frac{1}{4}$ Sec 16
North through center S 6 $\frac{1}{4}$ Sec 16
- 4018 lot stone in end of stone for center S 5 $\frac{1}{4}$ Sec 16
from W Turnbull corner 1880's