


PLAT AND RECORD OF SURVEY No. 136

Survey made at request of J. Saunders

May 10, 1902.

Course. Degrees. Minutes. Chains. Links.

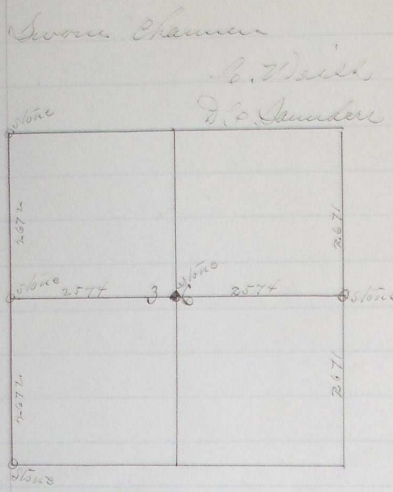

Cor. true line 72 21 15


53 42 N. E. Cor. Sec 36. at 1/2 distance I set Stone
2 x 10 x 10' and Stake 3x3. for 1/4 Sec Cor.

I now proceed to the N.W. Cor of 36'
where on finding remains of old Stake
which location was sworn to by Saunders
and Rodman I set Stone 15 x 8 x 8 for Cor
Thence

on random line. but Sec 35 & 36

53 43 I set Stake.

53 44 The corner to Sec 35 & 36 at 1/2 dist 2672 I
set Stone mound of 3 wash Troughs. 6 x 8 x 4.
6 x 6 x 4 & 6 x 5 x 10.

I now return to 1/4 Sec Cor. on E. line of
Sec. 36 and. run. W. on random line
through. cent. of Sec 36.

51 53. Set wash line of Sec 104 1/2 of 1/4 Sec Cor
at E. end. W. lines of Sec are. straight line
and the 1/4 Sec corner on 2 x 8 line of

