Surveyed for Charles Noyes Aug. the 5th 1887

by J.W. Kimbrell Dep.t Co. Surveyor

Plat No. 12

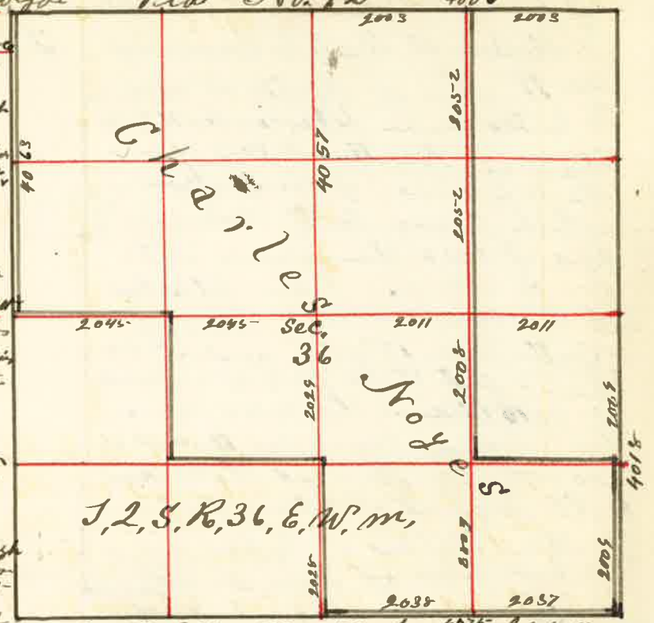

I Started at S.E. Corner of Sec. 36 thence North at 20 chains set Stake for 1/4 corner at 4018 chains the 1/4 Sec corner on East side of Sec 36 from which I run South at 2009 chains set Stake and built Mound of Stone for 1/4 Corner from which a Pine Tree 14 inches Diameter Bears N 75° W 125 links Diameter a Pine tree 18 inches Diameter Bears S 32° W 110 links distant. I Then Started at 1/4 Sec corner on East Side of Sec 36 thence West through Center of Sec 36 at 20 chains Set Stake for 1/16 corner at 40 chains Set Post for Temporary Sec Corner at Center of Sec 36 at 60 Chains Set Stake for Temporary 1/16 corner and at 8112 Chains the 1/4 Sec corner on West Side of Sec 36 I Then Started at 1/4 Sec corner on North Side of Sec 36 thence South at 4057 Chains I intersect East and West line through center 22 links West of first Random Stake for Center at 60 Chains Set Stake for Temporary 1/16 corner and at 8118 Chains the 1/4 Sec corner on South Side of Sec 36 from which I run North and at 2028 chains Planted Post for 1/16 corner from a Pine 8 inches Bears S 9° W 45 links dist. a Pine 10 inches Bears N 8° 15' W 38 links distant and 4057 chains the Center Grove Stake for Cente of Sec 36 from which a Fire Tree 7 inches diameter Bears N 52° 30' E 26 links a Fir 14 inches dia. Bears S 70° 45' W. 10 links distant thence West 2045 chains on Sec line and Planted Stake in Mound of Stone for 1/16 corner from which a Pine Tree 20 inches Bears N 40° 30' W 30 links a Pine 8 inches dia. Bears S 16° 45' E 42 links distant. I Then Started at N.E. corner of Sec 36 thence West at 20 chains Set Stake for Temporary 1/8 corner at 4006 chains the 1/4 Sec corner on North Side of Sec 36 from which I run East on true line and at 2003 chains Planted Stake and Built Mound of Stone for 1/8 corner from which a Pine tree 14 inches dia. Bears S 41° W 110 links dist. a Pine tree 18 inches dia. Bears N 81° W 77 links distant. I Then Started at 1/4 Sec Corner on South Side of Sec 36 thence East at 20 chains Set Stake for Temporary 1/8 cor at 4077 chains the E. corner of Sec 36 from which I run West on true line and at 2038 chains Grove Stake for 1/4 Corner from which a Pine 8 inches dia. Bears S 61° 45' E 45 links distant a Pine Tree 7 inches Bears N 9° 45' W 25 links distant From this Corner I run North on true line and at 2007 chains Grove a Stake for 1/16 corner in center of S.E. 1/4 Sec 36 from which a Pine 5 inches dia. Bears S 14° 15' E 100 links dist. a Pine 7 inches dia. Bears N 48° 45' E 56 links distant and at 4015.0 Grove Stake for 1/4 Corner from which a Pine 20 inches dia Bears S 81° 30' E 19 links distant a Pine 20 inches dia. Bears S 85° W 75 links distant and at 6067 Chains drove Stake and Built Mound of Stone for 1/4 corner from which a Pine 8 in dia. Bears N 18° 15' W 44 links a Pine 7 inches dia. Bears N 3° 15' E 29 links dist. and at 8119 chains the 1/4 corner on N. Side of N.E. 1/4 Sec 36

J. W. Kimbrell Dep.t Co. Surveyor

Surveyed for C. L. Kaaleo Aug. the 15 1887

by J.W. Kimbrell Dep.t Co. Surveyor

Plat No. 13

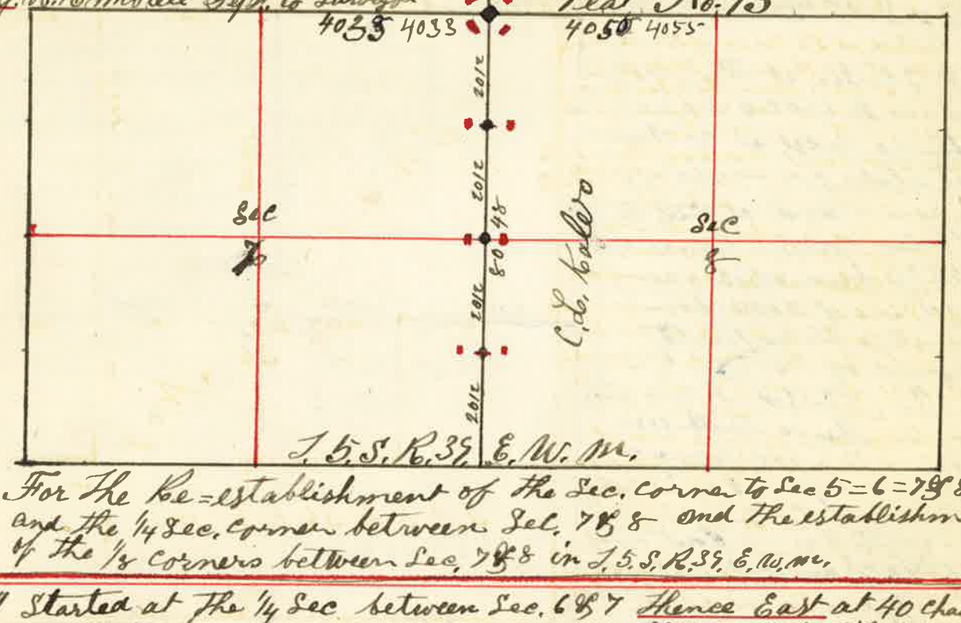

For the Re-establishment of the Sec. corner to Sec 5-6-7&8 and the 1/4 Sec. corner between Sec. 7&8 and the establishment of the 1/8 Corners between Sec. 7&8 in T. 5 S. R. 3 E. W.M.

I Started at the 1/4 Sec between Sec. 6&7 thence East at 40 chains Set a Stake for Temporary Corner and at 3088 chains the 1/4 Sec. Corner between Sec 5.&8. from which I run West on true line and at 4060 chains Grove the Random Stake at the Reported Distance East & West as Per. Original Field Notes of U.S. Survey. I Then Proceeded to the Sec. Corner to Secs. 7-8-17&18. thence North at 40 chains Set Stake for Temporary 1/4 Sec. Corner and 60 chains Set Stake for Temporary 1/16 Corner and at 80 chains Set Stake for Temporary Sec. Corner and at 4072 chains further on the 1/4 Sec. Corner between Secs. 5&6 makeing an Excess of 72 links on the mile and a/c over the original Field Note. I Therefore run South on true line Var 20° E and at 4024 chains I Established the Sec. Corner to Sec. 5-6-7&8 by Planting a Stake 4 inches Square and 3½ feet long 18 inches in the ground with a Handfull of Charcoal at Bottom Built a mound of Earth and dug Pits N.E., S.E., N.W., & S.W. 5 feet from Stake, from this corner I run South on Same Var. 20° E and at 2012 Chains Planted Stake with Charcoal at Bottom Built Mound dug Pits &c. for 1/4 corn and at 4024 chains Planted Stake with Charcoal at Bottom built Mound of Earth & dug Pits N & South of same for 1/4 Sec. corn between Sec. 7&8 at 6086 chains drove Stake for 1/4 corn at 8048 chains the Corner to Sec 7-8-17&18.

J. W. Kimbrell Dep.t Co. Surveyor