Surveyed for Alvian Frisby Apr 16th 1888

by J.W. Kimbell Dep't. Co. Surveyor Plat No 30

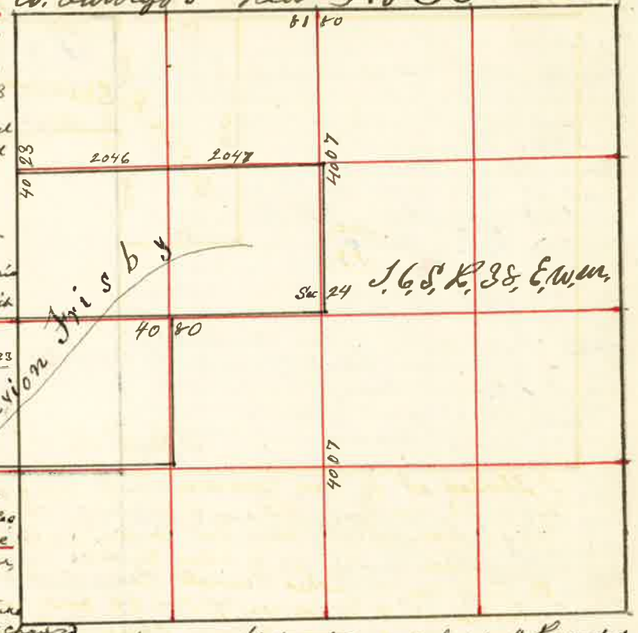

I Started at the N.W. Corner of Sec 24 thence South at 20 chains Set Random Stake and at 4023 chains the ¼ Sec corner between Sec 23 & 24 from which I run North and at 2011 chains Set Stake in Mound of Stone for ¼ corner and at 4023 the Sec Corner to Sec 18 = 19 = 23 & 24 thence East at 20 chains Set Random Stake for ¼ Sec corner and at 60 chains Set Random Stake for ¼ corner and 8180 chains Stake for ¼ corner of Sec 24 from which the N.E. Corner of Sec 24 from which I run West on true line and at 2045 chains Set Stake for ¼ corner and at 4090 chains Set Stake built Mound One Rod North & South of Mound for ¼ Sec corner between Sec 18 & 24 and at 6135 chains Set Post for ⅛ Corner. I then started at ¼ Sec corner on West Side of Sec 24 thence East at 20 chains Set Post for ⅛ Corner and at 4080 chains Set Random Stake for center continue East by alignement but did not chain. The ¼ Sec corner on South Side of Sec 24 being Obliterated and lost I proceeded to re-establish it by starting at the Sec corner to Sec 24 = 25 = 19 & 30 and run West and at 40 chains Set Random Stake and at 8158 chains the Sec corner to Sec 23-24-25-26 & 29 from which I run East on true line and at 4079 chains Set Stake for ¼ Sec corner between Sec 24 & 25. Thence North at 4007 chains the center of Sec 24 and at 8014 chains the ¼ Sec Corner on North Side Sec 24 from which I run South on true line and at 2004 chains Set Stake for ⅛ corner thence West 2047 chains and Set Stake for ¼ corner in Center of N.W. ¼ Sec. 24 thence South 2001.0 chains and Set ⅛ corner thence South 2012 chains & Set Stake for ⅛ corner in center of S.W. ¼ Sec. 24 the ¼ Sec Corner between Sec 23 & 24 thence South at 20 chains Set Random Stake at 4016 chains the S.W. Corner of Sec. 24 from which I run North and at 2008 chains Set Post for ⅛ corner on West Side of S.W. ¼ Sec. 24

Survey No. 29½

J.W. Kimbell Deputy County Surveyor

G.W. Moody April 15 1888

Beginning at the ¼ Sec cor Set Sec 14 & 15 thence North 68 Rods & 12 lks thence S 27° E 38 " thence S 82° N 8 " 15 lks thence S 3° E 33 " 9 " thence N 89° 45' W 10 " 14 " to Place of Beginning

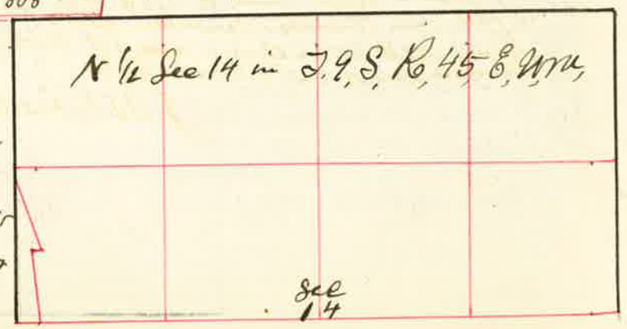

J.W. Kimbell Dep't Co Surveyor

Surveyed for Sarah E. Sharenhousen April the 17th 1888

by J.W. Kimbell Dep't. Co. Surveyor Plat No. 31

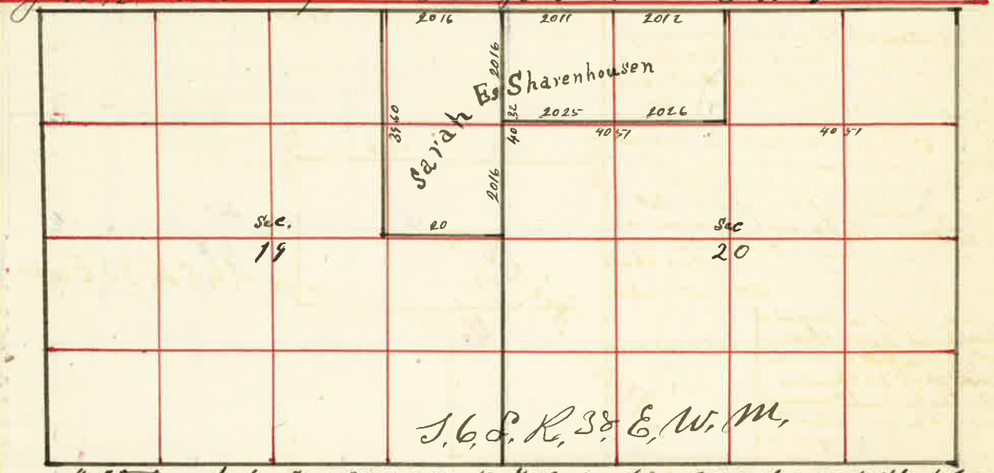

I Started at ¼ Sec corner on North Side of Sec 20 and run West at 20 chains Set Random Stake and at 4023 chains the Sec corner to Sec 17 = 18 = 19 & 20 from which I run East and at 2011 chains Set Post in the Mound, from which a Fir Tree 16 inches Diameter Bears N 82° 30' E 114 links distant. A Pine Tree 14 inches Diameter Bears South 8° 45' West 180 links distant.

I Started at N.W. Corner of Sec 20 and run South and at 20 chains Set Random Stake and at 4032 chains the ¼ Sec corner between Sec 19 & 20 from which I run North at 2016 chains Drove Stake for ⅛ corner Marked a Tamarack Tree for ⅛ corner. Thence North 3960 Chains to ¼ Corner Previously Set. Thence East 2016 chains to Sec corner to Sec 17 = 18 = 19 & 20. I then Started at ¼ corner on West Side of N.W. ¼ Sec 20 and run East Setting Random Stakes at each 20 and 40 chains to Center of Sec 20 and Extended the same line to East Boundary of Sec 20 to ¼ corner on East Side of N.E. ¼ Sec. 20 which I determined by Starting at ¼ Sec corner on East Side of Sec 20 and run North 3954 Chains to N.E. Corner of Sec 20 from which I run South 1977 chains and Set Post in Mound of Stone, I then Started at ¼ Sec corner on North Side of Sec 20 and Ran South 2015 chains and Planted a Stone 6 × 7 × 17 inches 10 inches in the ground from which a Pine Tree 20 inches dia. Bears S 71° 15' W 100 links dist. a Pine Tree 15 inches diameter Bears N 12° 45' W 78 links distant Thence West 2026 chains and Set Stake from which a Fir Tree 12 inches diameter Bears N 65° E 11 links distant a Fir Tree 6 inches dia bears S 37° W 8 links dist.

J.W. Kimbell Dep't Co Surveyor

1701
788
13