


92 Surveyed for A. Hopkins & Chad Leach May 28 1889

by J.W. Kimbell County Surveyor Plat No. 78

I Commenced at the 1/4 Sec corner bet Sec 8 & 17 and run East var 20° 15' E, for the Re-establishment of the 1/4 Sec corner bet Sec 9 & 16 and the corner to Sec 8 = 9 = 16 & 17.

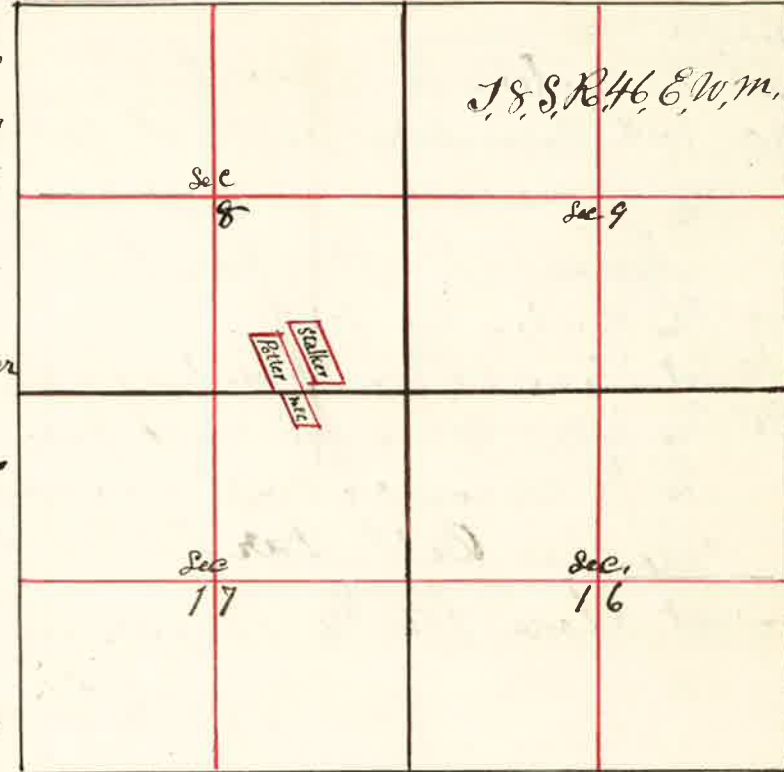

2000 Set Post for Temporary 1/8 corner
4000 Set " " " Corner to Sec 8 = 9 = 16 & 17

Thence East var 20° E.
2012 Set Stake for Temporary 1/8 corner
4025 Set Stake for Temporary 1/4 Sec corner

6037 Set Stake for Temporary 1/8 corner
8015 The corner to Sec 9 = 10 = 15 & 16 7 lks South of corner from which I run West on true line bet Sec 9 & 16

2006 Set Post marked 1/8 from which an asp 4 inches bears S 35° W 16 1/2 lks distant marked 1/8 B.T.
" 3 " " N 8° E 30 " " " 1/8 B.T.

4012 Set Post marked 1/4 8 from which an asp 5 inches bears S 87° E 125 lks " marked 1/4 B.T.

6018 Set Post in old bed of Linc creek in mound of Stone marked 1/8 from which a cottonwood 6 inch bears S 31 1/4° E 37 1/2 lks marked 1/8 B.T.

8025 Set Stone 9 x 10 x 18 from which an asp 5 inches bears N 38 1/2° W 148 lks marked ¹¹⁶ T.S.R. 46 E. B.T.
" " 6 " " S 10° E 212 " marked S.S. T.S.R. 46 E. B.T.
Thence west bet Sec 8 & 17 var 20° E.

1994 Set Stake for 1/8 corner
3988 The 1/4 Sec corner bet Sec 8 & 17

I then started at the corner to Sec 4 = 5 = 8 & 9 which is a stone but no bearing trees I therefore marked a pine 18 inch bears S 50° 30' E 26 lks dist marked S.S. T.S.R. 46 E. B.T.
" 18 " " N 6° E 26 " " " S 47° 30' E B.T.

93 Surveyed for Hopkins & Leach May 28 1889

Thence South var 20° E
6000 Set Temporary Stake for 1/8 corners
7675 Linc creek 265 lks wide runs S.E.
8000 Set Post for Temporary corner to Sec 8 = 9 = 16 & 17

Thence South on same variation
4000 found no 1/4 Sec corner Set Stake for Temporary 1/4 Sec.
8000 found no Sec corner Set Stake for Temporary corner

Thence South
4000 found no 1/4 Sec corner
8006 the corner to Sec 20 = 21 = 28 & 29

I therefore run North 8002 Set Volcanic Stone 8 x 10 x 20 inch
Thence North

4001 Set Post for 1/4 Sec corner
8002 the corner to Sec 8 = 9 = 16 & 17

Thence North
2000 Set Post marked 1/8 for 1/8 corner from which an asp 5 inch bears N 4 1/2° E 100 lks marked 1/8 B.T.
an alder 3 " " S 47° W 22 " " 1/8 B.T.

J.W. Kimbell County Surveyor

Surveyed for Statler & Potter May 29 1889 Page 92

Beginning at a point 933 feet East of the S.W. corner of the S.E. 1/4 Sec & T.S.R. 46 E Thence East 241 feet Thence N 22 3/4° W 482 feet Thence West 241 feet Thence S 22 1/2° E 482 feet to Place of Beginning containing 2 1/2 acres Nearly.

also Beginning at a point 1237 feet East of the 1/4 Sec corner bet Sec 8 & 17 and 25 feet North of Laid corner.

Thence East 241 feet Thence N 22 3/4° W 482 feet Thence West 241 feet Thence S 22 3/4° E 482 feet to Place of Beginning

Containing one acre nearly
J.W. Kimbell Co Surveyor

Surveyed for the M.E. Church in Sec. 17 May 29 1889 Page 92

Beginning at a point 958 feet East of the N.W. corner N.E. 1/4 Sec 17 Thence East 215 feet Thence S 22 3/4° E 215 feet Thence West 215 feet Thence N 22 3/4° W 215 feet to Place of Beginning containing one acre Nearly
J.W. Kimbell County Surveyor