Surveyed for James Bright & John McDonald July 19 1889
By J.W. Kimbrell County Surveyor Plat No. 87

I Commenced at the Corner
to Sec. 29=30=31&32
Thence West Var 20°
2000 Set Stake for Temporary 1/8 Corner
4003 Intersect 24 lks North of 1/4 Sec Corner
from which I run East
N 89°20' E on True line
2001½ Set Post for 1/8 Corner from which
a Pine 16 in Dia 6° E 25 lks
" 7 " " S76° W 36 "
4003 the Corner to Sec 29=30=31&32
the 1/4 Sec corner bet Sec 29&30
Thence North Var 20° E.
200 Var 21° E.
2000 Set Post for Temporary 1/8 Corner
3000 Var 20° E
4007 Intersect E & W. line
171 lks East of Corner to
Sec 19=20=29&30 from which
I run S 2½° E Var 20° E
2005½ Set Stone 4×12×22 inches Marked 1/8 for Corn E Side N E 1/4 Sec 30
the Corner to Sec 19=20=29&30
Thence West Var 21° E
2000 Set Temporary 1/8 Corner
4000 Intersect 24 lks North of 1/4 Sec Corner bet Sec 19&30
from which I run N 89°30' E on True line Var 21° E
2000 Set Post for 1/8 Corner on North Boundary N E 1/4 Sec 30
4000 the Corner to Sec 19=20=29&30
the 1/4 Sec corner on West Boundary Sec 30
Thence East Through Centr Sec 30 Var 20° E.
6000 Set Stake for Temporary 1/16 corner for Center E 1/2 Sec 30
8080 Intersect East Boundary Sec 30 20 lks North of 1/4 Sec Corner bet Sec 29&30

the 1/8 Corner on North Side N E 1/4 Sec 30 Thence South Var 20° E
2000 Set Stake for ~~4 Corner~~ Temporary 1/16 corn in Centr N E 1/4
4025 Intersect E & W line 10 lks West of 1st Stake at this Point
4990 Intersect South Boundary at 1/8 Corner on South Side S. E. 1/4 Sec 8
from which I run North Var. 18°30' E
3965 Set Stone 5×6×24 marked 1/16 for Centr E 1/2 Sec 30 Thence North Var 20°30' E
5977 Set Stone 6×8×22 for Center N E 1/4 Sec 30

J.W. Kimbrell County Surveyor

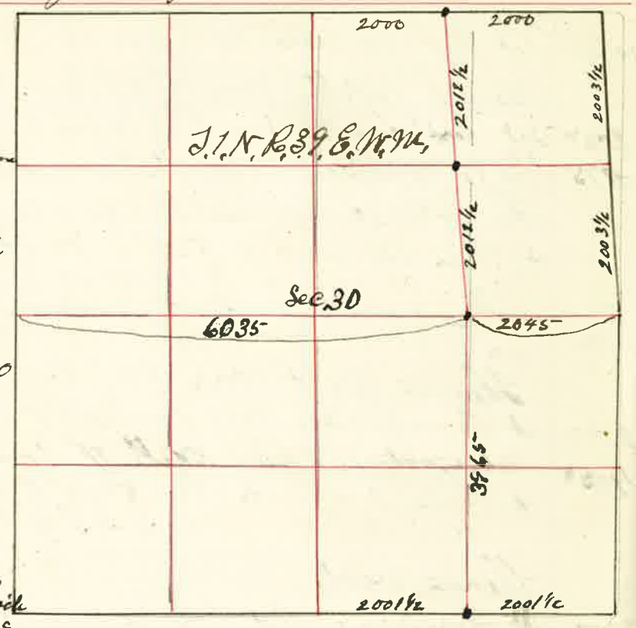
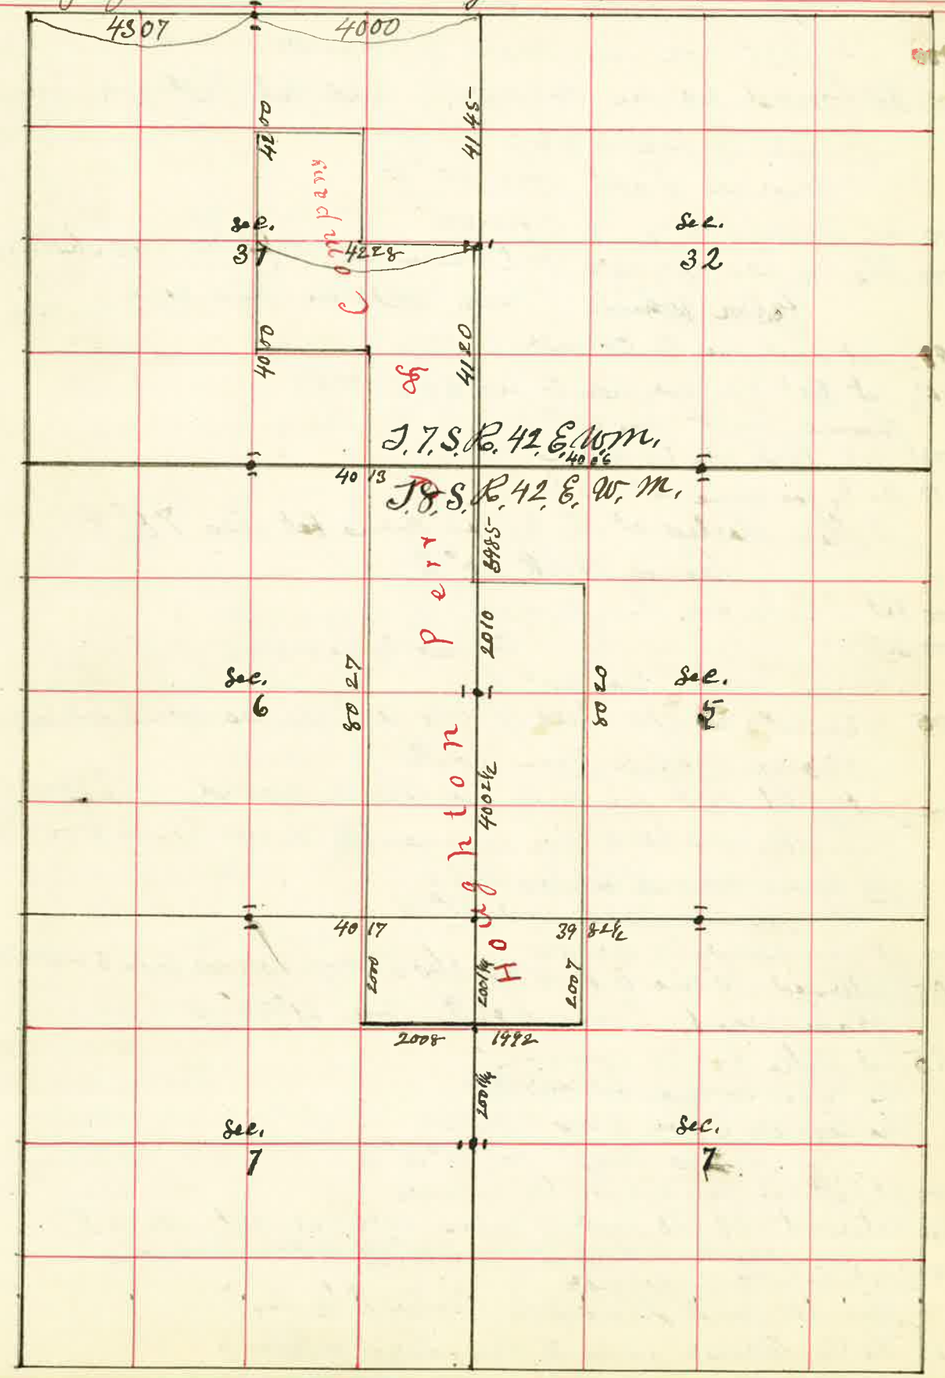
Surveyed for Houghton Perry & Co. Aug 7th 1889
By J.W. Kimbrell County Surveyor Plat No. 88.