RECORD OF SURVEY No. 309

Surveyed for G. M. Hattal Estate Feb 16th 1910

51055 GLASS & PRUDHOMME COMPANY, PRINTERS AND STATIONERS, PORTLAND, OREGON

Chains Links

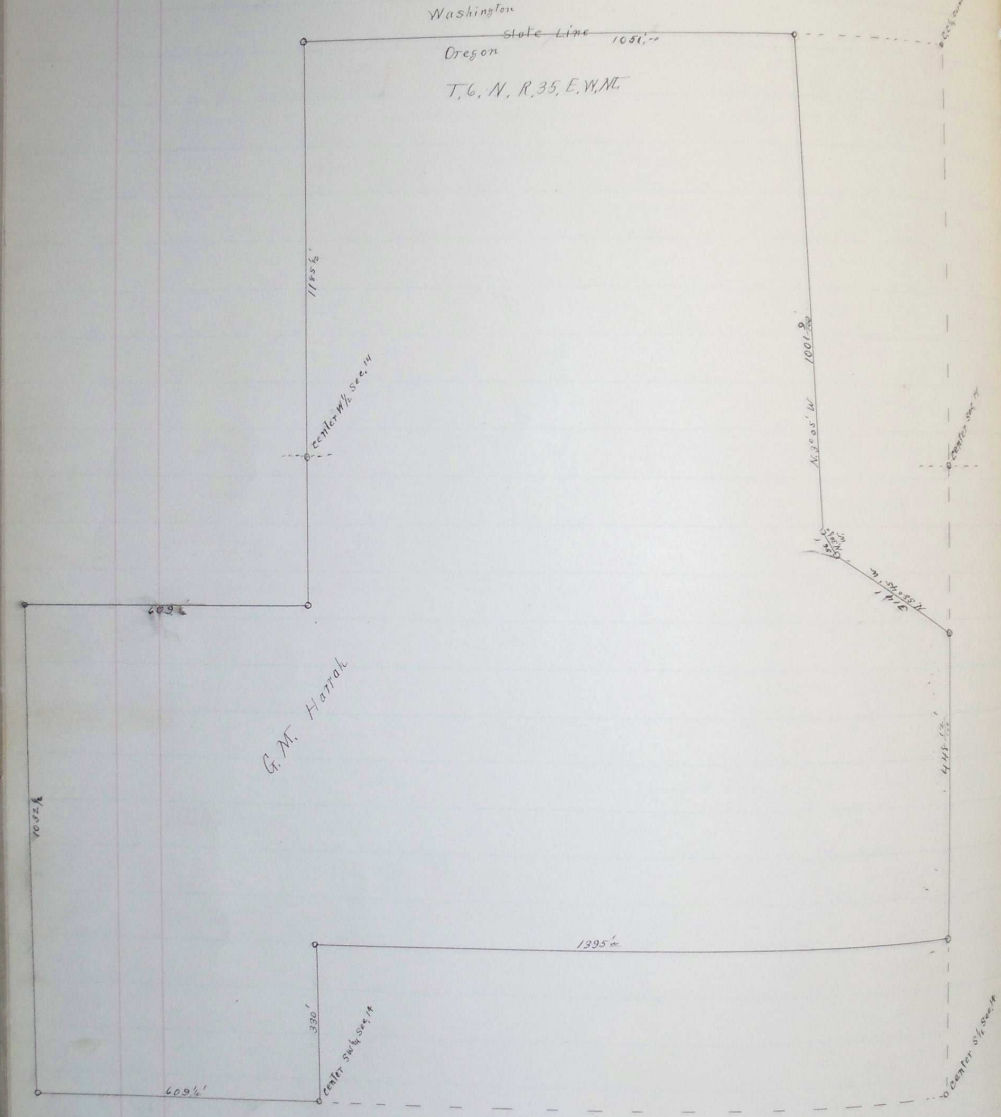

John W. Kimball County Surveyor