

Survey of section 33 T. 1 N; R. 30 E. W. M.


Survey made for M. L. Fix, Geo Johnston & M. Reeder.

April 19 to 23 1917.

Made survey as shown by plat below.

Govt Cors. ○

Established Cors. ○

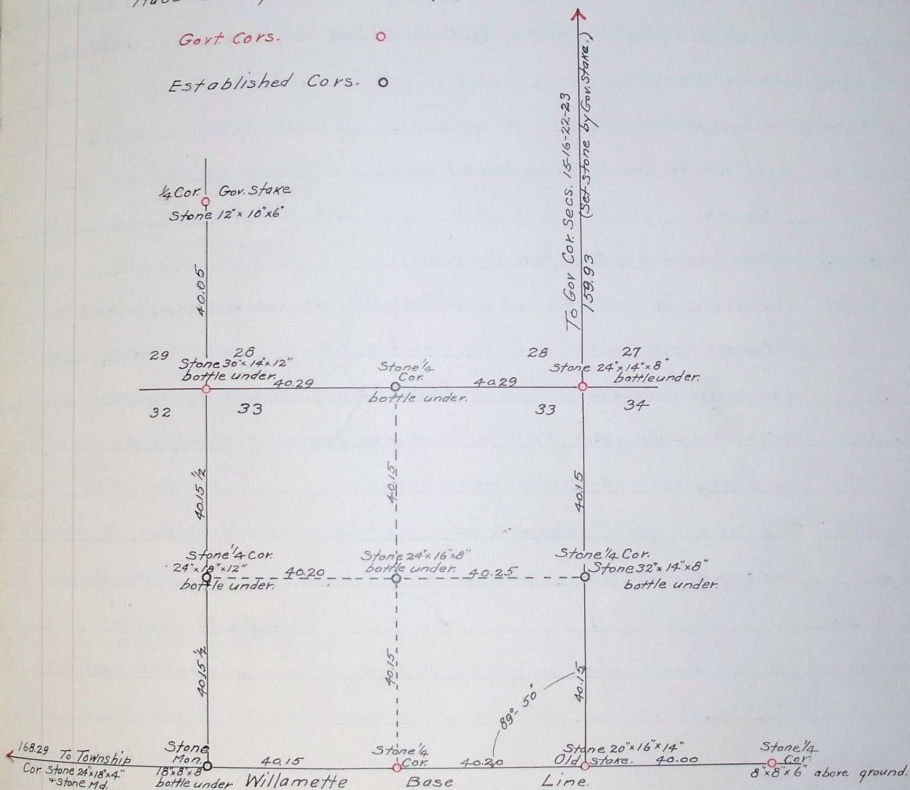

Willard Bradley
County Surveyor.
April 25 1917.