


Survey for Garage Bldg. Corner of Court St. & Garden Sts. Portland, Ore.

Chains Links

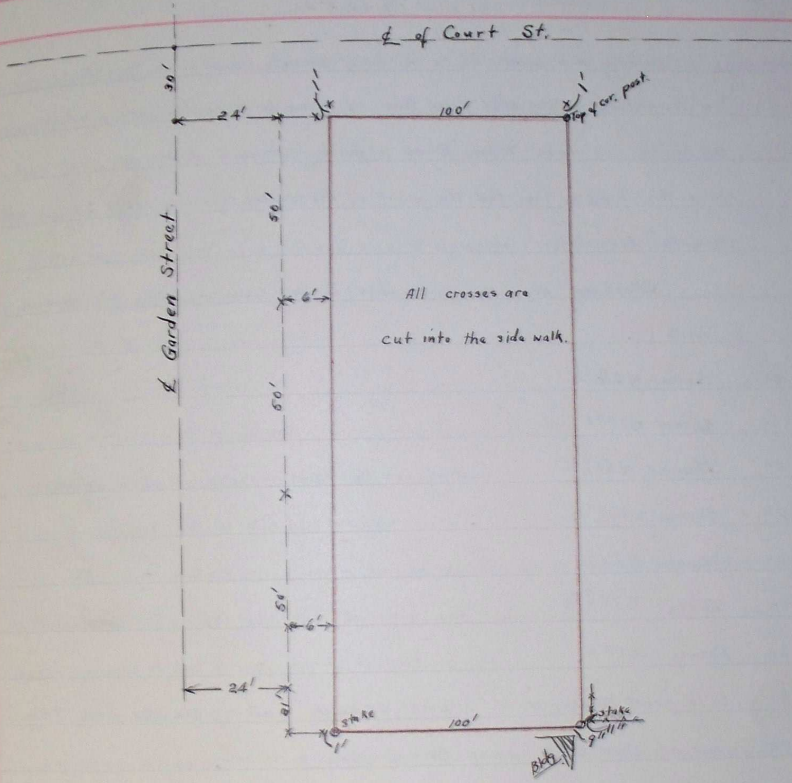

Arthur E. Perry
Surveyor.