

00.41	A						****				1	10	U			09
00.41							==== HWY 2 COLUMBIA RV HY				1	10	U			09
00.35							-)(- IRRIGATION				1	10	U			09
00.27							<)(- IRRIGATION				1	10	U			09
00.00	A						==== HWY 2 COLUMBIA RV HY				1	10	U			09
00.00																

Mile Point	D	City Code	POP	Ave Day Trf	FED AID	X R E F	LEFT	CENTER	RIGHT	C O N D	L A N E	Widths	Types	R/W	Urban	FN
												L S R	L S R			

00.49	A	0000			***				2	14	G			09
00.49		0000	0		====	HWY 2 COLUMBIA R HY			2	14	G			09
00.48		0000	0			UMATILLA CL CTY AHD			2	14	G			09
00.08						90 DEG TURN LEFT			2	14	G			09
00.06						-)(-			2	14	G			09
00.00	A					==== HWY 54 US 395			2	14	G			09
00.00						<i>Wildwood Ln</i>								
						<u>MARGARET AVE</u>								

Mile Point	D	City Code	POP	Ave Day Trf	FED AID	X R E F	LEFT	CENTER	RIGHT	C O N D	L A N E	Widths	Types	R/W	Urban	FN
												L S R	L S R			

DATE: 02/28/95

30 P 3004 RD 526 AT RM 0.87

N 26

6N

35E

DEAD END

ROAD NO: 3004

00.25 DDDD DEAD END 2 16 G 09

00.00 A ==== 526 CROCKETT RD 2 16 G 09

00.00 DIDION LN (CROCKETT)

Mile Point	D	City Code	POP	Ave Day Trf	FED AID	X R E F	LEFT	CENTER	RIGHT	C O N D	L A N E S	Widths	Types	R/W	Urban	FN
												L S R	L S R			
												S S S	S S S			

30 P 3004 RD 526 AT RM 0.87
Co C Road# Begining

N Dir

26 Sec

6N Township

35E Range

DEAD END Ending

3004 Road#

OREGON DEPARTMENT OF TRANSPORTATION
Roadway Analysis 503/378-6277

DATE: 02/28/95

3005 Sunset Dr

00.10 DDDD DEAD END 1 10 U 09

00.00 A Patriot Ln ==== HY 333 DIAGONAL RD 1 10 U 09

00.00

Mile Point	D	City Code	POP	Ave Day Trf	FED AID	X R E F	LEFT	CENTER	RIGHT	C O N D	L A N E	Widths	Types	R/W	Urban	FN
												L S R	L S R			
												S S S	S S S			

30 P	3006	HWY 333 AT MP 3.98	S	06	4S	29E	DEAD END	3006
Co C	Road#	Begining	Dir	Sec	Township	Range	Ending	Road#

DATE: 02/28/95

OREGON DEPARTMENT OF TRANSPORTATION
Roadway Analysis 503/378-6277

30 P 3007 HWY 333 AT MP 3.99

N 06

4N

29E

DEAD END

ROAD NO: 3007

00.15							DDDD DEAD END			1	08	U			09
00.07							90 DEG TURN LT			1	08	U			09
00.00 A							==== HY 333 DIAGONAL RD			1	08	U			09

00.00

Mile Point	D u p e	City Code	POP	Ave Day Trf	FED AID	X R E F	LEFT	CENTER	RIGHT	C O N D	L A N E S	Widths L S R	Types L S R	R/W	Urban	FN
------------	---------	-----------	-----	-------------	---------	---------	------	--------	-------	---------	-----------	--------------	-------------	-----	-------	----

30 P 3007 HWY 333 AT MP 3.99
Co C Road# Begining

N 06 4N 29E DEAD END
Dir Sec Township Range Ending

3007
Road#

DATE: 02/28/95

OREGON DEPARTMENT OF TRANSPORTATION
Roadway Analysis 503/378-6277

30 P 3008 RD508 RM 0.52

S 18

6N

35E

RD532 RM 0.51

ROAD NO: 3008

01.27 A							****			2	20	G			09
01.27							====	532 PHILLIPS RD		2	20	G			09
01.13								JOHNSON CREEK	-)(<	2	20	G			09
01.02									==== HY 332	2	20	G			09
00.50									-)(<	2	20	G			09
00.35								LITTLE MUD CREEK	-)(<	2	20	G			09
00.00 A									==== 508 FRUITVALE RD	2	20	G			09
00.00								GRABNER RD (UMAPINE)							

Mile Point	D u p e	City Code	POP	Ave Day Trf	FED AID	X R E F	LEFT	CENTER	RIGHT	C O N D	Widths			Types		R/W	Urban	FN
											L	S	R	L	S			

30 P 3008 RD508 RM 0.52
Co C Road# Begining

S Dir

18 Sec

6N Township

35E Range

RD532 RM 0.51 Ending

3008 Road#

OREGON DEPARTMENT OF TRANSPORTATION
Roadway Analysis 503/378-6277

DATE: 02/28/95

30 P 3010 HWY 333 MP 11.52

E 28

4N

28E

RD 1324 RM 0.00

ROAD NO: 3010

00.55	A					XXXX						2	2	28	2	G	A	G	50	09
00.55						==	1393					2	2	28	2	G	A	G	50	09
00.00	A					====	HY 333 ORE 207					2	2	28	2	G	A	G	50	09

SIMPLOT RD																					
Mile Point	D u p e	City Code	POP	Ave Day Trf	FED AID	X R E F	LEFT	CENTER	RIGHT	C O N D	L A N E	Widths	Types	R/W	Urban	FN					
											L	S	R	L	S	R					
											D	E	S	S	S	S					

30 P 3010 HWY 333 MP 11.52
Co C Road# Begining

E 28
Dir Sec

4N
Township

28E
Range

RD 1324 RM 0.00
Ending

3010
Road#

OREGON DEPARTMENT OF TRANSPORTATION
Roadway Analysis 503/378-6277

DATE: 02/28/95

30 P 3012 RD 1268 AT RM 2.42

N 23

5N

28E

RD 1272 AT RM 0.2

ROAD NO: 3012

00.16 A						***				2	18	G			09
00.16						====	1272 BOWDEN LN			2	18	G			09
00.00 A						====	1268 BENSEL RD			2	18	G			09
00.00															

Mile Point	D u p e	City Code	POP	Ave Day Trf	FED AID	X R E F	LEFT	CENTER	RIGHT	C O N D	L A N E	Widths	Types	R/W	Urban	FN
												L S R	L S R			
												D E S	S S S			

30 P 3012 RD 1268 AT RM 2.42
Co C Road# Begining

N Dir

23 Sec

5N Township

28E Range

RD 1272 AT RM 0.29
Ending

3012 Road#

DATE: 02/28/95

OREGON DEPARTMENT OF TRANSPORTATION
Roadway Analysis 503/378-6277

No Rd There & not Public

00.09 ***** PVT RD AHD 1 12 G 09
 00.00 A ==== HWY 54 US 395 1 12 G 09

00.00

Mile Point	D u p e	City Code	POP	Ave Day Trf	FED AID	X R E F	LEFT	CENTER	RIGHT	C O N D	L A N E S	Widths L S R	Types L S R	R/W	Urban	FN
------------	---------	-----------	-----	-------------	---------	---------	------	--------	-------	---------	-----------	--------------	-------------	-----	-------	----

30 P 3016 RD 1269 AT RM 0.75

W 34

5N

28E

HWY 54 AT MP 3.03

ROAD NO: 3016

00.38	A					****				2	16		D			09
00.38						====	HWY 54 US 395			2	16		D			09
00.25						==	3023 LORAIN ST			2	16		D			09
00.00	A					====	1269 SAGEBRUSH RD			2	16		D			09

The Rest is No Public

00.12

Follett Ln

Mile Point	D	City Code	PDP	Ave Day Trf	FED AID	X R E F	LEFT	CENTER	RIGHT	C O N D	L A N E	Widths	Types	R/W	Urban	FN
												L S R	L S R			

30 P 3016 RD 1269 AT RM 0.75
Co C Road# Begining

W 34
Dir Sec

5N 28E
Township Range

HWY 54 AT MP 3.03
Ending

3016
Road#

DATE: 02/28/95

OREGON DEPARTMENT OF TRANSPORTATION
Roadway Analysis 503/378-6277

00.33							DDDD DEAD END			1	08	U		09
00.25 A							90 DEG TURN RT			1	08	U		09
00.25							==			1	08	U		09
00.12							==== 1271			1	08	U		09
00.00 A							==== HWY 54 US 395			2	16	D		09
00.00														

No Rd. Not Public

Mile Point	D u p e	City Code	POP	Ave Day Trf	FED AID	X R E F	LEFT	CENTER	RIGHT	C O N D	L A N E S	Widths	Types	R/W	Urban	FN
											L S R	L S R				
											D E S	S S S				

00.11	0000	0					DDDD DEAD ENDC		1	12	G		H	19
00.09	0000	0					HERMSTN CL CITY AHD		1	12	G		H	19
00.05							END CL RT		1	12	G		H	19
00.04							HERMSTN CL CITY BK		1	12	G		H	19
00.00 A	0000	0					==== HWY 54 N 1ST ST		1	12	G		H	19

00.00 NE CORNELL PL

Mile Point	D	City Code	POP	Ave Day Trf	FED AID	X R E F	LEFT	CENTER	RIGHT	C O N D	L A N E S	Widths	Types	R/W	Urban	FN
												L S R	L S R			

30 P 3020 1283 RM 2.05

W 33

5N

28E

RD 1273 RM 0.04

ROAD NO: 3020

00.33 A							*** 1273 AHD				1	12	G		H	19
00.33							== 1273 COONEY LN				1	12	G		H	19
00.00 B							== 3021				1	12	G		H	19
00.00 A							== 1283 SUNSHINE LN				1	12	G		H	19

00.00

Mile Point	D	City Code	POP	Ave Day Trf	FED AID	X REF	LEFT	CENTER	RIGHT	C O N D	L A N E	Widths	Types	R/W	Urban	FN
												L S	R S			
												S	S			

30 P 3020 1283 RM 2.05
Co C Road# Begining

W 33
Dir Sec

5N 28E
Township Range

RD 1273 RM 0.04
Ending

3020
Road#

DATE: 02/28/95

OREGON DEPARTMENT OF TRANSPORTATION
Roadway Analysis 503/378-6277

00.29 DDDD DEAD END 1 10 D H 19

00.00 A ==== 1250 PUNKIN CTR RD 1 10 D H 19

00.00

Mile Point	D u p e	City Code	POP	Ave Day Trf	FED AID	X R E F	LEFT	CENTER	RIGHT	C O N D	L A N E	Widths	Types	R/W	Urban	FN		
											L	S	R	L	S	R		
											D	E	S	S	S	S		

30 P 3021 RD 1250 RM 0.03
Co C Road# Begining

S 03 4N 28E DEAD END
Dir Sec Township Range Ending

3021
Road#

OREGON DEPARTMENT OF TRANSPORTATION
Roadway Analysis 503/378-6277

DATE: 02/28/95

*Rd is there but no information
To make it public*

00.34 DDDD DEAD END 1 10 U 09

00.00 A ==== 1272 BOWDEN LN 1 10 U 09

00.00

Mile Point	D u p e	City Code	POP	Ave Day Trf	FED AID	X R E F	LEFT	CENTER	RIGHT	C O N D	L A N E	Widths L S R	Types L S R	R/W	Urban	FN
------------	---------	-----------	-----	-------------	---------	---------	------	--------	-------	---------	---------	--------------	-------------	-----	-------	----

30 P	3022	RT 1272 AT RM 1.19					N	22	5N	28E	DEAD END					3022
Co C	Road#	Beginning					Dir	Sec	Township	Range	Ending					Road#

DATE: 02/28/95

00.25	A				XXXX					2	16	D			09
00.25					====	3016				2	16	D			09
00.12					XXXX	3018 MALCOLM ST				2	16	D			09
00.06					==	3024 CECIL ST				2	16	D			09
00.00	A				====	1256 JOY LN				2	16	D			09

No Rd from here

Mile Point	D	City Code	POP	Ave Day Trf	FED AID	X R E F	LEFT	CENTER	RIGHT	C O N D	L A N E	Widths	Types	R/W	Urban	FN
												L S R	L S R			

DATE: 02/28/95

00.25 A							***			2	20	D			09
00.25							====	1269 SAGEBRUSH RD		2	20	D			09
00.00 A							====	3023 LORAIN ST		2	20	D			09

00.00 CECIL ST

Mile Point	D	City Code	POP	Ave Day Trf	FED AID	X R E F	LEFT	CENTER	RIGHT	C O N D	L A N E	Widths	Types	R/W	Urban	FN
										D	E	S	S	S	S	

30 P 3024 RD 3023 AT RM 0.06 E 34 5N 28E RD 1269 AT RM 0.57 3024
 Co C Road# Begining Dir Sec Township Range Ending Road#

DATE: 02/28/95

02.52 A		****		2	18	0				09
02.52	<VACATED CO RDS>	====	1074	2	18	0				09
02.35		==		2	18	0				09
01.00		==	LODNG PEN STCK	2	18	0				09
00.57			R R OFFICE & STATION	2	18	0				09
00.51		==	3033 HERMSTN-HINKLE	2	18	0				09
00.50	R R HOTEL			2	18	0				09
00.39	OIL STORAGE TANK			2	18	0				09
00.21		==	3192	2	18	0				09
00.00 B			3193 BACK	2	18	0				09
00.00 A	UPRY	++++	4 TRAX	2	18	0				09
00.00										

Mile Point	D u p e	City Code	POP	Ave Day Trf	FED AID	X R E F	LEFT	CENTER	RIGHT	C O N D	L A N E S	Widths	Types	R/W	Urban	FN
											L S R	L S R				

30 P 3025 RAILWAY TRAX E 27 4N 28E VACATED COUNTY ROADS 3025
 Co C Road# Begining Dir Sec Township Range Ending Road#

DATE: 02/28/95

OREGON DEPARTMENT OF TRANSPORTATION
 Roadway Analysis 503/378-6277

30 P 3028 RD 1266 RM 1.52

SE 36

5N

28E

RD 1261 RM 0.58

ROAD NO: 3028

01.09	A						XXXX				1	08	U		09
01.09							====	1261 N OTT RD			1	08	U		09
00.25							==				1	08	U		09
00.00	A						====	1266 BAGGETT LN			1	08	U		09
00.00															

Mile Point	D	City Code	POP	Ave Day Trf	FED AID	X REF	LEFT	CENTER	RIGHT	C O N D	L A N E	Widths	Types	R/W	Urban	FN
												L S R	L S R			
												S S S	S S S			

30 P 3028 RD 1266 RM 1.52
Co C Road# Begining

SE 36 5N 28E RD 1261 RM 0.58
Dir Sec Township Range Ending

3028
Road#

OREGON DEPARTMENT OF TRANSPORTATION
Roadway Analysis 503/378-6277

DATE: 02/28/95

00.19 A	3370		XXXX							2	22	0		H	19
00.19	3370		====	1244 E THEATER LN						2	22	0		H	19
00.18	3370			HERMSTN CL						2	22	0		H	19
00.09				HERMSTN CL END LT						2	22	0		H	19
00.07				HERMSTN CL LT						2	22	0		H	19
00.03				HERMSTN CL END LT						2	22	0		H	19
00.00 A			====	1228 NE OREGON ST						2	22	0		H	19

00.00 NE NORTH ST

Mile Point	D u p e	City Code	POP	Ave Day Trf	FED AID	X R E F	LEFT	CENTER	RIGHT	Widths				Types		R/W	Urban	FN
										C	L	Widths		Types				
										O	A	L	S	R	L			

30 P 3029 RD 1229 RM 0.08
Co C Road# Beginning

N 02 4N 28E RD 1244 RM 0.56
Dir Sec Township Range Ending

3029 Road#

DATE: 02/28/95

30 P 3031 RD 1223 AT RM 0.75

E 07

4N

28E

1239 RM 2.23

ROAD NO: 3031

00.50	A						****			2	14	G		09
00.50							====	1239	AGNEW RD	2	14	G		09
00.27							< -	10	S WESTLAND 'F' CANAL	2	14	G		09
00.00	A						====	1223	LEWIS RD	2	14	G		09

Mile Point	D u p e	City Code	POP	Ave Day Trf	FED AID	X R E F	LEFT	CENTER	RIGHT	C O N D	L A N E S	Widths L S R	Types L S R	R/W	Urban	FN
------------	---------	-----------	-----	-------------	---------	---------	------	--------	-------	---------	-----------	--------------	-------------	-----	-------	----

30 P 3031 RD 1223 AT RM 0.75
Co C Road# Begining

E 07 4N 28E 1239 RM 2.23
Dir Sec Township Range Ending

3031
Road#

DATE: 02/28/95

OREGON DEPARTMENT OF TRANSPORTATION
Roadway Analysis 503/378-6277

00.20	A						****				1	12		D			09
00.20							====	1333 CURTIS RD			1	12		D			09
00.00	A						====	HY 333 HERMISTON HY			1	12		D			09

00.00

Mile Point	D	City Code	POP	Ave Day Trf	FED AID	X R E F	LEFT	CENTER	RIGHT	C O N D	L A N E S	Widths	Types	R/W	Urban	FN
												L S R	L S R			

DATE: 02/28/95

00.65	A		****						2	18	0				09
00.65			====	3025					2	18	0				09
00.60	A			90 DEG TURN LT					2	18	0				09
00.60			==						2	18	0				09
00.54	A			90 DEG TURN LT					2	18	0				09
00.54			==						2	18	0				09
00.42			====						2	18	0				09
00.00	A			1245 HERMSTN-HNKL B					2	18	0				09

00.00 HERMSTN-HINKLE RD

Mile Point	D u p e	City Code	POP	Ave Day Trf	FED AID	X R E F	LEFT	CENTER	RIGHT	Widths			Types			R/W	Urban	FN
										C	L		L	S	R			
										O	A		L	S	R			
										D	E	S	S	S	S			

30 P 3033 JCT RD 1245 RM 2.12 S 26 4N 28E JCT RD 3025 RM 0.51 3033
 Co C Road# Begining Dir Sec Township Range Ending Road#

DATE: 02/28/95

30 P 3035 RD 1175 RM 6.34

S 33

4N

29E

RD 1186 RM 0.50

ROAD NO: 3035

00.20	A						**** RD 1186 AHD			2	16	G			09
00.20							== 1186 OS RD			2	16	G			09
00.00	B						== 1184 TUTTLE RD			2	16	G			09
00.00	A						== 1175 STANFIELD LP			2	16	G			09

00.00 ATTERBURY RD

Mile Point	D u p e	City Code	POP	Ave Day Trf	FED AID	X R E F	LEFT	CENTER	RIGHT	Widths			Types			R/W	Urban	FN
										C	L		L	S	R			
										D	E	S	S	S	S			

30 P 3035 RD 1175 RM 6.34
Co C Road# Begining

S 33 4N 29E RD 1186 RM 0.50
Dir Sec Township Range Ending

3035
Road#

DATE: 02/28/95

OREGON DEPARTMENT OF TRANSPORTATION
Roadway Analysis 503/378-6277

30 P 3039 RD 1250 RM 2.81

NE 36

5N

28E

RD 1261 RM 0.26

ROAD NO: 3039

00.31	A						****			2	16	G			09
00.31							====	1261 N OTT RD		2	16	G			09
00.00	A						====	1250 W PUNKIN CTR R		2	16	G			09

00.00

Mile Point	D	City Code	POP	Ave Day Trf	FED AID	X REF	LEFT	CENTER	RIGHT	C O N D	L A N E S	Widths	Types	R/W	Urban	FN
												L S R	L S R			

30 P 3039 RD 1250 RM 2.81
Co C Road# Begining

NE 36 5N 28E RD 1261 RM 0.26
Dir Sec Township Range Ending

3039
Road#

DATE: 02/28/95

OREGON DEPARTMENT OF TRANSPORTATION
Roadway Analysis 503/378-6277

00.13	A						****			1	10	D			09
00.13							====	3013 MARGARET AVE		1	10	D			09
00.00	A						====	1278 POWER CITY RD		1	10	D			09
00.00															

Mile Point	D	City Code	POP	Ave Day Trf	FED AID	X REF	LEFT	CENTER	RIGHT	C O N D	L A N E	Widths	Types	R/W	Urban	FN
												L S R	L S R			

30 P 3042 RD 1001 RM 3.11

NE 13

4N

30E

RD 997 RM 1.91

ROAD NO: 3042

01.29	A						XXXX				1	12		D		09
01.29							====	997 TERNEY RD			1	12		D		09
00.16							==				1	12		D		09
00.00	A						==	1001 KILGORE RD			1	12		D		09
00.00																

Mile Point	D	City Code	POP	Ave Day Trf	FED AID	X REF	LEFT	CENTER	RIGHT	C O N D	L A N E S	Widths	Types	R/W	Urban	FN
												L S R	L S R			

30 P 3042 RD 1001 RM 3.11
Co C Road# Begining

NE 13
Dir Sec

4N
Township

30E
Range

RD 997 RM 1.91
Ending

3042
Road#

OREGON DEPARTMENT OF TRANSPORTATION
Roadway Analysis 503/378-6277

DATE: 02/28/95

01.85	A					XXXX				2	22	G			09
01.85						====	1239	AGNEW	RD	2	22	G			09
01.80							45	DEG	TURN	RT	2	22	G		09
01.40							45	DEG	TURN	RT	2	22	G		09
00.00	A					==	1231	WALKER	RD	BK	2	22	G		09

Mile Point	D	City Code	POP	Ave Day Trf	FED AID	X R E F	LEFT	CENTER	RIGHT	C O N D	L A N E S	Widths	Types	R/W	Urban	FN
												L S R	L S R			

DATE: 02/28/95

00.62	A		UMATILLA ORDANCE	****	DEPOT AHD	2	20	G							09
00.62				XX	LOCKED GATE	2	20	G							09
00.06				XX	BARRICADE	2	20	G							09
00.00	B			====	3046	2	20	G							09
00.00	A			====	1231 WALKER RD	2	2 18 2	G 0 G							09

00.00																
Mile Point	D	City Code	POP	Ave Day Trf	FED AID	X R E F	LEFT	CENTER	RIGHT	C O N D	L A N E S	Widths	Types	R/W	Urban	FN
												L S R	L S R			

01.31	A						****	WASHINGTON STATE AHD	2	20	G			09
01.31								XX	2	20	G			09
01.05								GRAIN ELEVATOR	2	20	G			09
00.57								XX	2	20	G			09
00.00	A						====	896 JUNIPER CAN RD	2	20	G			09

00.00

Mile Point	D u p e	City Code	POP	Ave Day Trf	FED AID	X R E F	LEFT	CENTER	RIGHT	Widths			Types			R/W	Urban	FN
										C O N D	L A N E	S S	R S	L S	R S			

30 P 3050 RD 3004 RM 1.52

E 10

3N

27E

DEAD END

ROAD NO: 3050

00.49 DDDD DEAD END 1 08 U 09

00.00 A ENTR UMATILLA CO ==== 3004 MORROW RD 1 08 U 09

00.00

Mile Point	D u p e	City Code	POP	Ave Day Trf	FED AID	X R E F	LEFT	CENTER	RIGHT	C O N D	L A N E	Widths L S R	Types L S R	R/W	Urban	FN
------------	---------	-----------	-----	-------------	---------	---------	------	--------	-------	---------	---------	--------------	-------------	-----	-------	----

30 P 3050 RD 3004 RM 1.52
Co C Road# Begining

E 10 3N 27E DEAD END
Dir Sec Township Range Ending

3050
Road#

DATE: 02/28/95

OREGON DEPARTMENT OF TRANSPORTATION
Roadway Analysis 503/378-6277

00.54 B		****		2	16	G			09
00.54 A		==	1169	2	16	G			09
00.54		==	PVT	2	16	G			09
00.00 A		====	1171 LOOP RD	2	16	G			09

00.00

Mile Point	D	City Code	POP	Ave Day Trf	FED AID	X R E F	LEFT	CENTER	RIGHT	C O N D	L A N E	Widths	Types	R/W	Urban	FN
												L S R	L S R			

30 P 3056 RD 1171 RM 0.19
Co C Road# Begining

NE 34 4N 29E RD 3055 RM 0.49
Dir Sec Township Range Ending

3056
Road#

OREGON DEPARTMENT OF TRANSPORTATION
Roadway Analysis 503/378-6277

DATE: 02/28/95

00.49	A					XXXX				1	10	D			09
00.49						====	1183	ATTERBURY	RD	1	10	D			09
00.38								POWERLINE	XING	1	10	D			09
00.05						B US FEED	CANAL	<)=	(16 40	PONY	T	1	10	D	09
00.00	A					====	1201	S EDWARDS	RD	1	10	D			09

Mile Point	D	City	POP	Ave	FED	X	LEFT	CENTER	RIGHT	C	L	Widths	Types	R/W	Urban	FN
u		Code		Day	AID	R				O	A	L	S	R		
e				Trf		E				N	N	S	S	S		
						F				D	E	S	S	S		

30 P 3058 RD 1300 RM 2.23

SW 21

3N

29E

SCL ECHO

ROAD NO: 3058

1355
Kernedy

00.49						****	SCL ECHO CITY AHD		1	12	G			09
00.03	A						90 DEG TURN RT		1	12	G			09
00.03						=	RAMOS LN		1	12	G			09
00.02							UP RY		1	12	G			09
00.00	A					====	1300 RIETH RD		1	12	G			09

00.00 RAILROAD ST (ECHO)

Mile Point	D u p e	City Code	POP	Ave Day Trf	FED AID	X R E F	LEFT	CENTER	RIGHT	Widths						R/W	Urban	FN
										L		S		R				
										N	S	L	S	L	S			

30 P 3058 RD 1300 RM 2.23
Co C Road# Begining

SW 21 3N 29E SCL ECHO
Dir Sec Township Range Ending

3058 Road#

DATE: 02/28/95

30 P 3059 1212 AT RM 9.68

N 11 4N 29E

RD 3081 AT RM 0.5

ROAD NO: 3059

00.38 A									*** HICKS LANE AHD	1	10	U		09
00.38									==== 3081 GRADY	1	10	U		09
00.00 A									==== 1172 E HIGHLAND EXT	1	10	U		09

00.00 HICKS LN

Mile Point	D u p e	City Code	POP	Ave Day Trf	FED AID	X R E F	LEFT	CENTER	RIGHT	C O N D	L A N E	Widths	Types	R/W	Urban	FN
												L S R	L S R			

30 P 3059 1212 AT RM 9.68
Co C Road# Begining

N 11 4N 29E RD 3081 AT RM 0.55
Dir Sec Township Range Ending

3059 Road#

OREGON DEPARTMENT OF TRANSPORTATION
Roadway Analysis 503/378-6277

DATE: 02/28/95

30 P 3060 RD 1198 AT RM 1.90

N 08

4N

29E

RD 1200 AT RM 7.7

ROAD NO: 3060

Mile Point	D	City Code	POP	Ave Day Trf	FED AID	X R E F	LEFT	CENTER	RIGHT	C O N D	L A N E S	Widths	Types	R/W	Urban	FN	
												L S R	L S R				
00.70	A							****				2	16			D	09
00.70								====	1208 HERMISTON LP R			2	16			D	09
00.15							S FURNISH DITCH	- >	16			2	16			D	09
00.00	A							====	1198 HIGHLAND EXT.			2	16			D	09
00.00							BROWN LN										

30 P 3060 RD 1198 AT RM 1.90
Co C Road# Begining

N 08
Dir Sec

4N

29E

RD 1200 AT RM 7.75
Ending

3060
Road#

DATE: 02/28/95

OREGON DEPARTMENT OF TRANSPORTATION
Roadway Analysis 503/378-6277

30 P 3061 RD 1198 AT RM 0.90

S 18

4N

29E

RD 1211 AT RM 0.9

ROAD NO: 3061

01.42	A					****				1	10	D		09
01.42						====	1211 S OTT RD			1	10	D		09
00.93						S IRRIG	- >	10		1	10	D		09
00.79							==	65 DEG TURN RT		1	10	D		09
00.77						S FURNISH DITCH	< -	18		1	10	D		09
00.50	A						==	3062		1	10	D		09
00.50							==	PVT		1	10	D		09
00.45								POWERLINE XING		2	16	D		09
00.37							==	3062		2	16	D		09
00.00	A						====	1198 HIGHLAND EXT.		2	16	D		09

00.00 MELODY LN

Mile Point	D	City POP	Ave Day Trf	FED AID	X R E F	LEFT	CENTER	RIGHT	C O N D	L A N E S	Widths				Types	R/W	Urban	FN
											L	S	R	S				

30 P 3061 RD 1198 AT RM 0.90
Co C Road# Begining

S 18 4N 29E RD 1211 AT RM 0.99
Dir Sec Township Range Ending

3061 Road#

30 P 3062 RD 1179 AT RM 0.18

SW 18

4N

29E

RD 3061 AT RM 0.5

ROAD NO: 3062

00.64 A							***			1	10		U			09
00.64							====	3061 MELODY LN		1	10		U			09
00.60								POWERLINE XING		1	10		U			09
00.00 A							====	1179 CANAL RD		1	10		U			09

00.00																
Mile Point	D	City Code	POP	Ave Day Trf	FED AID	X R E F	LEFT	CENTER	RIGHT	C O N D	L A N E S	Widths	Types	R/W	Urban	FN
												L S R	L S R			

30 P 3062 RD 1179 AT RM 0.18
Co C Road# Begining

SW 18
Dir Sec

4N 29E
Township Range

RD 3061 AT RM 0.50
Ending

3062
Road#

DATE: 02/28/95

OREGON DEPARTMENT OF TRANSPORTATION
Roadway Analysis 503/378-6277

30 P 3063 RD 1332 AT RM 1.83

N 36

4N

28E

DEAD END

ROAD NO: 3063

00.74		FARM		DDDD DEAD END		2	20	G		09
00.58		S		< - 10		2	20	G		09
00.49				90 DEG TURN RT		2	20	G		09
00.25		DILLON DITCH		<>(-		2	20	G		09
00.00 A				==== 1332 SANFIELD MDWS		2	20	G		09

00.00 EDELMAN LN

Mile Point	D u p e	City Code	POP	Ave Day Trf	FED AID	X R E F	LEFT	CENTER	RIGHT	C O N D	L A N E S	Widths	Types	R/W	Urban	FN	
											L S R	L S R					
											D E S	S S S					

30 P 3063 RD 1332 AT RM 1.83
Co C Road# Begining

N 36
Dir Sec

4N 28E
Township Range

DEAD END
Ending

3063
Road#

DATE: 02/28/95

OREGON DEPARTMENT OF TRANSPORTATION
Roadway Analysis 503/378-6277

00.20 DDDD DEAD END 1 08 U 09
 00.00 A ==== 1219 E 10TH ST 1 08 U 09

00.00

Mile Point	D u p e	City Code	POP	Ave Day Trf	FED AID	X R E F	LEFT	CENTER	RIGHT	C O N D	L A N E	Widths L S R	Types L S R	R/W	Urban	FN
------------	---------	-----------	-----	-------------	---------	---------	------	--------	-------	---------	---------	--------------	-------------	-----	-------	----

30 P 3064 RD 1219 AT RM 1.75 NE 01 4N 28E DEAD END 3064
 Co C Road# Begining Dir Sec Township Range Ending Road#

DATE: 02/28/95

30 P 3065 RD 1246 AT RM 1.04

S 05

4N

29E

DEAD END

ROAD NO: 3065

00.20 DDDD DEAD END 1 08 U 09

00.00 A ==== 1246 BAXTER RD 1 08 U 09

00.00 TOTTIE LN

Mile Point	D u p e	City Code	POP	Ave Day Trf	FED AID	X R E F	LEFT	CENTER	RIGHT	C O N D	Widths			Types			R/W	Urban	FN
											L	S	R	L	S	R			
											N	L	S	R	L	S			

30 P 3065 RD 1246 AT RM 1.04
Co C Road# Begining

S Dir

05 Sec

4N Township

29E Range

DEAD END Ending

3065 Road#

OREGON DEPARTMENT OF TRANSPORTATION
Roadway Analysis 503/378-6277

DATE: 02/28/95

03.60 B		***								1	08	U				09
03.60 A		==	3093							1	08	U				09
03.60		==	1172 KOSMOS RD							1	08	U				09
03.57			POWERLINE XING							1	08	U				09
01.59		==	1209							1	08	U				09
01.33			POWERLINE XING							1	08	U				09
00.98		====	1000 FEEDVILLE RD							1	08	U				09
00.95			POWERLINE XING							1	08	U				09
00.20			POWERLONE XING							1	08	U				09
00.00 A		====	1201 S EDWARDS RD							1	08	U				09

00.00

Mile Point	D	City	POP	Ave	FED	X	LEFT	CENTER	RIGHT	C	L	Widths	Types	R/W	Urban	FN
u		Code		Day	AID	R				O	A					
p				Trf		E				N	N	L S R	L S R			
e						F				D	E	S S	S S			

30 P 3066 JCT RD 1201 RM 4.75 NE 28 4N 29E JCT RDS 3093 & 1172 3066
 Co C Road# Begining Dir Sec Township Range Ending Road#

DATE: 02/28/95

OREGON DEPARTMENT OF TRANSPORTATION
 Roadway Analysis 503/378-6277

30 P 3067 RD 3251 AT MP 0.03

NE 27

4N

27E

DEAD END

ROAD NO: 3067

00.30							DDDD DEAD END			2	16	G				09
00.23										2	16	G				09
00.21							ORDNANCE RR DEPOT			2	22	0				09
00.13							100 DEG TURN RT			2	22	0				09
00.04 A							80 DEG TURN LT			2	22	0				09
00.04										2	22	0				09
00.00 A							==== 3251			2	22	0				09

00.00							(ORDNANCE)									
Mile Point	D	City Code	POP	Ave Day Trf	FED AID	X R E F	LEFT	CENTER	RIGHT	C O N D	L A N E	Widths	Types	R/W	Urban	FN
												L S R	L S R			

30 P 3067 RD 3251 AT MP 0.03
Co C Road# Begining

NE 27 4N 27E DEAD END
Dir Sec Township Range Ending

3067
Road#

DATE: 02/28/95

OREGON DEPARTMENT OF TRANSPORTATION
Roadway Analysis 503/378-6277

00.80 A							*** PVT AHD		2	18		D				09
00.80							== PVT		2	18		D				09
00.76							90 DEG TURN RT		2	18		D				09
00.51							==== 3190		2	18		D				09
00.10						B STANFIELD DRAIN	<)=(< 16 40 WOOD		2	18		D				09
00.00 A							==== 1175 STANFIELD LP		2	18		D				09

Mile Point	D	City Code	POP	Ave Day Trf	FED AID	X REF	LEFT	CENTER	RIGHT	C O N D	L A N E S	Widths	Types	R/W	Urban	FN
												L S R	L S R			

00.15	A						****			1	10	U		09
00.15							====	HY 333 HERMISTON HWY		1	10	U		09
00.00	A						==	1333 BACK		1	10	U		09

00.00

Mile Point	D	City POP	Ave Day Trf	FED AID	X R E F	LEFT	CENTER	RIGHT	C O N D	L A N E S	Widths	Types	R/W	Urban	FN
		Code									L S R	L S R			

DATE: 02/28/95

03.10						**** 1338 AHD				1	12	G			09
02.85						== 3071				1	12	G			09
02.83						==				1	12	G			09
02.57 A						====				1	12	G			09
02.57						B HUNT DITCH	325	<)=	(24 28 WOOD	1	12	G			09
01.48						== 3198				1	08	U			09
00.63						POWERLINE XING				1	08	U			09
00.00 A						== 1333 BACK				1	08	U			09

Mile Point	D u p e	City Code	POP	Ave Day Trf	FED AID	X R E F	LEFT	CENTER	RIGHT	C O N D	L A N E	Widths L S R	Types L S R	R/W	Urban	FN
------------	---------	-----------	-----	-------------	---------	---------	------	--------	-------	---------	---------	--------------	-------------	-----	-------	----

01.26							****	1337 ROSENBERG RDAH	2	20	G			09
01.25)		2	20	G			09
01.01							==	1342 HOUSER RD	2	20	G			09
00.50									2	20	G			09
00.00 A							====	3070 EMIGRNT BTT RD	1	10	D			09
00.00														

Mile Point	D u p e	City Code	POP	Ave Day Trf	FED AID	X R E F	LEFT	CENTER	RIGHT	C O N D	L A N E	Widths				Types		R/W	Urban	FN
												L	S	R	L	S	R			

30 P 3071 JCT RD 3070 RM 2.85 S 11 3N 28E JCT RD 1337 RM 1.82 3071
 Co C Road# Begining Dir Sec Township Range Ending Road#

DATE: 02/28/95

01.05	A					****				2	16	U			09
01.05						====	HY 320			2	16	U			09
00.62						==	3199			2	16	U			09
00.50						==	3199 LEG			2	16	U			09
00.00	A					====	1343	Whitehouse Rd		2	16	U			09

Mile Point	D	City Code	POP	Ave Day Trf	FED AID	X R E F	LEFT	CENTER	RIGHT	C O N D	L A N E S	Widths	Types	R/W	Urban	FN
												L S R	L S R			

DATE: 02/28/95

00.20	A					****				2	16	0			09
00.20						====				2	16	0			09
00.15						==				2	16	0			09
00.00	A					====	HWY 36 COLD SPRS HY			2	16	0			09

00.00 SPUR ROAD

Mile Point	D u p e	City Code	POP	Ave Day Trf	FED AID	X R E F	LEFT	CENTER	RIGHT	Widths			Types			R/W	Urban	FN
										C	L		L	S	R			
										D	E	S	S	S	S			

00.40 **** FOSTER CEMETERY 1 08 G 09

00.00 A ==== HWY 54 US 395 1 08 G 09

00.00 FOSTER CEM RD

Mile Point	D u p e	City Code	POP	Ave Day Trf	FED AID	X R E F	LEFT	CENTER	RIGHT	C O N D	L A N E	Widths				Types			R/W	Urban	FN
												L	S	R	S	L	S	R			

30 P 3076 JCT HWY 54 MP 12.11 W 05 3N 29E FOSTER CEMETERY 3076
 Co C Road# Begining Dir Sec Township Range Ending Road#

DATE: 02/28/95

00.51	A						****			2	24	G			09
00.51							====	3078 TOBIN LN		2	24	G			09
00.26								<i>Tobin Ln</i> ====	1000 FEEDVILLE RD	2	24	G			09
00.00	A							==	1175 NORTH LOOP	2	24	G			09

Subransky Ln

Mile Point	D	City Code	POP	Ave Day Trf	FED AID	X REF	LEFT	CENTER	RIGHT	C O N D	L A N E	Widths	Types	R/W	Urban	FN
												L S R	L S R			

DATE: 02/28/95

00.89							DDDD DEAD END			1	12	G			09
00.50							== 3077 ZABRANSKY LN			1	12	G			09
00.00 A							==== 1175 NORTH LOOP			2	24	G			09

00.00 TOBIN LN

Mile Point	D	City Code	POP	Ave Day Trf	FED AID	X R E F	LEFT	CENTER	RIGHT	C O N D	L A N E S	Widths	Types	R/W	Urban	FN
												L S R	L S R			

30 P 3079 RD 1175 AT RM 2.00

E 23

4N

29E

DEAD END

ROAD NO: 3079

00.45							DDDD DEAD END			1	10	D			09
00.00	B						==== 1190 NORTH LOOP			1	10	D			09
00.00	A						3080 ROPER LN BK			1	10	D			09

00.00 ROPER LN

Mile Point	D	City	POP	Ave	FED	X	LEFT	CENTER	RIGHT	C	L	Widths	Types	R/W	Urban	FN
u		Code		Day	AID	R				O	A					
p				Trf		E				N	N	L S R	L S R			
e						F				D	E	S S S	S S S			

30 P 3079 RD 1175 AT RM 2.00

E 23

4N

29E

DEAD END

3079

Co C Road# Begining

Dir

Sec

Township

Range

Ending

Road#

DATE: 02/28/95

OREGON DEPARTMENT OF TRANSPORTATION
Roadway Analysis 503/378-6277

00.50						DDDD DEAD END				1	10	D			09
00.26 A			N CALHOUN LN			90 DEG TURN RT				1	10	D			09
00.26						== ROPER LANE				1	10	D			09
00.00 B						==== 1190 NORTH LOOP RD				1	10	D			09
00.00 A			ROPER LN			3079 ROPER LN BACK				1	10	D			09

Calhoun Ln

Mile Point	D	City Code	POP	Ave Day Trf	FED AID	X R E F	LEFT	CENTER	RIGHT	C O N D	L A N E	Widths	Types	R/W	Urban	FN
												L S R	L S R			

DATE: 02/28/95

30 P 3081 1190 RM 5.54

S 11

4N

29E

PVT RD

ROAD NO: 3081

00.70	A						****			2	14	D			09
00.70							==	HICKS LN		2	14	D			09
00.55							==	3059 HICKS LN		2	14	D			09
00.41								90 DEG TURN RT		2	14	D			09
00.00	A						====	1190 EAST LOOP RD		2	14	D			09

00.00 GRADY LN

Mile Point	D u p e	City Code	POP	Ave Day Trf	FED AID	X R E F	LEFT	CENTER	RIGHT	Widths			Types			R/W	Urban	FN
										C O N D	L A N E S	L S R	L S R	L S R				

30 P 3081 1190 RM 5.54
Co C Road# Begining

S 11 4N 29E PVT RD
Dir Sec Township Range Ending

3081
Road#

OREGON DEPARTMENT OF TRANSPORTATION
Roadway Analysis 503/378-6277

DATE: 02/28/95

00.49		ENTER WASHINGTON	**** STATE	2	24	G	09
00.45		TURN LEFT		2	24	G	09
00.16			TURN RT	2	24	G	09
00.02		TURN LEFT		2	24	G	09
00.00 B			== 717 BUTLER GRADE R	2	24	G	09
00.00 A		700 BACK	STATE LINE RD	2	24	G	09
00.00		STATE LINE RD					

Mile Point	D u p e	City Code	POP	Ave Day Trf	FED AID	X R E F	Direction			Widths						Types	R/W	Urban	FN
							LEFT	CENTER	RIGHT	L		S		R					
										L	S	L	S	L	S				

30 P 3082 JCT RDS 700 & 717 W 13 6N 33E WASHINGTON STATE LINE 3082
 Co C Road# Begining Dir Sec Township Range Ending Road#

DATE: 02/28/95

00.85 A						****				1	12	D			09
00.85						====	1100 STAGE GULCH RD			1	12	D			09
00.07						-)((>				1	12	D			09
00.00 B						==	1096			1	12	D			09
00.00 A							1093 HOWDY SHELL RD			1	12	D			09
00.00															

Mile Point	D u p e	City Code	POP	Ave Day Trf	FED AID	X R E F	LEFT	CENTER	RIGHT	C O N D	Widths				Types	R/W	Urban	FN
											L	N	S	R				
											A	L	S	R				

00.75	A					XXXX				2	22	G		09
00.75						====	3086 STATE PARK RD			2	22	G		09
00.00	A					====	3086			2	22	G		09

00.00 HAT ROCK RD

Mile Point	D	City	POP	Ave	FED	X	LEFT	CENTER	RIGHT	C	L	Widths	Types	R/W	Urban	FN
u		Code		Day	AID	R				O	A					
p				Trf		E				N	N	L S R	L S R			
e						F				D	E	S S S	S S S			

30 P 3084 JCT RD 3086 AT RM 0.20 E 15 5N 29E JCT RDS 3086 & 3500 ROAD# 3084
 Co C Road# Begining Dir Sec Township Range Ending

DATE: 02/28/95

00.12 DDDD DEAD END 2 18 0 P 19

00.00 A ==== 986 NE RIVERSDE AV 2 18 0 P 19

00.00 NE ANVIDON ST

Mile Point	D	City POP	Ave Day Trf	FED AID	X REF	LEFT	CENTER	RIGHT	C O N D	L A N E	Widths	Types	R/W	Urban	FN
		Code									L S R	L S R			
											S S	S S			

30 P 3085 RD 986 AT RM 0.20
Co C Road# Begining

S Dir

01 Sec

2N Township

32E Range

DEAD END Ending

3085 Road#

00.35							DDDD DEAD END			2	22	0			09
00.20							== 3084			2	22	0			09
00.00 B							== 3084			2	22	0			09
00.00 A							3500 HAT RK ST PK R			2	22	0			09
00.00															

Mile Point	D u p e	City Code	POP	Ave Day Trf	FED AID	X R E F	LEFT	CENTER	RIGHT	C O N D	L A N E	Widths	Types	R/W	Urban	FN
											L S R	L S R				
										D E S	S S S	S S S				

30 P 3086 CONT RD 3500 AT RM 0.95 N 15 5N 29E DEAD END 3086
 Co C Road# Begining Dir Sec Township Range Ending Road#

DATE: 02/28/95

00.37 DDDD DEAD END 1 12 D 09

00.00 A ==== 697 HARRIS RD 1 12 D 09

00.00 ERNEST LANE


Mile Point	D	City Code	POP	Ave Day Trf	FED AID	X REF	LEFT	CENTER	RIGHT	C O N D	L A N E	Widths	Types	R/W	Urban	FN
												L S R	L S R			
												S S S	S S S			

DATE: 02/28/95

00.20	A						****			1	12		D			09			
00.20							HWY 334	====	ATHENA-HOLDMAN HWY	1	12		D			09			
00.00	A							====	975 MYRICK RD	1	12		D			09			
00.00							(MYRICK)												
Mile Point	D	City Code	POP	Ave Day Trf	FED AID	X REF	LEFT		CENTER		RIGHT		C O N D	L A N E	Widths L S R	Types L S R	R/W	Urban	FN

07.11 A				****					2	14	D			09
07.11				==	PVT				2	14	D			09
06.74					POWERLINE XING				2	14	D			09
06.26 A					N UMBARGER LN				2	14	D			09
06.26	0000			====	END CO JURIS			932 TUTMILLA CHURH	2	14	D			09
06.06	0000				BEG CO JURIS-RD 929				2	18	G			09
05.24				====				936 LLOYD RD	2	18	G			09
04.23				< -	S S COYOTE CR			6	2	18	G			09
04.22				====				950 BEST RD	2	18	G			09
03.25				==	IMPASSABLE>			1026 CONNER RD	2	14	D			09
02.53				<)<-					2	14	D			09
02.24				<)<-					2	14	D			09
02.23				====				1032 HOLMES RD	2	14	D			09
01.57				<)<-	TUTUILLA CR				2	14	D			09
00.00 A				====				1050 SPRING CR RD	2	14	D			09

00.00					POND RD											
Mile Point	D u p e	City Code	POP	Ave Day Trf	FED AID	X R E F	LEFT	CENTER	RIGHT	C O N D	L A N E S	Widths L S R	Types L S R	R/W	Urban	FN

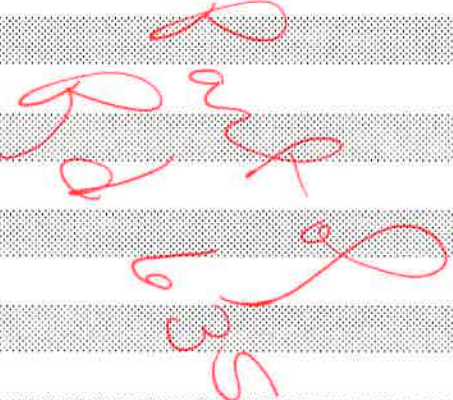

00.11			DDDD	DEAD END	1	10	D			09
00.10			-)(>		1	10	D			09
00.00 A			====	HY 330 ORE 204	1	10	D			09
00.00										

Mile Point	D	City Code	POP	Ave Day Trf	FED AID	X R E F	LEFT	CENTER	RIGHT	C O N D	L A N E S	Widths	Types	R/W	Urban	FN
												L S R	L S R			

30 P 3090 HWY 330 AT MP 6.55 S 28 4N 36E DEAD END 3090
 Co C Road# Begining Dir Sec Township Range Ending Road#

04.30	A					****				1	10	U			09
04.30						====	899	LAMPDIN	RD	1	10	U			09
00.72						<---				1	10	U			09
00.59						--->				1	10	U			09
00.00	B					<---				1	10	U			09
00.00	A					====	897			1	10	U			09
00.00															

Mile Point	D u p e	City Code	POP	Ave Day Trf	FED AID	X R E F	LEFT	CENTER	RIGHT	C O N D		L A N E S				Widths	Types	R/W	Urban	FN				
										L	A	N	E	S	S						L	S	R	S

30 P 3091 RD 897 AT RM 1.52 NW 28 6N 32E RD 899 AT RM 4.30 3091
 Co C Road# Beginning Dir Sec Township Range Ending Road#

DATE: 02/28/95

01.03	A						****	RD 836 AHD		1	08	U			09
01.03							==	836 KOEPCKE RD		1	08	U			09
00.34										1	08	U			09
00.25					S		- >			1	08	G			09
00.00	A						====	983 BREEDING RD		1	08	G			09
00.00															

Campbell

Mile Point	D	City Code	POP	Ave Day Trf	FED AID	X R E F	LEFT	CENTER	RIGHT	C O N D	L A N E	Widths	Types	R/W	Urban	FN
												L S	R S			

Handwritten red scribbles and lines, possibly initials or a signature.

02.17 A						****	1172 AHD E HIGHLAND		2	18	G		09
02.17						==	3066		2	18	G		09
02.08							POWERLINE XING		2	18	G		09
01.00						====	1209 WEBSTER RD		2	18	G		09
00.50						==	LEHMANS LN		2	18	G		09
00.00 A						====	1201 S EDWARDS RD		2	18	G		09
00.00							E HIGHLAND EXT						

Mile Point	D u p e	City Code	POP	Ave Day Trf	FED AID	X R E F	LEFT	CENTER	RIGHT	Widths			Types			R/W	Urban	FN
										C	L		L	S	R			
										O	A	N	N	S	S			

00.10							DDDD DEAD END			2	18	0			09
00.08							90 DEG TURN LT			2	18	0			09
00.06							90 DEG TURN RT			2	18	0			09
00.00 A							==== HWY 54 US 395			2	18	0			09
00.00															

Mile Point	D	City Code	POP	Ave Day Trf	FED AID	X REF	LEFT	CENTER	RIGHT	C O N D	L A N E S	Widths	Types	R/W	Urban	FN
												L S R	L S R			

30 P 3094 HWY 54 AT MP 0.85 W 22 5N 28E DEAD END 3094
 Co C Road# Begining Dir Sec Township Range Ending Road#

DATE: 02/28/95

30 P 3096 HWY 8 AT MP 0.65

SE 01

2N

32E

HWY 8 AT MP 0.50

ROAD NO: 3096

00.19 A						****				2	16	0		P	19
00.19						==== HWY 8 ORE-WASH HY				2	16	0		P	19
00.06										2	16	0		P	19
00.00 A						==== HWY 8 ORE-WASH HY				2	16	G		P	19
00.00															

Mile Point	D u p e	City Code	POP	Ave Day Trf	FED AID	X R E F	LEFT	CENTER	RIGHT	Widths						R/W	Urban	FN
										C O N D		L A N E S		Types				
										L	R	L	R	L	R			

30 P 3096 HWY 8 AT MP 0.65
Co C Road# Begining

SE 01
Dir Sec

2N 32E
Township Range

HWY 8 AT MP 0.50
Ending

3096
Road#

OREGON DEPARTMENT OF TRANSPORTATION
Roadway Analysis 503/378-6277

DATE: 02/28/95

30 P 3098 HWY 8 AT MP 16.43

E 19

4N

35E

RD 685 AT RM 0.42

ROAD NO: 3098

00.38	A						****				1	12		G			09								
00.38							====	689	BROOK RD		1	12		G			09								
00.11											1	12		G			09								
00.00	A								<i>Brook</i>	====	HWY 8	ORE-WASH	HY		2	4	24	4	G	A	G			09	
00.00									CAMPBELL	RD															

Mile Point	D	City	POP	Ave	FED	X	LEFT	CENTER	RIGHT	C	L	Widths	Types	R/W	Urban	FN	
u		Code		Day	AID	R				O	A						
e				Trf		E				N	N	L	S	R	L	S	R
						F				D	E	S	S	S	S	S	

30 P 3098 HWY 8 AT MP 16.43

E 19

4N

35E

RD 685 AT RM 0.42

3098

Co C Road# Begining Dir Sec Township Range Ending Road#

DATE: 02/28/95

OREGON DEPARTMENT OF TRANSPORTATION
Roadway Analysis 503/378-6277

Mile Point	D	City Code	POP	Ave Day Trf	FED AID	X R E F	LEFT	CENTER	RIGHT	C O N D	L A N E	Widths L S R	Types L S R	R/W	Urban	FN
00.38	A							XXXX			1	10	D			09
00.38								==== 683 3RD ST			1	10	D			09
00.25							N CENTER ST	90 DEG TURN RT			1	10	D			09
00.00	A							==== HWY 8 ORE-WASH HY			1	10	D			09
00.00							1ST ST (ATHENA)									

30 P 3099 HWY 8 AT MP 16.30 N 19 4N 35E 683 RM 0.23 3099
 Co C Road# Begining Dir Sec Township Range Ending Road#

DATE: 02/28/95

OREGON DEPARTMENT OF TRANSPORTATION
 Roadway Analysis 503/378-6277

00.29	A			ENTR UMATILLA NAT	**** FOR NFD RD AHD					1	08	U		09
00.29				T 35 R 31-32 E SEC	36 & 32 1/4 COR 231S					1	08	U		09
00.00	B				1405 YLLW JKT RDBU					1	08	U		09
00.00	A				== 1419 P RK-JN DAY RD					1	08	U		09

Mile Point	D	City POP	Ave Day Trf	FED AID	X R F	LEFT	CENTER	RIGHT	C O N D	L A N E	Widths	Types	R/W	Urban	FN
											L S R	L S R			

30 P 3101 JCT RDS 1405 & 1419 SE 36 3S 31E UMATILLA NAT FOREST 3101
 Co C Road# Begining Dir Sec Township Range Ending Road#

DATE: 02/28/95

00.67	A						****	CHUCKHOLE LN AHD		1	12	G				09
00.67							====	3127 YELLOWJACKET		1	12	G				09
00.23							S	HUDSON BAY CANAL	<	14		G				09
00.04								PLEASANT VIEW CANAL	<)			G				09
00.00	A						====	650 COUNTY RD		1	12	G				09

00.00 CHUCKHOLE LANE

Mile Point	D u p e	City Code	POP	Ave Day Trf	FED AID	X R E F	LEFT	CENTER	RIGHT	Widths		Types		R/W	Urban	FN
										C O N D	L A N E	L S	R S			

00.08	A									DDDD DEAD END 4 CABINS	1	10	G		09
00.08											1	10	G		09
00.00	A									==== 1047	1	10	G		09

00.00 (MEACHAM)

Mile Point	D	City Code	POP	Ave Day Trf	FED AID	X REF	LEFT	CENTER	RIGHT	C O N D	L A N E	Widths	Types	R/W	Urban	FN
												L S R	L S R			
												S S S	S S S			

30 P 3104 RD 3107 AT RM 0.10 N 03 1S 35E DEAD END 3104
 Co C Road# Beginning Dir Sec Township Range Ending Road#

DATE: 02/28/95

30 P 3105 HWY 8 AT MP 30.77

E 01

5N

35E

DEAD END

ROAD NO: 3105

00.19								DDDD DEAD END		2	20	G		M	19
00.18								S STILLMAN DITCH < -		2	20	G		M	19
00.06								ECL MILTON-FRWTR CITY BACK		2	20	G		M	19
00.05	0000	0)C		2	20	G		M	19
00.00 A	0000	0						==== HWY 8 ORE WASH HY		2	20	G		M	19

00.00 SE 2ND AVE

Mile Point	D u p e	City Code	POP	Ave Day Trf	FED AID	X R E F	LEFT	CENTER	RIGHT	Widths						R/W	Urban	FN
										C		L		Types				
										O	N	L	S	R	L			
										D	E	S	S	S	S			

30 P 3105 HWY 8 AT MP 30.77
Co C Road# Beginning

E 01 5N 35E DEAD END
Dir Sec Township Range Ending

3105 Road#

DATE: 02/28/95

OREGON DEPARTMENT OF TRANSPORTATION
Roadway Analysis 503/378-6277

00.19							DDDD DEAD END		1	12	G		M	19
00.17							STILLMAN DITCH <)<-		1	12	G		M	19
00.14							<)<-		1	12	G		M	19
00.06							END CL MILTON-F RT		1	12	G		M	19
00.00 B							ECL MILTON-FRWTR CITY BACK		1	12	G		M	19
00.00 A							==== HWY 8 ORE-WASH HY		1	12	G		M	19
00.00							SE 1ST AVE							

Mile Point	D u p e	City Code	POP	Ave Day Trf	FED AID	X R E F	LEFT	CENTER	RIGHT	C O N D	L A N E S	Widths	Types	R/W	Urban	FN
											L S R	L S R				

DATE: 02/28/95

00.12 A						XXXX				1	12	G			09
00.12						==== HWY 6 MEACHAM FR RD				1	12	G			09
00.09						XX				1	12	G			09
00.00 A						==== 1048 WTHER BUREAU R				1	12	G			09

00.00 (MEACHAM)

Mile Point	Du p e	City Code	PDP	Ave Day Trf	FED AID	X R E F	LEFT	CENTER	RIGHT	C O N D	L A N E S	Widths L S R	Types L S R	R/W	Urban	FN
------------	--------	-----------	-----	-------------	---------	---------	------	--------	-------	---------	-----------	--------------	-------------	-----	-------	----

30 P 3108 RD 1048 AT RM 0.06
Co C Road# Begining

SE 10 1S 35E FRONTAGE RD MPF239.85
Dir Sec Township Range Ending

3108
Road#

DATE: 02/28/95

OREGON DEPARTMENT OF TRANSPORTATION
Roadway Analysis 503/378-6277

00.23	A				****				2	20	0				09
00.23					====	3110 "J" ST			2	20	0				09
00.16						ECL UMATILLA CITY BK			2	20	0				09
00.07		0000	0		==	TUCKER AVE			2	20	0				09
00.00	A	0000	0		====	1225 POWER LINE RD			2	20	0				09

00.00						STEPHENS AVE (UMATIL										
Mile Point	D u p e	City Code	PDP	Ave Day Trf	FED AID	X R E F	LEFT	CENTER	RIGHT	C O N D	L A N E	Widths L S R	Types L S R	R/W	Urban	FN

00.22		DEAD END		DDDD					2	20	0				09
00.19				==		3109 STEPHENS AVE			2	20	0				09
00.17 A						N 'J' ST			2	20	0				09
00.17						90 DEG TURN LT			2	20	0				09
00.10						ECL UMATILLA CITY BK			2	20	0				09
00.00 A	0000	0				==== 3109 STEPHENS AVE			2	20	0				09

00.00						TUCKER AVE (UMATILLA)										
Mile Point	D u p e	City Code	POP	Ave Day Trf	FED AID	X R E F	LEFT	CENTER	RIGHT	C O N D	L A N E	Widths	Types	R/W	Urban	FN
												L S	R S	L S	R S	

30 P 3111 HWY 8 AT MP 35.07

E 13

6N

35E

RD 505 RM 0.25

ROAD NO: 3111

00.11 DDDD DEAD END 1 10 G 09

00.00 A ==== HWY 8 ORE-WASH HY 1 10 G 09

00.00

Mile Point	D u p e	City Code	POP	Ave Day Trf	FED AID	X R E F	LEFT	CENTER	RIGHT	C O N D	L A N E	Widths	Types	R/W	Urban	FN
												L S R	L S R			
												D E S	S S S			

30 P 3111 HWY 8 AT MP 35.07
Co C Road# Begining

E Dir

13 Sec

6N Township

35E Range

RD 505 RM 0.25 Ending

3111 Road#

OREGON DEPARTMENT OF TRANSPORTATION
Roadway Analysis 503/378-6277

DATE: 02/28/95

00.89	A							**** RD 716 AHD	2	14	D			09
00.89								== 716 BARNS-ST LINE	2	14	D			09
00.61							SOUTH DITCH	-)((>	2	14	D			09
00.37								90 DEG TURN RT	2	14	D			09
00.10								-)((>	2	14	D			09
00.00	A							== 717 BUTLER GRD RD	2	14	D			09

00.00

Mile Point	D	City Code	POP	Ave Day Trf	FED AID	X REF	LEFT	CENTER	RIGHT	C O N D	L A N E S	Widths	Types	R/W	Urban	FN
												L S R	L S R			

DATE: 02/28/95

01.30 A						XXXX				1	12	G			09
01.30						====	1383 P	RK-CMBS	CN R	1	12	G			09
00.97										1	12	G			09
00.95							S GEORGE	CANYON	- >	1	08	D			09
00.94									==	1	08	D			09
00.29									--->	1	08	D	FORD		09
00.24							90 DEG	TURN LT		1	08	D			09
00.00 A							==	1376 W.E.	GRNDE-HFT	1	08	D			09

Mile Point	D	City Code	POP	Ave Day Trf	FED AID	X R E F	LEFT	CENTER	RIGHT	C O N D	L A N E	Widths	Types	R/W	Urban	FN
												L S	R S			
												S	S			

30 P 3113 JCT RD 1376 RM 2.03 N 33 1N 32E JCT RD 1383 RM 0.92 3113
 Co C Road# Begining Dir Sec Township Range Ending Road#

DATE: 02/28/95

00.50	A					XXXX				2	24	G			09
00.50						====	518	BALLOU RD		2	24	G			09
00.00	A					====	522	FERNDAL RD		2	24	G			09

00.00 HURST LN																
Mile Point	D	City Code	POP	Ave Day Trf	FED AID	X R E F	LEFT	CENTER	RIGHT	C O N D	L A N E	Widths L S R	Types L S R	R/W	Urban	FN

00.10 DDDD DEAD END 1 08 G 09

00.00 A ==== HWY 332 1 08 G 09

00.00

Mile Point	D	City Code	POP	Ave Day Trf	FED AID	X R E F	LEFT	CENTER	RIGHT	C O N D	L A N E S	Widths	Types	R/W	Urban	FN
												L S R	L S R			

30 P 3115 HWY 332 AT MP 6.45
Co C Road# Begining

N 27 6N 35E DEAD END
Dir Sec Township Range Ending

3115
Road#

DATE: 02/28/95

OREGON DEPARTMENT OF TRANSPORTATION
Roadway Analysis 503/378-6277

00.24	A							XXXX		2	24	G			09
00.24								==		2	24	G			09
00.00	A							==== HWY 332		2	24	G			09

00.00 PRESTON LN																
Mile Point	DuPe	City Code	POP	Ave Day Trf	FED AID	XREF	LEFT	CENTER	RIGHT	CODING	LANES	Widths	Types	R/W	Urban	FN
												L S R	L S R			
												L S R	L S R			

DATE: 02/28/95

00.20	A					XXXX				2	18	0				09
00.20						====	HWY 332			2	18	0				09
00.15							90 DEG TURN LT			2	18	0				09
00.00	A					====	521 RINGER RD			2	18	0				09

00.00 (UMAPINE)

Mile Point	Direction	City Code	POP	Ave Day Trf	FED AID	X REF	LEFT	CENTER	RIGHT	Widths		Types		R/W	Urban	FN
										L	R	L	R			
										CON	LAN	DES	SSS			

00.50	A					XXXX				2	16	0				09
00.50						====	HY 332			2	16	0				09
00.25						<>(-				2	16	0				09
00.00	A					==	3127 YELLOWJACKET			2	16	0				09

YELLOWJACKET RD																
Mile Point	D	City Code	POP	Ave Day Trf	FED AID	X R E F	LEFT	CENTER	RIGHT	C O N D	L A N E	Widths	Types	R/W	Urban	FN
												L S	R S			
												S	S			

30 P 3119 RD 3127 RM 0.53 N 34 6N 35E HWY 332 MP 6.18 3119
 Co C Road# Begining Dir Sec Township Range Ending Road#

DATE: 02/28/95

OREGON DEPARTMENT OF TRANSPORTATION
 Roadway Analysis 503/378-6277

30 P 3121 HWY 339 AT MP 0.61 E 14 6N 35E DEAD END

Mile Point	D	City	POP	Ave	FED	X	LEFT	CENTER	RIGHT	C	L	Widths	Types	R/W	Urban	FN
u		Code		Day	AID	R				O	A					
p				Trf		E				N	N	L S R	L S R			
e						F				D	E	S S	S S			
00.28								DDDD	DEAD END		1	10	D			09
00.25							WWV RY	++++			1	10	D			09
00.00	A							====	HY 339 FREEWATER HY		1	10	D			09
00.00							YATE LN									

30 P 3121 HWY 339 AT MP 0.61 E 14 6N 35E DEAD END 3121
 Co C Road# Begining Dir Sec Township Range Ending Road#

DATE: 02/28/95

OREGON DEPARTMENT OF TRANSPORTATION
 Roadway Analysis 503/378-6277

30 P 3122 RD 825 AT RM 3.22

E 06

4N

34E

DEAD END

ROAD NO: 3122

00.21							DDDD DEAD END			1	10	G			09
00.03							-)<>			1	10	G			09
00.00 A							==== 825 SAND HOLLOW RD			1	10	G			09
00.00															

Mile Point	D u p e	City Code	POP	Ave Day Trf	FED AID	X R E F	LEFT	CENTER	RIGHT	C O N D	L A N E	Widths L S R	Types L S R	R/W	Urban	FN
------------	---------	-----------	-----	-------------	---------	---------	------	--------	-------	---------	---------	--------------	-------------	-----	-------	----

30 P 3122 RD 825 AT RM 3.22
Co C Road# Begining

E 06
Dir Sec

4N
Township

34E
Range

DEAD END
Ending

3122
Road#

OREGON DEPARTMENT OF TRANSPORTATION
Roadway Analysis 503/378-6277

DATE: 02/28/95

00.32 A		XXXX							1	10	G			09
00.32		==	CEM						1	10	G			09
00.22		==	ECHO CEMETERY						1	10	G			09
00.07		-)(>							1	10	G			09
00.00 A		====	1300 OLD PNDLTN RVR						1	10	G			09

00.00 ECHO CEMETERY RD

Mile Point	D	City Code	POP	Ave Day Trf	FED AID	X R E F	LEFT	CENTER	RIGHT	C O N D	L A N E S	Widths	Types	R/W	Urban	FN
												L S R	L S R			

00.53	A					****				2	16	G			09
00.53						==	3119	YELLW	JACKT	RD	2	16	G		09
00.51						S POWELL	DITCH	- >	8	2	16	G			09
00.39								-)(>		2	14	0			09
00.26						==	3102	CHUCKHOLE	LN	2	14	0			09
00.00	A					====	625	WINESAP	RD	2	14	0			09

00.00 YELLOWJACKET RD																
Mile Point	D	City Code	POP	Ave Day Trf	FED AID	X REF	LEFT	CENTER	RIGHT	C O N D	L A N E	Widths	Types	R/W	Urban	FN
												L S R	L S R			

01.15 ABAND BARN DDDD DEAD END 1 12 D 09
 00.00 A 624 PEA RIDGE RD BK 1 12 D 09

00.00 PEA RIDGE RD

Mile Point	D u p e	City Code	POP	Ave Day Trf	FED AID	X R E F	LEFT	CENTER	RIGHT	C O N D	Widths				Types		R/W	Urban	FN
											L	N	S	R	L	S			

00.06							DDDD DEAD END			1	08	D	P	19
00.03							90 DEG TURN RT			1	08	D	P	19
00.00 A							==== 986 NE RIVERSDE AV			1	08	D	P	19

00.00 NE 41TH ST

Mile Point	D u p e	City Code	POP	Ave Day Trf	FED AID	X R E F	LEFT	CENTER	RIGHT	Widths			Types			R/W	Urban	FN
										C O N D	L A N E	S R S	L S S	L S S				

DATE: 02/28/95

00.04 DDDD DEAD END 1 12 G P 19
 00.00 A ==== 986 NE RIVERSDE AV 1 12 G P 19

00.00 NE 42ND ST

Mile Point	D u p e	City Code	POP	Ave Day Trf	FED AID	X R E F	LEFT	CENTER	RIGHT	C O N D	L A N E S	Widths	Types	R/W	Urban	FN
												L S R	L S R			
												D E S	S S S			

30 P 3131 RD 986 AT RM 0.73 N 06 2N 33E DEAD END 3131
 Co C Road# Begining Dir Sec Township Range Ending Road#

DATE: 02/28/95

00.04 DDDD DEAD END 2 14 G P 19

00.00 A ==== 986 NE RIVERSDE AV 2 14 G P 19

00.00 NE 43ND ST

Mile Point	D u p e	City Code	POP	Ave Day Trf	FED AID	X R E F	LEFT	CENTER	RIGHT	C O N D	L A N E	Widths				Types			R/W	Urban	FN
												L	S	R	L	S	R				
												S	S	S	S	S					

30 P 3133 RD 986 AT RM 0.80

S 06

2N

33E

DEAD END

ROAD NO: 3133

00.06 A							DDDD DEAD END				1	12	G		P	19
00.06							== NE QUEEN AVE				1	12	G		P	19
00.00 A							==== 986 NE RIVERSDE AV				1	12	G		P	19

00.00 NE 43ND ST

Mile Point	D	City Code	POP	Ave Day Trf	FED AID	X R E F	LEFT	CENTER	RIGHT	C O N D	L A N E	Widths	Types	R/W	Urban	FN
												L S R	L S R			

30 P 3133 RD 986 AT RM 0.80
Co C Road# Begining

S 06 2N 33E DEAD END
Dir Sec Township Range Ending

3133 Road#

DATE: 02/28/95

OREGON DEPARTMENT OF TRANSPORTATION
Roadway Analysis 503/378-6277

00.06	A						DDDD DEAD END			1	12	G		P	19
00.06							==== NE QQUEEN RD			1	12	G		P	19
00.00	A						==== 986 NE RIVERSDE AV			1	12	G		P	19

00.00 NE 44TH ST

Mile Point	D u p e	City Code	POP	Ave Day Trf	FED AID	X R E F	LEFT	CENTER	RIGHT	C O N D	L A N E	Widths	Types	R/W	Urban	FN
										D	E	S	S	S	S	

01.01	A					***				1	12	G				09
01.01						====	544	COBB RD		1	12	G				09
00.76						====	542	LOCUST RD		1	12	G				09
00.50	A							N LANGLEY		1	12	G				09
00.50							MP 7.68			1	12	G				09
00.00	A					====	528	APPLETON RD		2	20	D				09



00.00								WEIS LANE								
Mile Point	D	City Code	POP	Ave Day Trf	FED AID	X R E F	LEFT	CENTER	RIGHT	C O N D	L A N E	Widths	Types	R/W	Urban	FN
												L S R	L S R			

00.24		ECL UMATILLA	*** CITY AHD	2	24	A	09
00.06				2	24	A	09
00.00 A			=== HWY 2 SPUR <i>Brownell Blvd</i>	2	24	A	09

00.00 CHERRY ST

Mile Point	D u p e	City Code	POP	Ave Day Trf	FED AID	X R E F	LEFT	CENTER	RIGHT	C O N D	L A N E	Widths	Types	R/W	Urban	FN
												L S R	L S R			
												D E S	S S S			

DATE: 02/28/95

00.24 DDDD DEAD END 2 24 A 09

00.00 A ==== ~~HWY 2 SPUR~~ *Drownell Blvd* 2 24 A 09

00.00 LOCUST ST

Mile Point	D	City Code	POP	Ave Day Trf	FED AID	X R E F	LEFT	CENTER	RIGHT	C O N D	L A N E	Widths	Types	R/W	Urban	FN
												L S R	L S R			
										D	E	S	S	S	S	

30 P 3138 HWY 2 SPUR AT MPY 184.08 W 16 5N 28E DEAD END 3138
 Co C Road# Beginning Dir Sec Township Range Ending Road#

DATE: 02/28/95

00.52	A					XXXX				2	16	0			09
00.52						====	HY 332			2	16	0			09
00.00	B					==	528 APPLETON RD			2	16	0			09
00.00	A						528 TRIANGL RD BK			2	16	0			09
00.00															

Trumbull Ln

Mile Point	D u p e	City Code	POP	Ave Day Trf	FED AID	X R E F	LEFT	CENTER	RIGHT	C O N D		L A N E S			Widths		Types	R/W	Urban	FN
										N	D	L	S	R	L	S				

01.44	A					****				2	14	G			09
01.44						====	740	SPRING HLLW RD		2	14	G			09
01.28								90 DEG TURN RT		2	14	G			09
01.01	A							90 DEG TURN LT		2	14	G			09
01.01						==	3184			2	14	G			09
00.04								PIPELINE XING		2	14	G			09
00.00	A							<i>Red Sand Lany</i> ==== 737 PAMBRUN RD		2	14	G			09
00.00															

Mile Point	D u p e	City Code	POP	Ave Day Trf	FED AID	X R E F	LEFT	CENTER	RIGHT	C O N D	Widths				Types	R/W	Urban	FN
											L	N	S	R				
											L	S	R	S				

30 P 3142 RD 737 AT RM 3.58
Co C Road# Begining

W 01 3N 34E 740 RM 1.93
Dir Sec Township Range Ending

3142
Road#

DATE: 02/28/95

OREGON DEPARTMENT OF TRANSPORTATION
Roadway Analysis 503/378-6277

Mile Point	D	City Code	POP	Ave Day Trf	FED AID	X R E F	LEFT	CENTER	RIGHT	C O N D	L A N E	Widths L S R	Types L S R	R/W	Urban	FN
04.50	A							***			1	12	D			09
04.50								==== 3145			1	12	D			09
00.00	A						WASHINGTON STATE LNE				1	12	D			09
00.00							PIKES PEAK RD									

00.25	A					****				1	12	D			09
00.25						====	3145			1	12	D			09
00.00	A					WASHINGTON STATE LINE				1	12	D			09

00.00

Mile Point	D	City Code	POP	Ave Day Trf	FED AID	X R E F	LEFT	CENTER	RIGHT	C O N D	L A N E S	Widths	Types	R/W	Urban	FN
												L S R	L S R			

30 P 3144 WASHINGTON STATE LINE SE 14 6N 37E JCT RD 3145 RM 0.20 3144
 Co C Road# Begining Dir Sec Township Range Ending Road#

DATE: 02/28/95

OREGON DEPARTMENT OF TRANSPORTATION
 Roadway Analysis 503/378-6277

04.00						DDDD DEAD END				1	12	D			09
03.90						== 3143				1	12	D			09
00.20						== 3144				1	12	D			09
00.00 A						WASHINGTON STATE LNE				1	12	D			09

Mile Point	D	City	POP	Ave	FED	X	LEFT	CENTER	RIGHT	C	L	Widths	Types	R/W	Urban	FN
u		Code		Day	AID	R				O	A	L S R	L S R			
p				Trf		E				N	N	S S	S S			
e						F				D	E	S S	S S			

30 P 3147 RD 652 AT RM 8.39

NW 13

3N

35E

RD 666 AT RM 4.56

ROAD NO: 3147

Mile Point	D	City POP	Ave Day Trf	FED AID	X R E F	LEFT	CENTER	RIGHT	C O N D	L A N E S	Widths	Types	R/W	Urban	FN
											L S R	L S R			
02.18	A						****				1 10	D			09
02.18							==== 666 BELL RD				1 10	D			09
01.80							<)<-				1 10	D			09
01.38							<---- FORD				1 10	D			09
00.26							190 DEG TURN LT				1 10	D			09
00.00	A						==== 652 WILDHORSE RD				1 10	D			09
00.00							INDIAN GRADE								

30 P 3147 RD 652 AT RM 8.39
Co C Road# Begining

NW 13
Dir Sec

3N 35E
Township Range

RD 666 AT RM 4.56
Ending

3147
Road#

OREGON DEPARTMENT OF TRANSPORTATION
Roadway Analysis 503/378-6277

DATE: 02/28/95

00.22 A					***				2	14	G			09
00.22					====	1300 RIETH RD			2	14	G			09
00.20					==	90 DEG TURN LT WES ST			2	14	G			09
00.12					==	1318 HILL ST			2	14	G			09
00.04 A						N GEORGE ST			2	14	G			09
00.04					==	90 DEG TURN LT 3149 GEORGE ST			2	14	G			09
00.00 A					====	1300 RIETH RD			2	14	G			09

00.00						DELPHI ST(DELPHI)										
Mile Point	D u p e	City Code	PDP	Ave Day Trf	FED AID	X R E F	LEFT	CENTER	RIGHT	C O N D	L A N E	Widths L S R	Types L S R	R/W	Urban	FN

00.09	A					XXXX				1	10	U			09
00.09						====	1300 RIETH RD			1	10	U			09
00.06							50 DEG TURN RT			1	10	U			09
00.00	B					==	3148 DELPHI ST			1	10	U			09
00.00	A						3148 BK GEORGE ST			1	10	U			09

00.00 GEORGE ST(RIETH)

Mile Point	D	City Code	POP	Ave Day Trf	FED AID	X R E F	LEFT	CENTER	RIGHT	C O N D	L A N E S	Widths	Types	R/W	Urban	FN
												L S R	L S R			

Mile Point	D	City Code	POP	Ave Day Trf	FED AID	X R E F	LEFT	CENTER	RIGHT	C O N D	L A N E	Widths	Types	R/W	Urban	FN
												L S R	L S R			
00.06	A							****				1	12		G	09
00.06							PVT RD AHD	==				1	12		G	09
00.00	A							====	1300 OLD PNDLTN RVR			1	12		G	09
00.00							(RIETH)									

00.64 A		****		1	12	G									09
00.64		====	1300 OLD PNDLTN RVR	1	12	G									09
00.00 A		====	1300 OLD PNDLTN RVR	1	12	G									09

00.00 OLD RIETH ROAD

Mile Point	D u p e	City Code	POP	Ave Day Trf	FED AID	X R E F	LEFT	CENTER	RIGHT	C O N D	L A N E	Widths	Types	R/W	Urban	FN
												L S R	L S R			
												D E S	S S S			

30 P 3152 RD 1318 RM 0.30

NW 12

2N

31E

PVT RD

ROAD NO: 3152

01.31	A					****				2	20		D				09
01.31						==				2	20		D				09
00.98						<)(-				2	20		D				09
00.35										2	20		D				09
00.14								150 DEG TURN RT		2	20		0				09
00.00	A					====		1318 KEITH DUMP RD		2	20		0				09

00.00 RIETH ROAD

Mile Point	D u p e	City Code	POP	Ave Day Trf	FED AID	X R E F	LEFT	CENTER	RIGHT	Widths		Types		R/W	Urban	FN
										C	L	L	S			
										O	A	N	S			
										D	E	S	S			

30 P 3152 RD 1318 RM 0.30
Co C Road# Begining

NW 12 2N 31E PVT RD
Dir Sec Township Range Ending

3152
Road#

DATE: 02/28/95

OREGON DEPARTMENT OF TRANSPORTATION
Roadway Analysis 503/378-6277

02.15	A					****				1	10	U		09
02.15						====	1363	ALKALI CAN RD		1	10	U		09
00.89						---		FORD		1	10	U		09
00.74						---		FORD	<i>Speare Canyon Rd</i>	1	10	U		09
00.00	A					====	1350	COOMBS CAN RD		1	10	U		09
00.00														

Mile Point	D u p e	City Code	POP	Ave Day Trf	FED AID	X R E F	LEFT	CENTER	RIGHT	C O N D		Widths				Types		R/W	Urban	FN			
										L	A	L	S	R	L	S	R				L	S	R
										D	E	S	S	S	S	S							

00.35							DDDD DEAD END			2	16	D			09
00.23) (2	16	D			09
00.18					S		- > 18			2	16	D			09
00.00 A							==== HY 339 FREEWATER HY			2	16	D			09

Mile Point	D u p e	City Code	POP	Ave Day Trf	FED AID	X R E F	LEFT	CENTER	RIGHT	C O N D	L A N E S	Widths	Types	R/W	Urban	FN		
											L	S	R	L	S	R		
											D	E	S	S	S	S		

30 P 3155 RD 512 AT RM 0.85

N 15

6N

35E

DEAD END

ROAD NO: 3155

00.10 DDDD DEAD END 1 10 G 09

00.00 A ==== 512 SUNQUIST RD 1 10 G 09

00.00

Mile Point	D u p e	City Code	POP	Ave Day Trf	FED AID	X R E F	LEFT	CENTER	RIGHT	C O N D	L A N E	Widths	Types	R/W	Urban	FN
											L S R	L S R				
											D E S	S S S				

30 P 3155 RD 512 AT RM 0.85
Co C Road# Begining

N 15 6N 35E DEAD END
Dir Sec Township Range Ending

3155
Road#

OREGON DEPARTMENT OF TRANSPORTATION
Roadway Analysis 503/378-6277

DATE: 02/28/95

00.38 DDDD DEAD END 2 14 G 09

00.00 A ==== 512 SUNQUIST RD 2 14 G 09

00.00 FITZGERALD LN

Mile Point	D u p e	City Code	POP	Ave Day Trf	FED AID	X R E F	LEFT	CENTER	RIGHT	C O N D	L A N E	Widths	Types	R/W	Urban	FN
										D	E	S	S	S	S	

00.12 DDDD DEAD END 1 10 D 09
 00.00 A ==== 575 EASTSIDE RD 1 10 D 09

00.00

Mile Point	D	City Code	POP	Ave Day Trf	FED AID	X REF	LEFT	CENTER	RIGHT	C O N D	L A N E	Widths	Types	R/W	Urban	FN
												L S R	L S R			
												S S S	S S S			

30 P 3157 RD 575 AT RM 1.29 W 36 6N 35E DEAD END 3157
 Co C Road# Begining Dir Sec Township Range Ending Road#

DATE: 02/28/95

Mile Point	D	City Code	POP	Ave Day Trf	FED AID	X REF	LEFT	CENTER	RIGHT	C O N D	L A N E S	Widths	Types	R/W	Urban	FN
												L S R	L S R			
00.32									DDDD DEAD END			1 12	D			09
00.26							DUGGER CR		-)(>			1 12	D			09
00.00 A									==== 532 PHILLPS RD			1 12	D			09
00.00							EMILY LN (UMAPINE)									

00.25						DDDD DEAD END				1	12	G				09
00.24						POWERLINE XING				1	12	G				09
00.13						DUGGER CR		-)(<		1	12	G				09
00.00 A						==== 531 EDWARDS RD				1	12	G				09

00.00

Mile Point	Direction	City Code	POP	Ave Day Trf	FED AID	REFERENCE	LEFT	CENTER	RIGHT	CONNECTION	L Width	A N L	S R	Types	R/W	Urban	FN

DATE: 02/28/95

30 P 3160 RD 575 AT RM 2.30

E 01

5N

35E

DEAD ENDS

ROAD NO: 3160

00.10							DDDD DEAD END		2	16	G		09
00.06							MILTON NURSERY CO		2	16	G		09
00.03			UP RY				++++ 2 TRAX		2	16	G		09
00.00 A							==== 575 EAST SIDE RD		2	16	G		09

Mile Point	D u p e	City Code	POP	Ave Day Trf	FED AID	X R E F	LEFT	CENTER	RIGHT	C O N D	L A N E	Widths L S R	Types L S R	R/W	Urban	FN
------------	---------	-----------	-----	-------------	---------	---------	------	--------	-------	---------	---------	--------------	-------------	-----	-------	----

30 P 3160 RD 575 AT RM 2.30
Co C Road# Begining

E 01
Dir Sec

5N
Township

35E
Range

DEAD ENDS
Ending

3160
Road#

DATE: 02/28/95

OREGON DEPARTMENT OF TRANSPORTATION
Roadway Analysis 503/378-6277

Mile Point	D	City Code	POP	Ave Day Trf	FED AID	X REF	LEFT	CENTER	RIGHT	C O N D	L A N E S	Widths	Types	R/W	Urban	FN
												L S R	L S R			
00.10									DDDD DEAD END			1 10	D			09
00.00 A									==== 575 EAST SIDE RD			1 10	D			09
00.00							HARSHFIELD LN									

DATE: 02/28/95

00.60							DDDD DEAD END			1	12	D			09
00.37							90 DEG TURN LT	-)(>		1	12	D			09
00.35							90 DEG TURN RT			1	12	D			09
00.00 B							== 650 PRUNEDALE RD			1	12	D			09
00.00 A							650 PRUNEDALE BK			1	12	D			09

00.00 (PRUNEDALE)

Mile Point	Du	City Code	POP	Ave Day Trf	FED AID	X R E F	LEFT	CENTER	RIGHT	C O N D	L A N E	Widths	Types	R/W	Urban	FN	
											L S	R S	L S	R S			
											D E	S S	S S	S S			

30 P 3163 JCT RD 575 RM 1.19

E 36

6N

35E

DEAD END

ROAD NO: 3163

00.35							DDDD	DEAD END		1	12	G			09
00.26							====	543 GRANT RD		1	12	G			09
00.00 A							==	575 EAST SIDE RD		2	24	G			09

00.00

Mile Point	D	City	POP	Ave	FED	X	LEFT	CENTER	RIGHT	C	L	Widths	Types	R/W	Urban	FN
u		Code		Day	AID	R				O	A					
p				Trf		E				N	N	L S R	L S R			
e						F				D	E	S S S	S S S			

30 P 3163 JCT RD 575 RM 1.19
Co C Road# Begining

E 36 6N 35E DEAD END
Dir Sec Township Range Ending

3163
Road#

DATE: 02/28/95

OREGON DEPARTMENT OF TRANSPORTATION
Roadway Analysis 503/378-6277

00.44	A					****				1	12	G			09
00.44						====	610 WALLA WLL R RD			1	12	G			09
00.40							90 DEG TURN RT			1	12	G			09
00.00	A					====	610 WALLA WLL R RD			1	12	G			09

DAY RD																
Mile Point	D	City Code	POP	Ave Day Trf	FED AID	X R E F	LEFT	CENTER	RIGHT	C O N D	L A N E S	Widths	Types	R/W	Urban	FN
												L S R	L S R			

DATE: 02/28/95

30 P 3165 RD 682 AT RM 0.47

N 15

4N

35E

DEAD ENDS

ROAD NO: 3165

00.16							DDDD DEAD END			1	10	G				09
00.13							UP RY MAIN LINE	++++		1	10	G				09
00.12							WESTON DEPOT			1	10	G				09
00.08							UP RY SPUR	++++		1	10	G				09
00.00 A							==== 682 KEY RD			1	10	G				09
00.00							WESTON STA RD									

Mile Point	D u p e	City Code	POP	Ave Day Trf	FED AID	X R E F	LEFT	CENTER	RIGHT	C O N D		Widths				Types		R/W	Urban	FN			
										L	A	L	S	R	L	S	R				L	S	R

30 P 3165 RD 682 AT RM 0.47
Co C Road# Begining

N 15
Dir Sec

4N
Township

35E
Range

DEAD ENDS
Ending

3165
Road#

DATE: 02/28/95

OREGON DEPARTMENT OF TRANSPORTATION
Roadway Analysis 503/378-6277

00.87 END AT FARM **** 1 12 D 09
 00.00 A ==== HY 330 WESTN-ELGN HY 1 12 D 09

00.00

Mile Point	Du	City Code	POP	Ave Day Trf	FED AID	X REF	LEFT	CENTER	RIGHT	C O N D	L A N E	Widths	Types	R/W	Urban	FN
												L S R	L S R			

30 P 3166 HWY 330 AT MP 5.31 S 29 4N 36E AT FARM 3166
 Co C Road# Begining Dir Sec Township Range Ending Road#

DATE: 02/28/95

00.38 DDDD DEAD END 1 12 G 09
 00.00 A ==== HY 330 WESTN ELGN HY 1 12 G 09

00.00

Mile Point	Du	City Code	POP	Ave Day Trf	FED AID	X R E F	LEFT	CENTER	RIGHT	C O N D	L A N E S	Widths	Types	R/W	Urban	FN
												L S R	L S R			

30 P 3167 JCT HWY 330 - MP 5.97 S 28 4N 36E DEAD END 3167
 Co C Road# Begining Dir Sec Township Range Ending Road#

DATE: 02/28/95

Mile Point	D	City Code	POP	Ave Day Trf	FED AID	X R E F	LEFT	CENTER	RIGHT	C O N D	L A N E S	Widths	Types	R/W	Urban	FN
00.15								DDDD	DEAD END			1 12	G			09
00.04							TRAILER PARK					1 12	G			09
00.02							UP RY	++++				1 12	G			09
00.00 A								====	900 MISSION RD			1 12	G			09
00.00							MYTINGER LN									

00.16 DDDD DEAD END 2 18 G 09

00.00 A ==== 900 MISSION RD 2 18 G 09

00.00 BUS BARN LN

Mile Point	D u p e	City Code	POP	Ave Day Trf	FED AID	X R E F	LEFT	CENTER	RIGHT	C O N D	L A N E	Widths	Types	R/W	Urban	FN
												L S R	L S R			
												S S	S S			

30 P 3169 RD 900 AT RM 1.61
Co C Road# Begining

S 08 2N 33E DEAD ENDS
Dir Sec Township Range Ending

3169
Road#

DATE: 02/28/95

OREGON DEPARTMENT OF TRANSPORTATION
Roadway Analysis 503/378-6277

00.80		BARRICADE	****		2	18	G			09
00.71			ENT DRIVE IN THTR		2	18	G			09
00.67			== 939 PNDLTN THTR RD		2	18	G			09
00.35			== GOPHER FLAT		2	18	G			09
00.17			== TRIAL DR		2	18	G			09
00.00 A			==== 900 MISSION RD		2	18	G			09

00.00 SE 56TH ST

Mile Point	D u p e	City Code	POP	Ave Day Trf	FED AID	X R E F	LEFT	CENTER	RIGHT	Widths				Types		R/W	Urban	FN
										C	L			L	S			
										O	A	N	S	R	L			

00.07 A						XXXX				1	10	G			09
00.07						XX CLOSED				1	10	G			09
00.03						XX CLOSED				1	10	G			09
00.02						UP RY				1	10	G			09
00.01						XX CLOSED				1	10	G			09
00.00 A						====	900 MISSION RD			1	10	G			09

00.00						WILLIAMS LN										
Mile Point	D	City Code	POP	Ave Day Trf	FED AID	X R E F	LEFT	CENTER	RIGHT	C O N D	L A N E S	Widths	Types	R/W	Urban	FN
												L S R	L S R			

30 P 3172 RD 900 AT RM 2.13

S 08

2N

33E

RD 3177 AT RM 0.4

ROAD NO: 3172

02.07	A					****				2	24	G			09
02.07						==	3177			2	24	G			09
01.39						BEGIN FRONTAGE RD		NEAR I-84		2	24	G			09
00.62								==	3174	1	12	D			09
00.22										1	12	D			09
00.00	A							====	900 MISSION RD	1	12	G			09

00.00						PURCHASE LN										
Mile Point	D	City Code	POP	Ave Day Trf	FED AID	X REF	LEFT	CENTER	RIGHT	C O N D	L A N E	Widths	Types	R/W	Urban	FN
												L S R	L S R			

30 P 3172 RD 900 AT RM 2.13
Co C Road# Begining

S 08
Dir Sec

2N
Township

33E
Range

RD 3177 AT RM 0.49
Ending

3172
Road#

OREGON DEPARTMENT OF TRANSPORTATION
Roadway Analysis 503/378-6277

DATE: 02/28/95

00.20							DDDD DEAD END			1	10	G			09
00.17					S		< -	16		1	10	G			09
00.03							==	ISHKIT LN		1	10	G			09
00.02						UP RY	++++			1	10	G			09
00.00 A							====	900 MISSION RD		1	10	G			09

00.00							DAVIS LN									
Mile Point	D u p e	City Code	POP	Ave Day Trf	FED AID	X R E F	LEFT	CENTER	RIGHT	C O N D	L A N E S	Widths L S R	Types L S R	R/W	Urban	FN

DATE: 02/28/95

00.62	A				XXXX					1	10	D				09
00.62					====	3172				1	10	D				09
00.41						TO RODEO GROUNDS>	==			1	10	D				09
00.05						OLD AGENCY CEM				1	10	D				09
00.03						-)((>				1	10	D				09
00.00	A				====	900 MISSION RD				1	10	D				09

00.00						HORSESHOE LN										
Mile Point	D	City Code	POP	Ave Day Trf	FED AID	X R E F	LEFT	CENTER	RIGHT	C O N D	L A N E	Widths	Types	R/W	Urban	FN
												L S R	L S R			

Mile Point	D	City Code	POP	Ave Day Trf	FED AID	X R E F	LEFT	CENTER	RIGHT	C O N D	L A N E S	Widths	Types	R/W	Urban	FN
00.12									DDDD DEAD END			1 10	D			09
00.08							90 DEG TURN LT					1 10	D			09
00.00 A								====	900 MISSION RD			1 10	D			09
00.00							HORSESHOE LN									

30 P 317 RD 900 AT RM 3.92

N 10

2N

33E

DEAD ENDS

ROAD NO: 3176

00.35							DDDD DEAD END			1	12	G			09
00.31							==			1	12	G			09
00.30							PIPELINE XING			1	12	G			09
00.17							UP RY			1	12	G			09
00.00 A							==== 900 MISSION RD			1	12	G			09
00.00							PARR LN								

Mile Point	D u p e	City Code	POP	Ave Day Trf	FED AID	X R E F	LEFT	CENTER	RIGHT	Widths				Types		R/W	Urban	FN
										C	L							
										O	A	N	L	S	R			

30 P 3176 RD 900 AT RM 3.92
Co C Road# Begining

N 10
Dir Sec

2N
Township

33E
Range

DEAD ENDS
Ending

3176
Road#

DATE: 02/28/95

OREGON DEPARTMENT OF TRANSPORTATION
Roadway Analysis 503/378-6277

30 P 317 HWY 331 MP 4.03

W 16

2N

33E

RD 3172 RM 2.07

ROAD NO: 3177

00.49	A						****				1	12		D				09
00.49							==	3172			1	12		D				09
00.00	A						====	HY 331			1	12		D				09
00.00																		

Mile Point	D	City Code	POP	Ave Day Trf	FED AID	X REF	LEFT	CENTER	RIGHT	C O N D	L A N E	Widths	Types	R/W	Urban	FN
												L S	R S			
												S	S			

30 P 3177 HWY 331 MP 4.03
Co C Road# Begining

W Dir

16 Sec

2N Township

33E Range

RD 3172 RM 2.07
Ending

3177 Road#

DATE: 02/28/95

OREGON DEPARTMENT OF TRANSPORTATION
Roadway Analysis 503/378-6277

00.50	A					xxxx				2	22	G			09
00.50						====	HY 339	FREEWATER	HY	2	22	G			09
00.46		0000	0				WCL MILTON-FRWTR		CITY AHD	2	22	G			09
00.25									DUMP	2	22	G			09
00.00	A					====	625	WINESAP	RD	1	10	G			09

00.00																
Mile Point	D	City	POP	Ave	FED	X	LEFT	CENTER	RIGHT	C	L	Widths	Types	R/W	Urban	FN
	u	Code		Day	AID	R				O	A					
	p			Trf		E				N	N	L S R	L S R			
	e					F				D	E	S S	S S			

30 P 3180 RD 900 AT RM 9.96

E 10

2N

34E

DEAD END

ROAD NO: 3180

00.75							DDDD DEAD END		1	10	G				09
00.64							PIPELINE XING		1	10	G				09
00.21							<>(-		1	10	G				09
00.19							PIPELINE XING		1	10	G				09
00.09							<>(-		1	10	G				09
00.00 A							==== 900 CAYUSE RD		1	10	G				09

00.00							PRICE LN									
Mile Point	D u p e	City Code	POP	Ave Day Trf	FED AID	X R E F	LEFT	CENTER	RIGHT	C O N D	L A N E	Widths	Types	R/W	Urban	FN
												L S R	L S R			

30 P 3180 RD 900 AT RM 9.96
Co C Road# Begining

E 10
Dir Sec

2N

34E

DEAD END
Ending

3180
Road#

OREGON DEPARTMENT OF TRANSPORTATION
Roadway Analysis 503/378-6277

DATE: 02/28/95

30 P 3181 RD 927 RM 2.07

NE 08

2N

34E

RD 918 RM 1.08

ROAD NO: 3181

01.20	A						CAYUSE RIVER RD	****		1	10	G				09
01.20							RD 918 AHD WHITE AHD	==	918 RIVER RD	1	10	G				09
01.09							UP RY	++++		1	10	G				09
01.06									90 DEG TURN RT	1	10	G				09
00.64								<)<-		1	10	G				09
00.00	A						RIVER	==	927 RIVER RD	1	10	G				09
00.00							(MINTHORN)									

Mile Point	D u p e	City Code	POP	Ave Day Trf	FED AID	X R E F	LEFT	CENTER	RIGHT	Widths		Types		R/W	Urban	FN
										C	L	L	S			
										D	E	S	S			

30 P 3181 RD 927 RM 2.07
Co C Road# Begining

NE 08 2N 34E RD 918 RM 1.08
Dir Sec Township Range Ending

3181
Road#

DATE: 02/28/95

OREGON DEPARTMENT OF TRANSPORTATION
Roadway Analysis 503/378-6277

00.16							DDDD DEAD END		1	12	G				09
00.11							CAYUSE SECTION HSE		1	12	G				09
00.00 A							==== 730 CAYUSE-ADAMS R		1	12	G				09
00.00							(CAYUSE)								
	Mile D Point u p e	City POP Code	Ave Day Trf	FED AID	X R E F	LEFT	CENTER	RIGHT	C O N D	L A N E	Widths L S R S S S	Types L S R S S S	R/W	Urban	FN

925 N Cayuse Rd

02.02	A						***			1	10	D			09
02.02							====	788	CRAWFORD HOL R	1	10	D			09
01.00							==	784	90 DEG TURN LT	1	10	D			09
00.00	A						====	925	CAYUSE-ADAMS R	2	16	D			09

00.00

Mile Point	Du	City Code	POP	Ave Day Trf	FED AID	X REF	LEFT	CENTER	RIGHT	C O N D	L A N E	Widths	Types	R/W	Urban	FN
												L S	R S			
												S	S			

DATE: 02/28/95

01.01 A						XXXX				1	12	D			09
01.01						====	692	←	WALLEN RD		12	D			09
00.00 A						==	3142			1	12	D			09

00.00

Mile Point	DuPe	City Code	POP	Ave Day Trf	FED AID	X R E F	LEFT	CENTER	RIGHT	C O N D	L A N E	Widths	Types	R/W	Urban	FN
												L S R	L S R			
												D E S	S S S			

30 P 3184 RD 3142 AT RM 1.01 N 01 3N 34E RD 692 AT RM 1.50 3184
 Co C Road# Begining Dir Sec Township Range Ending Road#

DATE: 02/28/95

30 P 3185 RD 798 RM 2.03

S 02

2N

33E

LOCKED GATE

ROAD NO: 3185

00.71 A						****				2	16	D			09
00.71						XX	LOCKED GATE			2	16	D			09
00.25						==				2	16	D			09
00.00 B						====	798 KIRKPATRICK RD			2	16	D			09
00.00 A							TIGER LN BK			2	16	D			09

00.00 MCKINLEY LN																
Mile Point	D	City Code	POP	Ave Day Trf	FED AID	X R E F	LEFT	CENTER	RIGHT	C O N D	L A N E S	Widths	Types	R/W	Urban	FN
												L S R	L S R			

30 P 3185 RD 798 RM 2.03
Co C Road# Begining

S 02 2N 33E LOCKED GATE
Dir Sec Township Range Ending

3185
Road#

DATE: 02/28/95

OREGON DEPARTMENT OF TRANSPORTATION
Roadway Analysis 503/378-6277

00.29							DDDD DEAD END			1	08	D			09
00.19										1	08	D			09
00.03							== 798 LEG			1	12	G			09
00.00 B							==== 798 KIRKPATRICK RD			1	12	G			09
00.00 A							MCKINLEY LN BK			1	12	G			09

00.00							TIGER LN									
Mile Point	D	City Code	POP	Ave Day Trf	FED AID	X R E F	LEFT	CENTER	RIGHT	C O N D	L A N E S	Widths	Types	R/W	Urban	FN
												L S R	L S R			
												S S S	S S S			

00.80						DDDD DEAD END				1	10	G				09
00.76						==				1	10	G				09
00.75						UP RY	++++			1	10	G				09
00.70						90 DEG TURN RT	==	908 SHORTMILE RD		1	10	G				09
00.52						S MISSION CR	- >	16		2	2 21 2	G 0 G				09
00.51						90 DEG TURN LT				2	22	G				09
00.26						PIPELINE XING				2	22	G				09
00.21							< (-			2	22	G				09
00.15						S MISSION CR	< -	16		2	22	G				09
00.00 A							====	900 MISN-CAYUSE RD		2	22	G				09

Mile Point	D u p e	City Code	POP	Ave Day Trf	FED AID	X R E F	LEFT	CENTER	RIGHT	C O N D	L A N E S	Widths	Types	R/W	Urban	FN
											L S R	L S R				
											D E S	S S S				

01.01 A							**** RD 1175 AHD		2	20	G				09
01.01							== 1175 STANFIELD LP		2	20	G				09
01.00			IRRIG) (2	20	G				09
00.75							==== 3068		2	20	G				09
00.51							90 DEG TURN RT		2	20	G				09
00.31			IRRIG) (2	20	G				09
00.00 B							== 1182 NE HARDING AVE		2	20	G				09
00.00 A							1181 RD BK		2	20	G				09
00.00															

Mile Point	D u p e	City Code	POP	Ave Day Trf	FED AID	X R E F	LEFT	CENTER	RIGHT	C O N D	Widths				Types				R/W	Urban	FN
											L	N	S	R	L	S	R	S			

01.65	A						****			2	18	0				09
01.65							====	3025		2	18	0				09
01.50										2	18	0				09
01.35							==			2	16	G				09
01.09							++++			2	16	G				09
00.19							==			2	16	G				09
00.17						UP RY	++++	2 TRAX		2	16	G				09
00.00	A						====	HY 333 HERMSTN HY		2	16	G				09

Mile Point	Du	City Code	POP	Ave Day Trf	FED AID	X R E F	LEFT	CENTER	RIGHT	C O N D	L A N E S	Widths	Types	R/W	Urban	FN
												L S	R S			

00.43								*** 3025 RD AHD	2	16	G			09
00.04								HINKLE STATION	2	16	G			09
00.00 B								== 1324 SIMPLOT RD	2	16	G			09
00.00 A								3010 SIMPLOT RD BK	2	16	G			09

Mile Point	D u p e	City Code	POP	Ave Day Trf	FED AID	X R E F	LEFT	CENTER	RIGHT	C O N D	L A N E	Widths L S	Types R S	R/W	Urban	FN
------------	---------	-----------	-----	-------------	---------	---------	------	--------	-------	---------	---------	------------	-----------	-----	-------	----

DATE: 02/28/95

OREGON DEPARTMENT OF TRANSPORTATION
 Roadway Analysis 503/378-6277

02.17 B					XXXX				1	12	G				09
02.17 A					PVT RD AHD	XX			1	12	G				09
02.17					S	- >			1	12	G				09
01.07					S HUNT DITCH	- >	16		1	12	G				09
00.84							90 DEG TURN RT		1	12	G				09
00.58							90 DEG TURN LT		1	12	G				09
00.57						-)<			1	12	G				09
00.31						XX			1	12	G				09
00.28						-)<			1	12	G				09
00.18						XX			1	12	G				09
00.00 A						====	HY 333 HERMISTN HY		1	12	G				09

Mile Point	D	City	POP	Ave	FED	X	LEFT	CENTER	RIGHT	C	L	Widths	Types	R/W	Urban	FN	
	u	Code		Day	AID	R				O	A						
	p			Trf		E				N	N	L	S	R	L	S	R
	e					F				D	E	S	S	S	S	S	

00.73							DDDD DEAD END			1	12	D			09
00.63)(<			1	12	D			09
00.50							OLD OREGON TRAIL XING			1	12	D			09
00.42							- > 6			1	12	D			09
00.15)(<			1	12	G			09
00.02							-)<>			1	12	G			09
00.00 A							==== HY 333 HERMISTN HY			1	12	G			09

00.00																
Mile Point	D	City Code	POP	Ave Day Trf	FED AID	X R E F	LEFT	CENTER	RIGHT	C O N D	L A N E	Widths L S R	Types L S R	R/W	Urban	FN

Vertical

01.52	A									****	2	14	G		09
01.52										==== HY 320 ORE 207	2	14	G		09
01.02					S					319 - > 24-7 <i>Current 49x33</i>	2	14	G		09
00.00	A									==== 1356 MADSN-SAYLR RD	2	14	G		09
00.00															

Mile Point	D u p e	City Code	POP	Ave Day Trf	FED AID	X R E F	LEFT	CENTER	RIGHT	C O N D	Widths			Types			R/W	Urban	FN
											L	S	R	L	S	R			

30 P 3196 RD 1356 AT RM 0.71 S 30 3N 28E HWY 320 AT MP 25.60 3196
 Co C Road# Beginning Dir Sec Township Range Ending Road#

DATE: 02/28/95

00.98 A							**** RD 1333 AHD		1	10	U				09
00.98							== 1333 CURITS RD		1	10	U				09
00.84							== 1333 LEG		1	10	U				09
00.51						PIPELINE XING			1	10	U				09
00.00 A							==== 3070		1	10	U				09

00.00																
Mile Point	D u p e	City Code	POP	Ave Day Trf	FED AID	X R E F	LEFT	CENTER	RIGHT	C O N D	L A N E	Widths L S R	Types L S R	R/W	Urban	FN

30 P 3198 RD 3070 AT RM 1.48
Co C Road# Begining

NW 10 3N 28E RD 1333 RM 1.52
Dir Sec Township Range Ending

3198
Road#

DATE: 02/28/95

OREGON DEPARTMENT OF TRANSPORTATION
Roadway Analysis 503/378-6277

01.00	A					XXXX				2	14		D			09
01.00						====	HY 320			2	14		D			09
00.76							DUMP			2	14		D			09
00.06						==	3199 LEG			1	08		U			09
00.00	A					====	3073			1	08		U			09

00.00																
Mile Point	D	City Code	POP	Ave Day Trf	FED AID	X REF	LEFT	CENTER	RIGHT	C O N D	L A N E	Widths	Types	R/W	Urban	FN
												L S	R S	L S	R S	

Mile Point	Du	City Code	POP	Ave Day Trf	FED AID	X R E F	LEFT	CENTER	RIGHT	C O N D	L A N E S	Widths	Types	R/W	Urban	FN
												L S R	L S R			
00.57								DDDD	DEAD END		1	10	G			09
00.53) (1	10	G			09
00.46							S BUTTER CR	- >	18		1	10	G			09
00.45								-)<			1	10	G			09
00.00 A								====	HY 3320 ORE 207		1	10	G			09
00.00							MCCARTY RANCH LN									

DATE: 02/28/95

30 P 3201 RD 1350 AT RM 16.61

S 12

IN

31E

RD 1377 RM 1.64

ROAD NO: 3201

02.37	A					****				1	08	U		09
02.37						====	1377 CAMPBELL RD			1	08	U		09
02.36						XX				1	08	U		09
01.45						<---	FORD			1	08	U		09
01.44						==	100 DEG TURN LT			1	08	U		09
01.19						<---	FORD			1	08	U		09
00.93						XX				1	08	U		09
00.12						<)(-				1	08	U		09
00.00	A					====	1350 COOMBS CAN RD			1	08	U		09
00.00														

Mile Point	D u p e	City Code	POP	Ave Day Trf	FED AID	X R E F	LEFT	CENTER	RIGHT	C O N D	Widths				Types		R/W	Urban	FN
											L	N	S	R	L	S			
											A	E	S	S	S	S			

30 P 3201 RD 1350 AT RM 16.61
Co C Road# Begining

S 12
Dir Sec

IN 31E
Township Range

RD 1377 RM 1.64
Ending

3201
Road#

DATE: 02/28/95

OREGON DEPARTMENT OF TRANSPORTATION
Roadway Analysis 503/378-6277

00.88						DDDD DEAD END				1	12	G				09
00.86						B IRRIG	<)=(<	12 35 WOOD		1	12	G				09
00.85						IRRIG	<)(-<			1	12	G				09
00.37						100 DEG TURN LT	==			1	12	G				09
00.33						IRRIG	->(>			1	12	G				09
00.03							==	LEG TO HWY		1	12	G				09
00.00 A							====	HY 320		1	12	G				09

00.00						PEDRO LN										
Mile Point	Du	City Code	POP	Ave Day Trf	FED AID	X R E F	LEFT	CENTER	RIGHT	C O N D	L A N E S	Widths	Types	R/W	Urban	FN
												L S R	L S R			

00.25 A						****				1	08	D			09
00.25						====	1238 ORCHARD AV EXT			1	08	D			09
00.10							S I CANAL	< -	8	1	08	D			09
00.00 A							<i>18th St</i>	====	1215 HIGHLND AV EXT	1	08	D			09

Mile Point	D	City Code	POP	Ave Day Trf	FED AID	X R E F	LEFT	CENTER	RIGHT	C O N D	L A N E S	Widths	Types	R/W	Urban	FN
												L S R	L S R			

DATE: 02/28/95

00.56	A					XXXX				2	27	0				09
00.56						====	3218 WILLAMETTE AVE			2	27	0				09
00.50						==	UMATILLA AVE			2	27	0				09
00.32						==	3222 DESCHUTES AVE			2	27	0				09
00.03							BEGN UMATILLA CL LT			2	27	0				09
00.00	A					====	1289 A.L. BUD DRPER			2	27	0				09
00.00							KALAMA AVE(UMATILLA)									

Mile Point	D	City	POP	Ave	FED	X	LEFT	CENTER	RIGHT	C	L	Widths	Types	R/W	Urban	FN
u		Code		Day	AID	R				O	A					
p				Trf		E				N	N	L	S	R	L	S
e						F				D	E	S	S	S	S	

30 P 3217 RD 1279 AT RM 4.89 SW 11 5N 28E RD 3218 AT RM 0.00 3217
 Co C Road# Begining Dir Sec Township Range Ending Road#

DATE: 02/28/95

OREGON DEPARTMENT OF TRANSPORTATION
 Roadway Analysis 503/378-6277

30 P 322 RD 1194 AT RM 0.25

S 21

4N

28E

DEAD ENDS

ROAD NO: 3227

00.20 DDDD DEAD END 1 08 U 09

00.00 A === 1194 MINNEHAHA RD 1 08 U 09

00.00 RUDDER LN

Mile Point	D	City Code	POP	Ave Day Trf	FED AID	X R E F	LEFT	CENTER	RIGHT	C O N D	L A N E S	Widths	Types	R/W	Urban	FN
												L S R	L S R			

30 P 3227 RD 1194 AT RM 0.25
Co C Road# Begining

S Dir

21 Sec

4N Township

28E Range

DEAD ENDS Ending

3227 Road#

DATE: 02/28/95

OREGON DEPARTMENT OF TRANSPORTATION
Roadway Analysis 503/378-6277

00.16 DDDD DEAD END 1 10 D 09
 00.00 A ==== 1191 LLOYD RD 1 10 D 09

00.00 CORA ROBB LN

Mile Point	D u p e	City Code	POP	Ave Day Trf	FED AID	X R E F	LEFT	CENTER	RIGHT	C O N D	L A N E	Widths L S R	Types L S R	R/W	Urban	FN
------------	---------	-----------	-----	-------------	---------	---------	------	--------	-------	---------	---------	--------------	-------------	-----	-------	----

30 P 3228 RD 1191 AT RM 0.25 W 21 4N 28E DEAD ENDS 3228
 Co C Road# Begining Dir Sec Township Range Ending Road#

DATE: 02/28/95

01.75 A		****								1	10	U			09
01.75		====	3230							1	10	U			09
00.71		==								1	10	U			09
00.20			SPIKES GULCH			<---	FORD			1	10	U			09
00.00 B		==	1343							1	10	U			09
00.00 A		==	PVT							1	10	U			09
00.00															

Mile Point	D u p e	City Code	POP	Ave Day Trf	FED AID	X R E F	LEFT	CENTER	RIGHT	C O N D	L A N E S	Widths	Types	R/W	Urban	FN
											L S R	L S R				
											D E S	S S S				

05.48						DDDD DEAD END				2	14	D			09
05.25						SPIKES GULCH <---				2	14	D			09
05.09						<---				2	14	D			09
04.19						SPIKES GULCH ---> FORD				2	14	D			09
03.68						==				2	14	D			09
03.28						XX				2	14	D			09
02.78						==				2	14	D			09
02.65						==				2	14	D			09
01.18						== 1362				2	14	D			09
01.17						== 3229				2	14	D			09
00.00 A						1347 BACK == 1348				2	14	D			09

Mile Point	D	City Code	POP	Ave Day Trf	FED AID	X REF	LEFT	CENTER	RIGHT	C O N D	L A N E S	Widths	Types	R/W	Urban	FN
												L S	R S			

01.77	A					XXXX				1	08	U			09
01.77						====	1349 TONY VEY RD			1	08	U			09
01.48						--->	FORD			1	08	U			09
01.38						--->	FORD			1	08	U			09
01.29						--->	FORD			1	08	U			09
00.48						--->	FORD			1	08	U			09
00.38						==				1	08	U			09
00.00	B					==	PVT			1	08	U			09
00.00	A					==	1343			1	08	U			09

00.00

Mile Point	D u p e	City Code	POP	Ave Day Trf	FED AID	X R E F	LEFT	CENTER	RIGHT	C		Widths			Types		R/W	Urban	FN	
										O	L	L	S	R	L	S				R

06.82 A					****				1	10	D				09
06.82					====	SCENIC RD RD			1	10	D				09
06.57					==				1	10	D				09
06.50						PIPELINE XING			1	10	D				09
06.45					<---	NO BRIDGE			1	10	D				09
06.17					==				1	10	D				09
04.44						INDIAN ALLOTMENT	T2N R34E		1	10	D				09
01.98					XX	CLOSED			1	10	D				09
01.64					==				1	10	D				09
00.88					==				1	10	D				09
00.48									1	10	D				09
00.00 A					====	900 THORN HLLW RD			1	12	G				09

00.00						KANINE RD										
Mile Point	D	City Code	POP	Ave Day Trf	FED AID	X R E F	LEFT	CENTER	RIGHT	C O N D	L A N E S	Widths	Types	R/W	Urban	FN
												L S R	L S R			

30 P 3232 RD 900 AT RM 11.58 S 11 2N 34E HY 6 FRONTAGE MPF229.07 3232
 Co C Road# Begining Dir Sec Township Range Ending Road#

DATE: 02/28/95

OREGON DEPARTMENT OF TRANSPORTATION
 Roadway Analysis 503/378-6277

Mile Point	D u p e	City Code	POP	Ave Day Trf	FED AID	X R E F	LEFT	CENTER	RIGHT	C O N D	L A N E S	Widths	Types	R/W	Urban	FN
00.31								DDDD DEAD END BARRACKS			1 12	G				09
00.11							BIRCH CR)=(> 16 32 PONY T			1 12	G				09
00.00 A								==== 1301 BIRCH CR RD			1 12	G				09
00.00							TAYLOR LN									

02.02 A		****		2	14	U		09
02.02		==== 1394 ALKALI CAN RD		2	14	U		09
00.10		<--- FORD		2	14	U		09
00.00 A		==== 1396 WARNER RD		2	14	U		09

00.00 ROUMAGOUX RD

Mile Point	D u p e	City Code	POP	Ave Day Trf	FED AID	X R E F	LEFT	CENTER	RIGHT	Widths				Types	R/W	Urban	FN
										C	L						
										O	A	L	S				
										D	E	S	S	S	S		

30 P 3240 3317 AT RM 8.41

W 31 1N 30E DEAD END

ROAD NO: 3240

02.52 GRAIN FIELD AHD DDDD DEAD END 1 10 U 09

00.00 A ==== 3317 ALKALI CAN RD 1 10 U 09

00.00 SLUSHER CANYON RD

Mile Point	D	City Code	POP	Ave Day Trf	FED AID	X R E F	LEFT	CENTER	RIGHT	C O N D	L A N E	Widths	Types	R/W	Urban	FN
												L S R	L S R			
												S S S	S S S			

30 P 3240 3317 AT RM 8.41
Co C Road# Begining

W 31 1N 30E DEAD END
Dir Sec Township Range Ending

3240
Road#

DATE: 02/28/95

OREGON DEPARTMENT OF TRANSPORTATION
Roadway Analysis 503/378-6277

30 P 3241 RD 931 AT RM 0.87

SE 24

2N

33E

JCT PVT RD

ROAD NO: 3241

00.10		ST ANDREWS SCHOOL	**** PVT RD AHD	2	14	G	09
00.06		ST ANDREWS CHURCH		2	14	G	09
00.05			== 3242	2	14	G	09
00.00 A			==== 931 ST ANDREWS RD	2	14	G	09

00.00 (ST ANDREWS MISSION)

Mile Point	D u p e	City Code	POP	Ave Day Trf	FED AID	X R E F	LEFT	CENTER	RIGHT	C O N D	L A N E S	Widths	Types	R/W	Urban	FN	
											L S R	L S R					
											D E S	S S S					

30 P 3241 RD 931 AT RM 0.87
Co C Road# Begining

SE 24
Dir Sec

2N
Township

33E
Range

JCT PVT RD
Ending

3241
Road#

OREGON DEPARTMENT OF TRANSPORTATION
Roadway Analysis 503/378-6277

DATE: 02/28/95

00.04							DDDD DEAD END		2	14	G			09
00.00 A							==== 3241		2	14	G			09

00.00 (ST ANDREWS MISSION)

Mile Point	Du	City Code	POP	Ave Day Trf	FED AID	X R E F	LEFT	CENTER	RIGHT	C O N D	L A N E S	Widths L S R	Types L S R	R/W	Urban	FN
------------	----	-----------	-----	-------------	---------	---------	------	--------	-------	---------	-----------	--------------	-------------	-----	-------	----

30 P	3242	RD 3241 AT RM 0.05					NE	24	2N	33E	DEAD END					3242
Co C	Road#	Begining					Dir	Sec	Township	Range	Ending					Road#

DATE: 02/28/95

04.05		DEAD END AT FARM	DDDD		1	10	D								09
03.95			==		1	10	D								09
03.50			==		1	10	D								09
03.48			XX		1	10	D								09
01.43			XX		1	10	D								09
00.90			==		1	10	D								09
00.48			XX		1	10	D								09
00.45		DRY HOLLOW	-)(>		1	10	D								09
00.16			XX		1	10	D								09
00.00 A			====	1375 E BIRCH CR RD	1	10	D								09

00.00 PARKER ROAD																
Mile Point	D	City	POP	Ave	FED	X	LEFT	CENTER	RIGHT	C	L	Widths	Types	R/W	Urban	FN
	u	Code		Day	AID	R				O	A					
	e			Trf		E				N	N	L S R	L S R			
						F				D	E	S S S	S S S			

30 P 3246 RD 1062 AT RM 3.00

SE 19

1S

33E

DEAD END

ROAD NO: 3246

01.11							DDDD DEAD END		1	08	G		09
01.02							AXLE CANYON	-)(>	1	08	G		09
00.51								XX	1	08	G		09
00.18								XX	1	08	G		09
00.04							S STEWART CR	- >	1	08	G		09
00.00 A								==== 1062 STEWART CR RD	1	08	G		09
00.00													

Mile Point	D u p e	City Code	POP	Ave Day Trf	FED AID	X R E F	LEFT	CENTER	RIGHT	C O N D	L A N E S	Widths L S R	Types L S R	R/W	Urban	FN
------------	---------	-----------	-----	-------------	---------	---------	------	--------	-------	---------	-----------	--------------	-------------	-----	-------	----

30 P 3246 RD 1062 AT RM 3.00
Co C Road# Begining

SE 19
Dir Sec

1S 33E
Township Range

DEAD END
Ending

3246
Road#

OREGON DEPARTMENT OF TRANSPORTATION
Roadway Analysis 503/378-6277

DATE: 02/28/95

00.21 (GIBBON) DDDD DEAD ENDS 1 10 G 09

00.00 A ==== 900 RIVER RD 1 10 G 09

00.00 (GIBBON)

Mile Point	D u p e	City Code	POP	Ave Day Trf	FED AID	X R E F	LEFT	CENTER	RIGHT	C O N D	L A N E S	Widths L S R	Types L S R	R/W	Urban	FN
------------	---------	-----------	-----	-------------	---------	---------	------	--------	-------	---------	-----------	--------------	-------------	-----	-------	----

30 P 3247 RD 900 AT RM 20.91 W 31 3N 36E DEAD ENDS 3247
 Co C Road# Begining Dir Sec Township Range Ending Road#

DATE: 02/28/95

Mile Point	D	City	POP	Ave	FED	X	LEFT	CENTER	RIGHT	C	L	Widths	Types	R/W	Urban	FN
Point	u	Code		Day	AID	R				O	A	L S R	L S R			
e	p			Trf		E				N	N	S S	S S			
						F				D	E	S S	S S			
00.03	A								****			2 26	G			09
00.03									==== HY 341 UKIH-HLGRD HY			2 26	G			09
00.00	A						ECL UKIAH CITY BK					2 26	G			09
00.00							WELL ST(UKIAH)									

00.47 A					****					2	4	22	4	G	A	G	09
00.47					ORDNANCE DEPOT	XX	AHD			2	4	22	4	G	A	G	09
00.46						==				2	4	22	4	G	A	G	09
00.37					B UXING UP RY	UX	30			2	4	22	4	G	A	G	09
00.25						==	3251			2	4	22	4	G	A	G	09
00.24					END STATE JURIS		PUBLIC AHD			2	4	22	4	G	A	G	09
00.17 A						==	TO W BD I-84			2	4	22	4	G	A	G	09
00.17	0000	0				==	FROM W BD I-84			2	4	22	4	G	A	G	09
00.08	0000	0			B OXING HWY6 I-84	OX	36284 CONC			2	40			A			09
00.04 A						==	FROM E-BD I-84			2	40			A			09
00.04	0000	0				==	TO E-BD I-84			2	40			A			09
00.00 B	0000	0				==	PIGGERIES			2	28			G			09
00.00 A	0000	0				==	1335 ORDNANC FR RD			2	28			G			09

00.00 ORDNANCE RD																
Mile Point	D	City POP	Ave Day Trf	FED AID	X R E F	LEFT	CENTER	RIGHT	C O N D	L A N E S	Widths	Types	R/W	Urban	FN	
											L S R	L S R				

00.41	A					XXXX				2	20	G				09
00.41						==	TO WELL			2	20	G				09
00.11										2	20	G				09
00.03						==	3067			2	4 22 4	G A G				09
00.00	A					====	3250 ORDNANCE RD			2	4 22 4	G A G				09
00.00																

Mile Point	D	City	POP	Ave	FED	X	LEFT	CENTER	RIGHT	C	L	Widths	Types	R/W	Urban	FN
Code	u	Code		Day	AID	R				O	A					
e	p			Trf		E				N	N	L S R	L S R			
						F				D	E	S S S	S S S			

00.46							==			1	08	D		09
00.44			S ELY CR			< -	7			1	08	D		09
00.40			85 DEG TURN LT							1	08	D		09
00.09			S ELY CR			- >	6			1	08	D		09
00.00 A			(GURDANE)			====	1425 GURDANE			1	08	D		09

00.00

Mile Point	D	City POP	Ave Day Trf	FED AID	X REF	LEFT	CENTER	RIGHT	C O N D	L A N E	Widths	Types	R/W	Urban	FN
											L S R	L S R			

30 P 3253 RD 1425 AT RM 16.90 S 33 3S 30E JCT PVT RD 3253
 Co C Road# Begining Dir Sec Township Range Ending Road#

DATE: 02/28/95

OREGON DEPARTMENT OF TRANSPORTATION
 Roadway Analysis 503/378-6277

00.35							DDDD DEAD END		2	20	G		P	19
00.22							SHARP TURN LT		2	20	G		P	19
00.07							END CL RT		2	20	G		P	19
00.02							END CL LT	<FAU 3425 LOCATED	2	20	G		P	19
00.00 B				3425			== 1305 SW HAILEY AVE		2	20	G		P	17
00.00 A				3425		1305 BACK	SW 37TH AVE BK		2	20	G		P	17
00.00							SW 37TH AVE							

Mile Point	D u p e	City Code	POP	Ave Day Trf	FED AID	X R E F	LEFT	CENTER	RIGHT	C O N D	Widths				Types	R/W	Urban	FN
											L	N	S	R				

05.84 A	****		1	10	U	09
05.84	==== HWY 28 US 395		1	10	U	09
05.12	==		1	10	U	09
04.37	== CARNEY BUTTE		1	10	U	09
04.18	== 1411 LEG		1	10	U	09
04.14	== 1411 SPRING CAN RD		1	10	U	09
04.04	==		1	10	U	09
03.59	==		1	10	U	09
03.28	==		1	10	U	09
02.73	T3S R31E SEC 27-28	1/4 COR 730'S	1	10	U	09
02.28	<--- FORD		1	10	U	09
01.59	<--- FORD		1	10	U	09
01.57	====		1	10	U	09
01.55	SNIPER CR	<---	1	10	U	09
00.92	==		1	10	U	09
00.76	<--- FORD		1	10	U	09
00.00 A	UMATILLA NAT FOREST	NFD	1	10	U	09

Mile Point	D u p e	City Code	POP	Ave Day Trf	FED AID	X R E F	LEFT	CENTER	RIGHT	C O N D	L A N E	Widths L S R	Types L S R	R/W	Urban	FN
------------	---------	-----------	-----	-------------	---------	---------	------	--------	-------	---------	---------	--------------	-------------	-----	-------	----

00.51		SIGN KEEP OUT	*** PVT RD	1	10	D	09
00.11			CABIN	1	10	D	09
00.06		INDIAN RIDGE TRAIL	CAMP GND	1	10	D	09
00.03		B MILL CR)=(> 12 75	1	10	D	09
00.00 B			== NFD	1	10	D	09
00.00 A			== 582 MILL CR RD	1	10	D	09
00.00		TIGER CR RD					

Mile Point	D	City	POP	Ave	FED	X	LEFT	CENTER	RIGHT	C	L	Widths	Types	R/W	Urban	FN	
Code				Day	AID	R				O	A						
Trf				Trf		E				N	N	L	S	R	L	S	R
						F				D	E	S	S	S	S	S	

DATE: 02/28/95

02.93	A					XXXX				2	24	A			09
02.93						====	742-858 La Course Rd			2	24	A			09
01.91						====	732 WAMISHTA RD			2	24	A			09
00.90						====	736 CURL-HOMLY RD			2	24	A			09
00.50						<)<-				2	24	A			09
00.00	B					==	751 CAYUSE-TUBBS R		Crow Ford Hollow Rd	2	24	A			09
00.00	A						751 BACK			2	24	A			09
00.00							CAYUSE NORTH RD								

Mile Point	D u p e	City Code	POP	Ave Day Trf	FED AID	X R E F	LEFT	CENTER	RIGHT	C O N D	Widths				Types				R/W	Urban	FN
											L		R		L		R				
											S	S	S	S	S	S	S	S			

02.05	A		MORROW RD 3012 AHD	****					1	12	D			09
02.05			MORROW-UMATILLA	XX	COUNTY LINE				1	12	D			09
01.72				==	3272				1	12	D			09
01.65				==					1	12	D			09
01.41				==					1	12	D			09
00.24			80 DEG TURN LT						1	12	D			09
00.14			GURDANE CR	---	>				1	12	D			09
00.09				==	1425 LEG				1	12	D			09
00.00	A			==	1425 GURDANE RD BK				1	12	D			09

00.00																
Mile Point	D	City Code	POP	Ave Day Trf	FED AID	X R E F	LEFT	CENTER	RIGHT	C O N D	L A N E S	Widths	Types	R/W	Urban	FN
												L S R	L S R			

00.32	A		MORROW RD 852 AHD	****	GURDANE RD				1	12		U			09
00.32			MORROW-UMATILLA		CO LINE				1	12		U			09
00.00	A			====	3271				1	12		U			09
00.00															

Mile Point	D	City Code	POP	Ave Day Trf	FED AID	X R E F	LEFT	CENTER	RIGHT	C O N D	L A N E S	Widths	Types	R/W	Urban	FN
												L S R	L S R			

30 P 3272 JCT RD 3271 RM 1.72 W 06 4S 30E MORROW-UMATILLA CO LINE 3272
 Co C Road# Begining Dir Sec Township Range Ending Road#

DATE: 02/28/95

OREGON DEPARTMENT OF TRANSPORTATION
 Roadway Analysis 503/378-6277

05.95		GRANT CO LINE	**** GRANT RD 3407 AHD	2	16	G	08
05.80			< (-	2	16	G	08
05.28			==	2	16	G	08
04.94		S HUNTER CR	< -	2	16	G	08
04.50			< (-	2	16	G	08
04.06			< (-	2	16	G	08
03.62			==	2	16	G	08
03.61		S JERICO CR	< -	2	16	G	08
03.20			< (-	2	16	G	08
02.69			< (-	2	16	G	08
01.74		S DEERHORN CR	< -	2	16	G	08
01.72			==	2	16	G	08
00.69			< (-	2	16	G	08
00.00 A			==== HWY 28 US 395	2	16	G	08
00.00							

Mile Point	D u p e	City Code	POP	Ave Day Trf	FED AID	X R E F	LEFT	CENTER	RIGHT	C O N D	L A N E S	Widths	Types	R/W	Urban	FN
												L S R	L S R			

01.03	A						**** RD 1361 AHD			2	18		U		09
01.03							== 1388			2	18		U		08
00.48							<)(-			2	18		U		08
00.00	A						==== HWY 52 HEPPNER HY			2	18		U		08

00.00 MUD SPRING CANYON RD

Mile Point	D	City	POP	Ave	FED	X	LEFT	CENTER	RIGHT	C	L	Widths	Types	R/W	Urban	FN
u		Code		Day	AID	R				O	A	L S R	L S R			
p				Trf		E				N	N	S S	S S			
e						F				D	E	S S	S S			

00.15		PENDLETON CL		**** CITY AHD		2	18	G		09
00.01				<)(-		2	18	G		09
00.00 A				==== 983 LEE ST		2	18	G		09

00.00 NE ELLIS PL

Mile Point	D	City Code	POP	Ave Day Trf	FED AID	X R E F	LEFT	CENTER	RIGHT	C O N D	L A N E S	Widths	Types	R/W	Urban	FN
											L S R	L S R				

30 P 3278 RD 986 AT RM 0.56

N 06

2N

33E

DEAD END

ROAD NO: 3278

00.12 DDDD DEAD END 2 18 G P 19

00.00 A ==== 986 NE RIVERSDE AV 2 18 G P 19

00.00 NE 37TH ST

Mile Point	D u p e	City Code	POP	Ave Day Trf	FED AID	X R E F	LEFT	CENTER	RIGHT	C O N D	Widths			Types			R/W	Urban	FN
											L	N	S	L	S	R			

30 P 3278 RD 986 AT RM 0.56
Co C Road# Begining

N 06 2N 33E DEAD END
Dir Sec Township Range Ending

3278 Road#

OREGON DEPARTMENT OF TRANSPORTATION
Roadway Analysis 503/378-6277

DATE: 02/28/95

00.55							DDDD DEAD END			1	12	U		09
00.46							BN RY	++++		1	12	U		09
00.45							S	< -	9	1	12	U		09
00.43							OLD RR GRADE			1	12	U		09
00.33								==		1	12	U		09
00.32							B WILDHORSE CR	<)=(<	14 50 WOOD	1	12	U		09
00.29							OLD RR GRADE			1	12	U	P	19
00.25								==		1	12	U	P	19
00.21							END CL LT			1	12	U	P	19
00.14							PENDLETON CL		CITY BACK	1	12	U	P	19
00.09	0000	0					POWERLINE XING			1	12	U	P	19
00.03	0000	0					PENDLETON CL		CITY AHD	1	12	U	P	19
00.00 A								====	HWY 8 ORE-WASH HY	1	12	U	P	19

00.00							LINDELL LN									
Mile Point	D	City Code	POP	Ave Day Trf	FED AID	X R E F	LEFT	CENTER	RIGHT	C O N D	L A N E S	Widths	Types	R/W	Urban	FN
												L S R L S R				

DATE: 02/28/95

00.53 DDDD DEAD END MCKAY DAM 2 14 G 09

00.00 A ==== HWY 28 US 395 2 14 G 09

00.00 (MCKAY DAM)

Mile Point	Du	City Code	POP	Ave Day Trf	FED AID	X REF	LEFT	CENTER	RIGHT	C O N D	L A N E S	Widths	Types	R/W	Urban	FN
												L S R	L S R			
												S S S	S S S			

00.70 A		**** PVT RD AHD	1	12	U	09
00.70		==	1	12	U	09
00.05		---> FORD	1	12	U	09
00.02		==	1	12	U	09
00.00 B		== 1363 ALKALI CAN RD{	1	12	U	09
00.00 A		1394 BACK	1	12	U	09

Mile Point	Dupe	City Code	POP	Ave Day Trf	FED AID	XREF	LEFT	CENTER	RIGHT	CORNERS	L	Widths	Types	R/W	Urban	FN
										D	A	L S R	L S R			
											E	S S	S S			

00.95	A							**** PVT RD AHD		2	18	U			09
00.95								==		2	18	U			09
00.00	A							==== HWY 28 ORE 395		2	18	U			09

00.00

Mile Point	D u p e	City Code	POP	Ave Day Trf	FED AID	X R E F	LEFT	CENTER	RIGHT	Widths		Types		R/W	Urban	FN
										L	R	L	R			

30 P 3289 JCT HWY 28 AT MP 29.48 W 24 2S 30 1/2E PVT RDS 3289
 Co C Road# Begining Dir Sec Township Range Ending Road#

DATE: 02/28/95

00.43	A						****				1	10	G		09
00.43							STAGE GULCH	---	> FORD		1	10	G		09
00.00	A						(THORN HOLLOW)	==	900 BINGHAM RD		1	10	G		09
00.00							BUCKAROO LN								

Mile Point	D	City	POP	Ave Day Trf	FED AID	X R E F	LEFT	CENTER	RIGHT	C O N D	L A N E S	Widths	Types	R/W	Urban	FN
		Code										L S R	L S R			

00.65	A						****			1	08	U		09
00.65							XX			1	08	U		09
00.33										1	08	U		09
00.00	A						==== 1050 SHAW-LWR MCKAY			1	08	D		09
00.00														

Mile Point	D u p e	City Code	POP	Ave Day Trf	FED AID	X R E F	LEFT	CENTER	RIGHT	Widths			Types			R/W	Urban	FN
										C	L		L	S	R			
										O	A	N	N	L	S			

00.25		BARRICADE	***	2	16	G	09
00.12			== MEACHM LK 2MI	2	16	G	09
00.06			== 3295 3RD ST	2	16	G	09
00.00 A			==== HWY 6 FR EMIGRNT HL	2	16	G	09

00.00 ROSS ROAD (MEACHAM)

Mile Point	D u p e	City Code	POP	Ave Day Trf	FED AID	X R E F	LEFT	CENTER	RIGHT	Widths			Types			R/W	Urban	FN
										C O N D	L A N E S	L S R	T y p e s	L S R				

00.13	A									****	2	14	G			09
00.13										==== HWY 6 FR EMIGRANT HL	2	14	G			09
00.00	A									==== 3294 ROSS RD	2	14	G			09

00.00 3RD STREET(MEACHAM)

Mile Point	D u p e	City Code	POP	Ave Day Trf	FED AID	X R E F	LEFT	CENTER	RIGHT	Widths						Types	R/W	Urban	FN
										C O N D		L N S		S R S					
										L	A	N	S	L	S				

30 P 3296 RD 1426 RM 0.82

NW 27

4S

31E

RD 1428 RN 10.79

ROAD NO: 3296

00.70 ===== 1428 GURDAN-ALBEE 1 10 D 09

00.00 A 1426 LOG SPRING BK 1 10 D 09

00.00 LOG SPRING RD

Mile Point	D u p e	City Code	POP	Ave Day Trf	FED AID	X R E F	LEFT	CENTER	RIGHT	C O N D	L A N E	Widths	Types	R/W	Urban	FN
												L S R	L S R			
												D E S	S S S			

30 P 3296 RD 1426 RM 0.82
Co C Road# Beginning

NW 27
Dir Sec

4S 31E
Township Range

RD 1428 RN 10.79
Ending

3296
Road#

DATE: 02/28/95

OREGON DEPARTMENT OF TRANSPORTATION
Roadway Analysis 503/378-6277

Have no information that this rd is public so Co. Rd

00.35							DDDD DEAD END			1	08	U		09
00.05							==			1	08	U		09
00.03						UP RY	++++			1	08	U		09
00.00 A							==== 1275 UMATILLA RV RD			1	08	U		09
00.00						BONNEY LN								

Mile Point	D	City	POP	Ave Day Trf	FED AID	X R E F	LEFT	CENTER	RIGHT	C O N D	L A N E S	Widths	Types	R/W	Urban	FN
												L S R	L S R			

490

00.35 A ***** 1 10 D H 19
 00.35 ===== 1219 NE 10TH ST 1 10 D H 19
 00.00 A == 1244 E THEATR LN 1 10 D H 19

00.00
 Mile D City POP Ave FED X LEFT CENTER RIGHT C L Widths Types R/W Urban FN
 Point u Code Day AID R E
 p Trf F
 e

30 P 3308 JCT RD 1244-RM 1.24 NE 02 4N 28E JCT RD 1219-RM 2.36 3308
 Co C Road# Begining Dir Sec Township Range Ending Road#

DATE: 02/28/95

01.03	A						***				1	08	U		09
01.03							====	HY 333 DIAGONAL RD			1	08	U		09
00.90								PIPELINE XING			1	08	U		09
00.78								POWERLINE XING			1	08	U		09
00.00	A						====	1250 W PUMPKN CTR R			1	08	U		09

Mile Point	D	City POP	Ave Day Trf	FED AID	X R E F	LEFT	CENTER	RIGHT	C O N D	L A N E S	Widths	Types	R/W	Urban	FN
	u p e	Code									L S R	L S R			

30 P 3309 RD 1250 AT RM 2.69 S 01 4N 28E JCT HWY 333 MP 5.34 3309
 Co C Road# Begining Dir Sec Township Range Ending Road#

DATE: 02/28/95

00.26	A						****			2	20	0		H	19
00.26							====	1245 HERMSTN-HINKLE		2	20	0		H	19
00.00	B						==	1193 SE 4TH ST		2	20	0		H	19
00.00	A							CHRISTIANSEN LP BK		2	20	0		H	19
00.00								SE 4TH EXT							

Mile Point	D u p e	City Code	PDP	Ave Day Trf	FED AID	X R E F	LEFT	CENTER	RIGHT	Widths				Types		R/W	Urban	FN
										C	L							
										O	A	N	L	S	R			
										D	E	S	S	S	S			

30 P 3310 RD 1193-RM 0.39
Co C Road# Begining

W 14 4N 28E RD 1245-RM 0.50
Dir Sec Township Range Ending

3310 Road#

DATE: 02/28/95

00.13							DDDD DEAD END			2	14	G		09
00.07							90 DEG TURN LT			2	14	G		09
00.00 A							==== HY 320 LNGTN-ECHO HY			2	14	G		09
00.00														

Mile Point	D	City	POP	Ave	FED	X	LEFT	CENTER	RIGHT	C	L	Widths	Types	R/W	Urban	FN
u		Code		Day	AID	R				O	A					
p				Trf		E				N	N	L S R	L S R			
e						F				D	E	S S S	S S S			

30 P 331 RD 1350 RM 4.45 SE 29 2N 30E RD 1394 RM 2.36 ROAD NO: 3317

09.19 B		****								2	18	G				09
09.19 A		==	1394							2	18	G				09
09.19		==	3288							2	18	G				09
08.41		==	3240	SLUSHER CAN RD						2	18	G				09
08.36				SLUSHER CANYON	-)	(2	18	G				09
06.96		==								2	18	G				09
05.97					<)	(-				2	18	G				09
05.71					<)	(-				2	18	G				09
05.50					<)	(-				2	18	G				09
05.43					-)	(2	18	G				09
04.84					-)	(2	18	G				09
04.76					<)	(-				2	18	G				09
04.55		==								2	18	G				09
04.48				ALKALI CANYON	-)	(2	18	G				09
04.41		==								2	18	G				09
04.34					-)	(2	18	G				09
04.22					<)	(-				2	18	G				09
03.53					-)	(2	18	G				09
03.17 A		==	3153							2	18	G				09
03.17		==	PVT							2	18	G				09
02.08		==								2	18	G				09
00.00 A		====	1350	TWO CANYON RD						2	18	G				09

Mile Point	D	City Code	POP	Ave Day Trf	FED AID	X R E F	LEFT	CENTER	RIGHT	C O N D	L A N E S	Widths	Types	R/W	Urban	FN
												L S R	L S R			

30 P 3317 RD 1350 RM 4.45 SE 29 2N 30E RD 1394 RM 2.36 3317
 Co C Road# Begining Dir Sec Township Range Ending Road#

C

O

C

C

O

C

