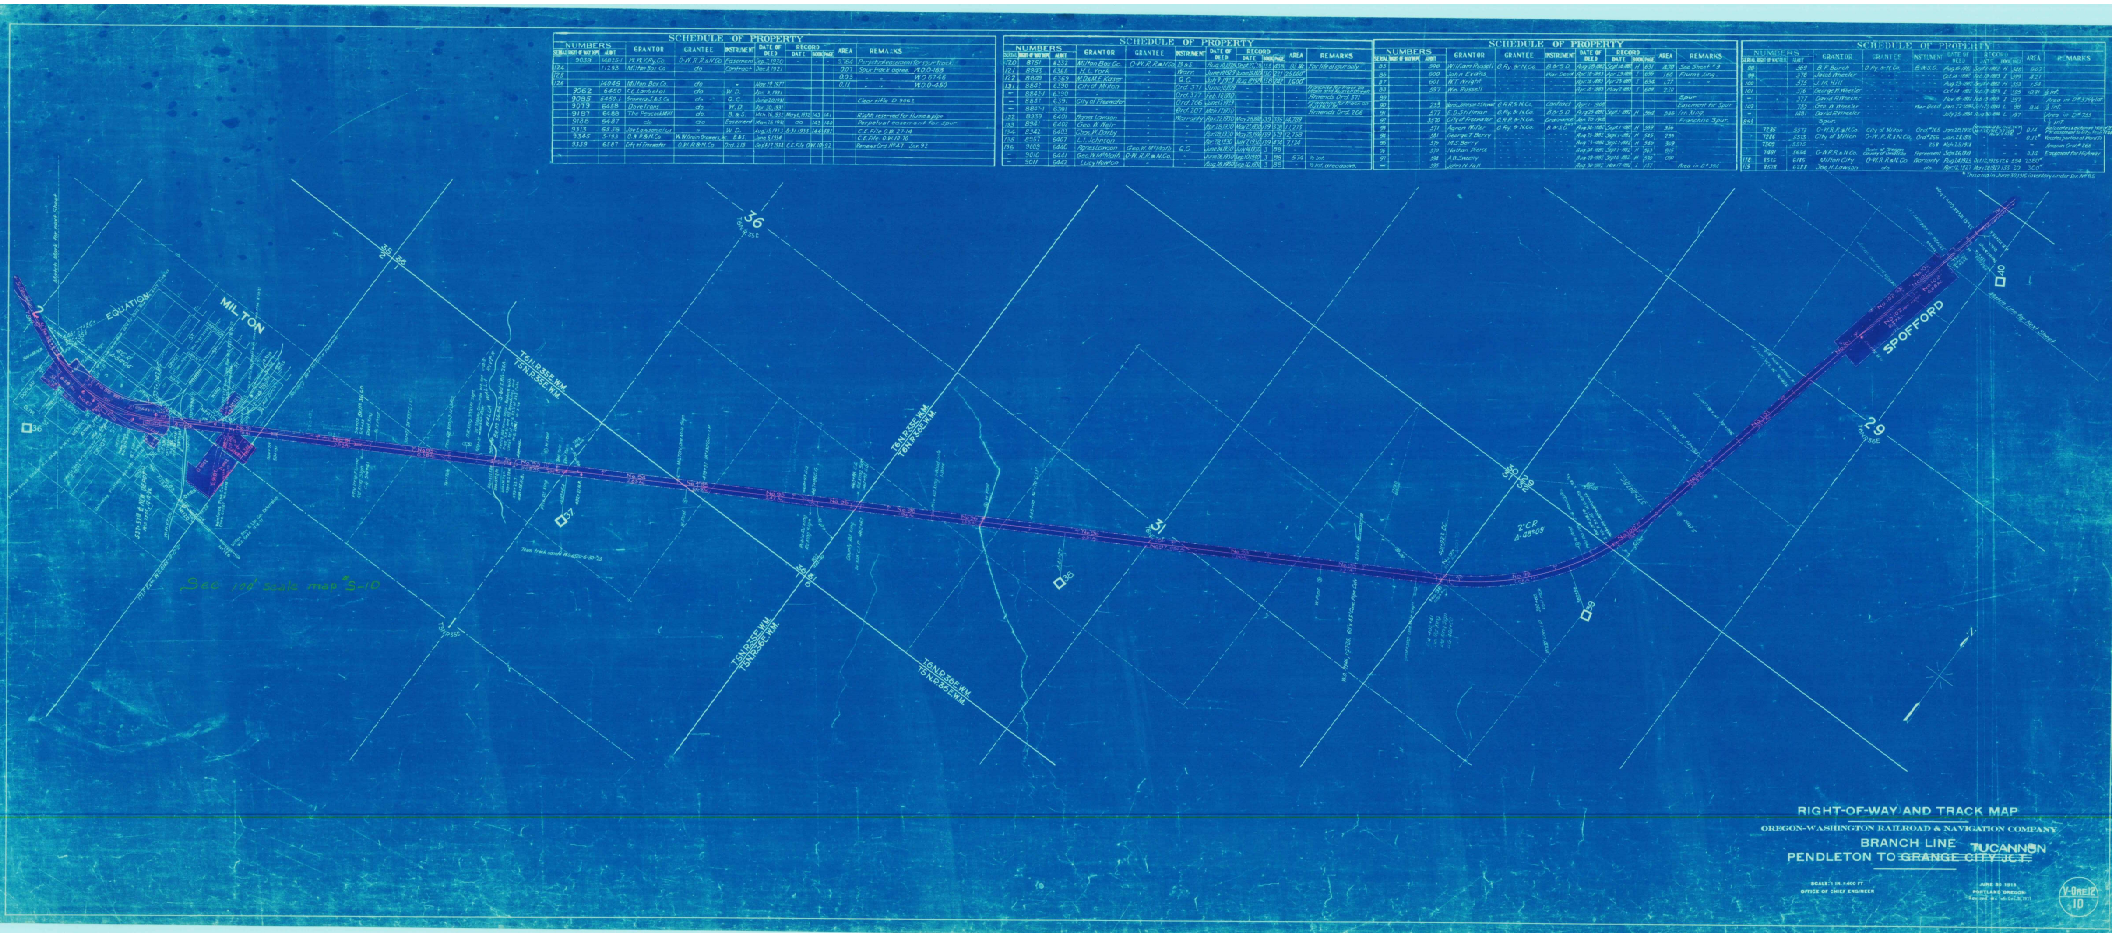
SCHEDULE OF PROPERTY
SCHEDULE OF PROPERTY
SCHEDULE OF PROPERTY
SCHEDULE OF PROPERTY
MILTON
SPOFFORD
EQUATION
RIGHT-OF-WAY AND TRACK MAP
OREGON-WASHINGTON RAILROAD & NAVIGATION COMPANY
BRANCH LINE TUCANNON
PENDLETON TO GRANGE CITY JCT.
SCALE: 1 IN. = 400 FT.
OFFICE OF CHIEF ENGINEER
JUNE 30 1915
PORTLAND OREGON
Y-ONE12
10