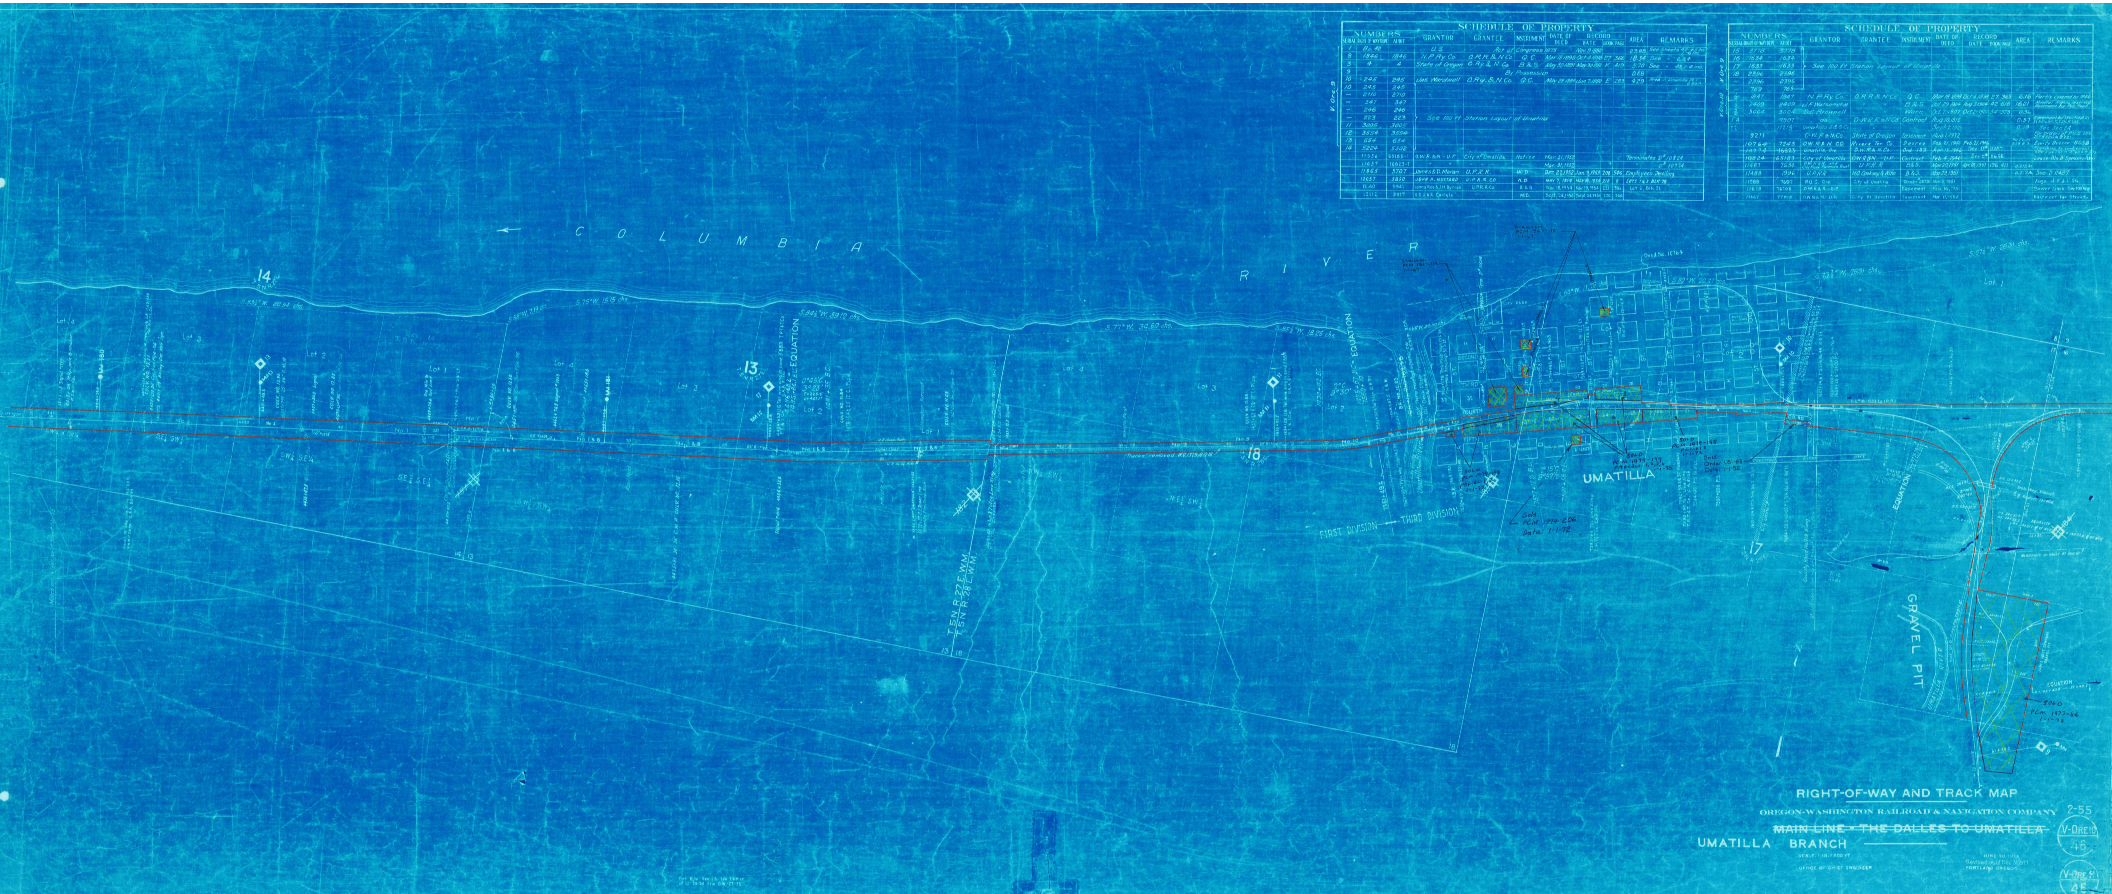
SCHEDULE OF PROPERTY
SCHEDULE OF PROPERTY
COLUMBIA
RIVER
UMATILLA
GRAVEL PIT
FIRST DIVISION — THIRD DIVISION
RIGHT-OF-WAY AND TRACK MAP
OREGON-WASHINGTON RAILROAD & NAVIGATION COMPANY
MAIN LINE - THE DALLES TO UMATILLA
UMATILLA BRANCH