

N.P.R.

Main Line, Walla Walla to Milton

Right of Way Plat

State of Oregon

County of Umatilla

NE⁴ of Section 2

Township 5 North

Range 35 East

of Willamette

Meridian NOV 1 1960


Track owned 100% by WWV Ry. See Cor-March 11, 1961 letter

Scale 200 ft. 1 Inch

SECTION 35, TWP. 6 N. RGE. 35E.

SECTION 2, TWP. 5 N. RGE. 35E.

Note: Boundary of Right of Way denoted thus

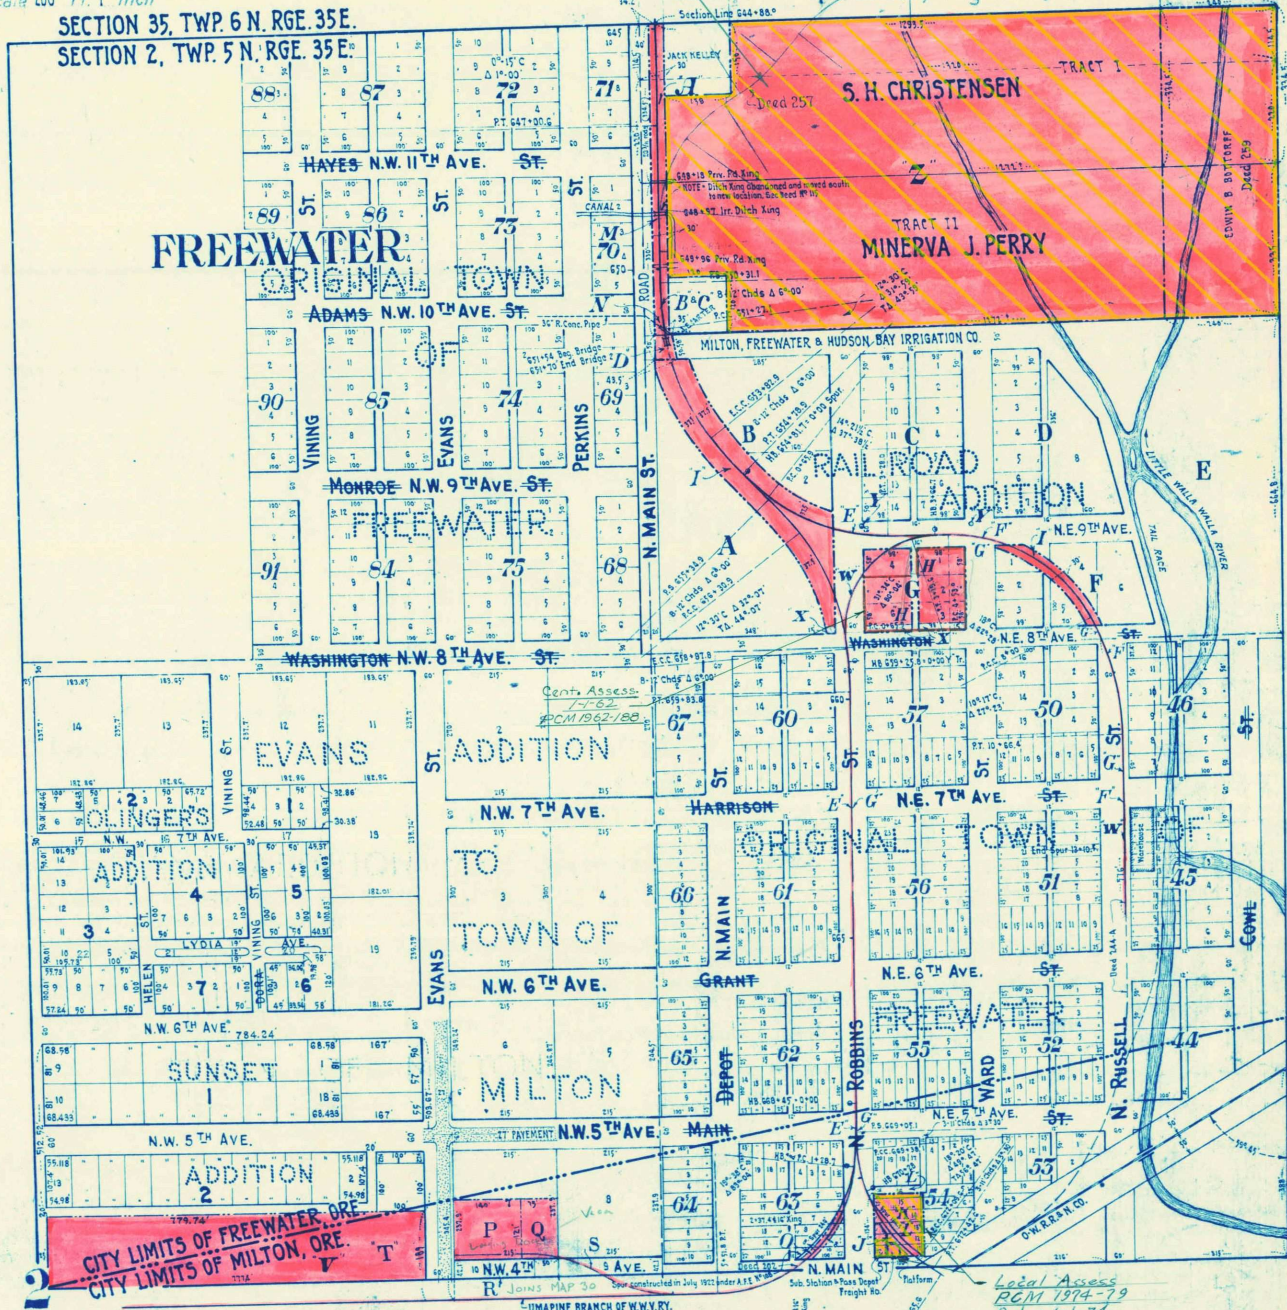

Deed No.	Grantor	Grantee	Title	Acres	Date	When and Where recorded	Brief Description	Cor File # & Memo
A 75	Samuel H. Christensen & wf.	Walla Walla Valley Traction Co.	War. Deed.		Oct. 15, 1906	Oct. 22, 1906, Bk. 52 Deeds. P. 139.	30' strip off West side of S.H. Christensen Tract.	
B 76	Minerva J. Perry	do.	do.		Oct. 30, 1906	Nov. 1, 1906, Bk. 52 Deeds. P. 178	30' strip off West side of Minerva J. Perry Tract.	
C 76 B	Fountain Perry	do.	Q.C. Deed.		Nov. 10, 1906	Nov. 24, 1906, Bk. 52 Deeds. P. 314	do. do. do.	
D 77	The Milton, Freewater and Hudson Bay Irrigation Company	do.	do.		Jan. 16, 1907	March 2, 1907, Bk. 52, Deeds. P. 572	Irrig. Tract across 50' strip in NE ⁴ of NE ⁴ of Section 2.	
E 78	City of Freewater	do.	Ordinance No 40		Dec. 3, 1906	Records of City Recorder	Right to construct & operate electric railway on Robbins St. and power lines in city Street or alley in Freewater for a term of 25 yrs.	
F 78 A	do.	do.	Ordinance No 49		Oct. 7, 1908	do.	Right to construct and operate electric railway across Ward and Washington Sts and in Russell St.	
G 78 B	do.	Walla Walla Valley Ry. Co.	Ordinance No 68		Aug. 23, 1910	do.	Right to construct & operate electric railway along Robbins and Russell Streets and across Ward & Washington Sts for a term of 50 years.	
H 79	Otto B. Frank	Northwestern Corporation	War. Deed.		April 22, 1910	April 25, 1910, Bk. 59 Deeds. P. 154	All of Block G, Railroad Add	
I 79 A	Otto B. Frank	Walla Walla Valley Traction Co.	Dedication		May 7, 1907	May 10, 1907, Bk. 2 of Plats. P. 74	1/2 W. as shown is reserved on recorded plat and right to cross streets and alleys in Railroad Add.	
J 81	E. S. Isaacs, Trustee	do.	War. Deed.		Oct. 6, 1906	Oct. 27, 1906, Bk. 52 Deeds. P. 136.	Lots 11, 12, 13, 14, 15 & 16, Block 54, Town of Freewater.	
K 82	Columbia Power & Light Co.	Walla Walla Valley Ry. Co.	B & S. Deed.		July 1, 1910	Aug. 3, 1910, Bk. 68 Deeds. P. 276	Lots 11, 12, 13, 14, 15 & 16, Block 54, Town of Freewater, also Sub Station and Depot including equipment.	
L 83	Walla Walla Valley Ry. Co.	The Public	Dedication		May 29, 1913.	Aug. 1, 1913, Bk. 85 Deeds. P. 160.	Dedicate to public the N 1/2 of Lot 16, Bk 54 in exchange for vacation of alley in the rear of Lots 11 to 16 Inc.	
M 114	do.	Powell Ditch Co.	Permit		Jan. 14, 1914	Cancelled. See Deed 115	Irrig. Ditch Xing in N ⁴ of NE ⁴ of Section 2.	

Note for Continuation of Deed Record, See Sheet No 29 A