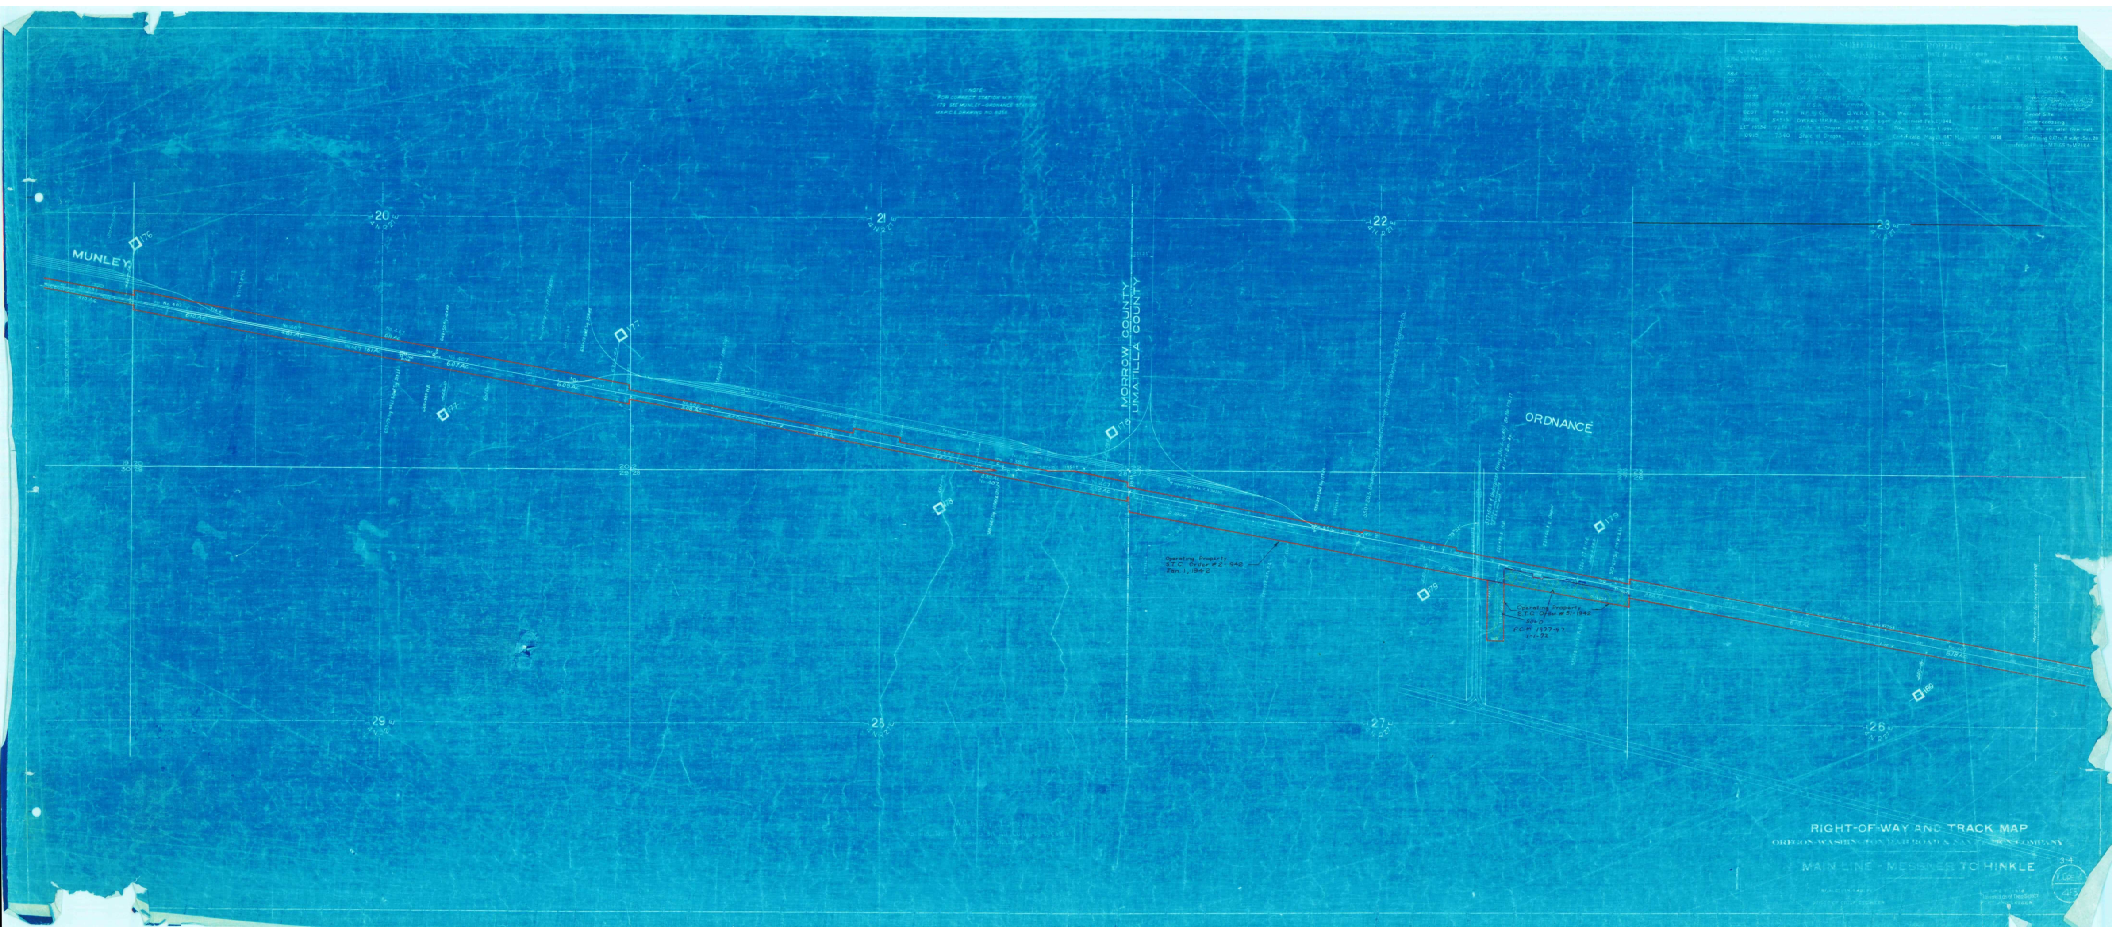
MUNLEY
MORROW COUNTY
UMATILLA COUNTY
ORDNANCE
RIGHT-OF-WAY AND TRACK MAP
MAIN LINE - MESSNER TO HINKLE